

KANSAS


FORM 51 5M PETROL

Greenwood

Section 33 Township 23 Range 13-E

Well No. #1 Pegean (*Peagram*)

Company Chas. Cross

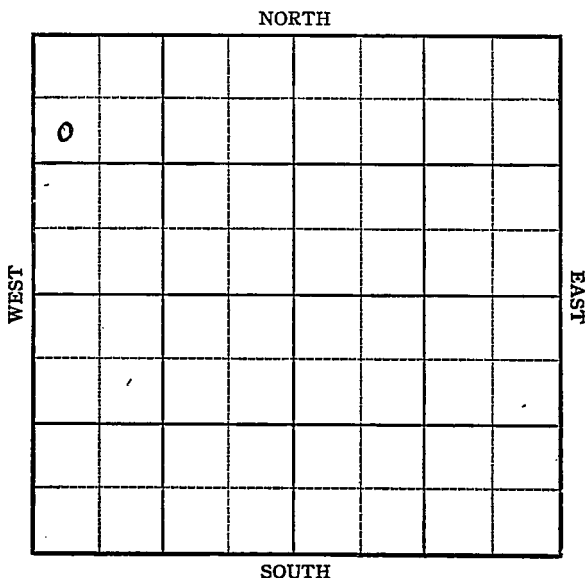


KANSAS

Greenwood

Sec. 33 Twp. 23 R. 13-E
Well No. #1 Pegean Farm
Chas. Cross Company

NORTH

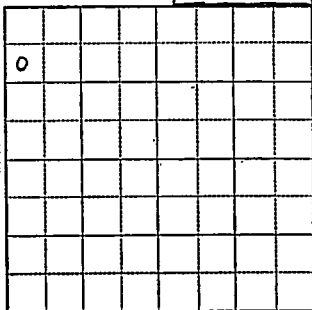

SOUTH

990 Ft. from N. Line

 Ft. from S. Line

 Ft. from E. Line

330 Ft. from W. Line

1943

R E P O R T

9/22, Spud
9/29 S.D. 367'
10/6 10" @ 367' 11/
Drlg. 555'
10/13 8" @ 850'
10/20 Drlg. 2600'
10/27 8" @ 920'
Drlg. 1230'
11/3 6" @ 1248'
Drlg. 1605'
11/10 Miss 1610
5" @ 1610'
T.D. 1623-1500' fluid 50% Water.
11/17 T.D. 1625
5" @ 1617
WOC.
12-1 5" @ 1617
Miss 1610
TD 1625
1000 Acid
Pump 225, Pot
Gravity 36.4


COMPLETED

KANSAS

Map No. 17 Sec. 33 Twp. 23 R. 13EWell No. 1 PeganChas. Cross CompanyFIRST REPORT Contractor

SW NW NW

SECTION PLAT

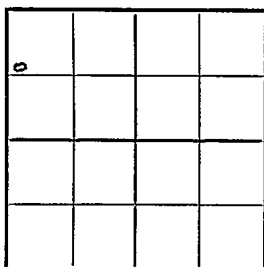990 Ft. from N. Line Ft. from S. Line Ft. from E. Line330 Ft. from W. LineMiscellaneousLocation Rig up

Drilling and Remarks:

Spud

RECORD

Cased in., ft.Sand Gas Oil Total Depth

PRODUCTION

1st 24 hrs. Nat. 1st 24 hrs. after shot Gas Cu. Ft.Dry Hole Abandoned

Date

SEP 22 1943 19S. J. LEWIS Scout

KANSAS

Map No. 17 Sec. 33 Twp. 23 R. 13 EWell No. 1 Pegan

Chas. Cross

Company

COMPLETED

Contractor

SW NW NW

SECTION PLAT

o			

990 Ft. from N. Line Ft. from S. Line Ft. from E. Line330 Ft. from W. Line

Miscellaneous

Location Rig up

Drilling and Remarks:

*Miss 1610**5" @ 1617**1000 acid**Pump 25 Pst**36 1/2 hr*

RECORD

Cased in., ft.Sand Gas Oil Total Depth 1625

PRODUCTION

1st 24 hrs. Nat. 1st 24 hrs. after shot Gas Cu. Ft.Dry Hole Abandoned

Date

DEC 1 1943 19

S. J. LEWIS Scout