


Section 1 Township 23 Range 13-E

Well No. #1 Schreileber "A"

Company Payrock Oil

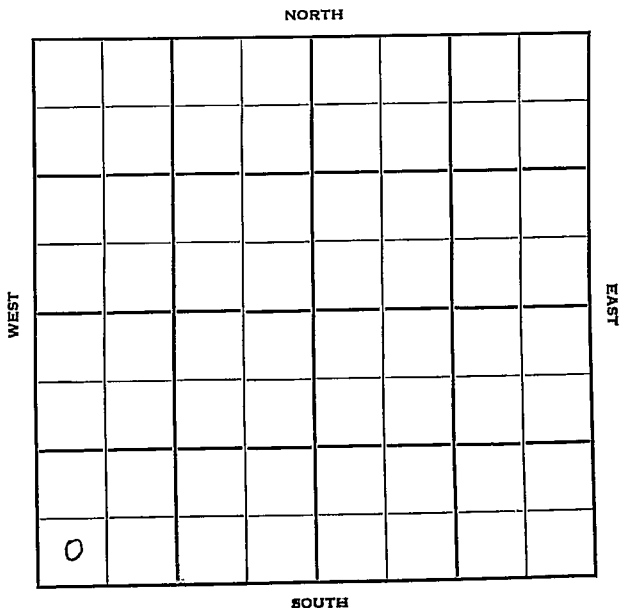

Coffey KANSAS

Sec. 1 Twp. 23 R. 13E ✓

Well No. #1 Schreileber "A" Farm

Payrock Oil

Company

Newland - Contr.

Contractor

Ft. from N. Line

330'


Ft. from S. Line

Ft. from E. Line

330'

Ft. from W. Line

SW SW SW

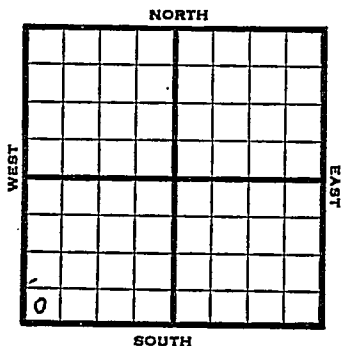

1950

?

REPORT

10/11

Spud 10-7-50

Drlg. 575'

12/20

10" @ 500

8" @ 1100

Miss 1738

5" @ 1763

TD 1769

2000 A

P/2 bopd

200 A

Comp 2 bopd

Completed

COMPLETED

J. E. TYRA

County Coffey State Kansas
 Sec. 1 (Blk.) 23 (Sur.) 13E Map No.

Operator Payrock Oil

Well No. 1 Farm Schreileber "A" Schoenlebe

Elev. Location SW SW SW

0							

330 Ft. From S Line SW

330 Ft. From W Line Quarter

Ist. Report

Completion DEC 20 1950

Remarks

Newland - Contr.

Spudding Date 10-7-50

Drlg. Data Oil well TD 1769

10" @ 500 8" @ 1100 Miss. 1738

5" @ 1763 TD 1769 2000 A P/ 2 bopd

200 A Comp. 2 bopd

J. E. TYRA