343

STATE Kansas

COUNTY Graham

BLOCK

SEC. 33

T. 9S R. 21W

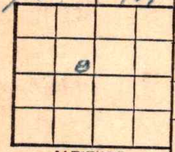

ALTITUDE 2302

PRODUCTION D&A

COMPANY Derby

FARM Cox WELL NO. 1

SURVEY

4018
TOTAL DEPTH

COMMENCED

COMPLETED

REMARKS SE-SE-NW

CASING RECORD

LS 3498
Sooy 3806
A 3884

SHOT QUARTS BETWEEN

FORM 186 - In stock and for sale by Mid-West Prtg. Co., Tulsa

100

200

300

400

500

600

700

800

900

1000

1100

1200

1300

1400

1500

1600

1700

1800

1900

2000

2100

2200

2300

2400

2500

2600

2700

2800

2900

Scout Lansing & Sooy
tops off!

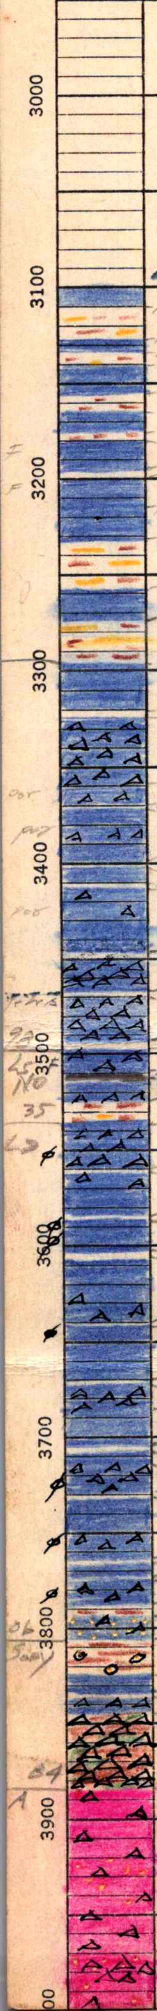

Samples start 3100'

-10 gray, f. Xln. fossilif. lst.
Red & gray, sandy sh.
-18
-23 cream, f. Xln. lst.
-40 Red & gray sandy sh.
cream to gray, f. Xln. fossilif. lst.
-55
-65 same
-75
-80 cream, f. Xln. fusulinidal lst.
-96
same
-15 cream to gray, f. Xln. fusulinidal lst
-32 Red & gray, sandy sh.
-58 cream to gray, f. Xln. lst.
-75
Red & gray sandy sh.

Topeka 3297

-97 cream, f. Xln. fossilif. lst.
to gray
-20
-23 cream to gray, f. Xln. cherty fossilif. lst.
-60 same but with slight pin-point por.
-70
-71 cream to gray, dse. to f. Xln. lst.
cherty & sli. por. in part.
-00
-04 gray, f. Xln. fossilif. lst.
-10
-12 cream, dse. to f. Xln. fusulinidal lst
scattered pin-point porosity
-44
-50 cream, f. Xln. cherty lst. wh. chert
-68
-70 cream to gray mottled pseudo-ool. lst. gray & brn. fusulinidal chert
-95
-98 cream, chalky to finely granular cherty, fusulinidal lst.
-10 blk. sh.
-13 gray, dse. to f. Xln. lst., cherty & fusulinidal in part
-23 Red & gray, sandy sh.

Lansing 3535

-35 wh. to cream, dse. to f. Xln. cherty lst.
-60 faintly oolitic in part
-61 wh. to cream, dse. to f. Xln. lst.
cherty in part
-83
-86 cream, f. Xln. sl. por., ooc. lst. scattered dead oil staining
-03
-07 cream, dse. to f. Xln. lst.
cherty in part.
-40
-41 cream, f. Xln. lst. scattered ooc. por
-50 wh. dse. to f. Xln. lst.
-70
-71 cream, dse. to f. Xln. cherty lst.
-85 cream, f. Xln. fossilif. lst. fusulinids
-03
-05 cream, dse. to f. Xln. lst.
-15 cream, dse. cherty lst. faintly
-30 oolitic in part
-32 cream, dse. lst.
-50 cream, cherty f. Xln. faintly ool. lst.
-65
-66 cream, dse. to f. Xln. lst.
-74 cream, f. Xln. sl. por. & ooc. cherty lst.
-88
-94 cream, f. Xln. finely arenaceous lst.
-06 traces of salmon-pink chert

False Congl. 3806

variegated sh., cong., grit.
-25 wh. to cream, dse. to f. Xln. lst.
-34
-36 cream f. Xln. lst. & salmon-pink chert
-44

Penn. Basal Congl. 3844

variegated sh. & varicolored chert.

Arbuckle 3884

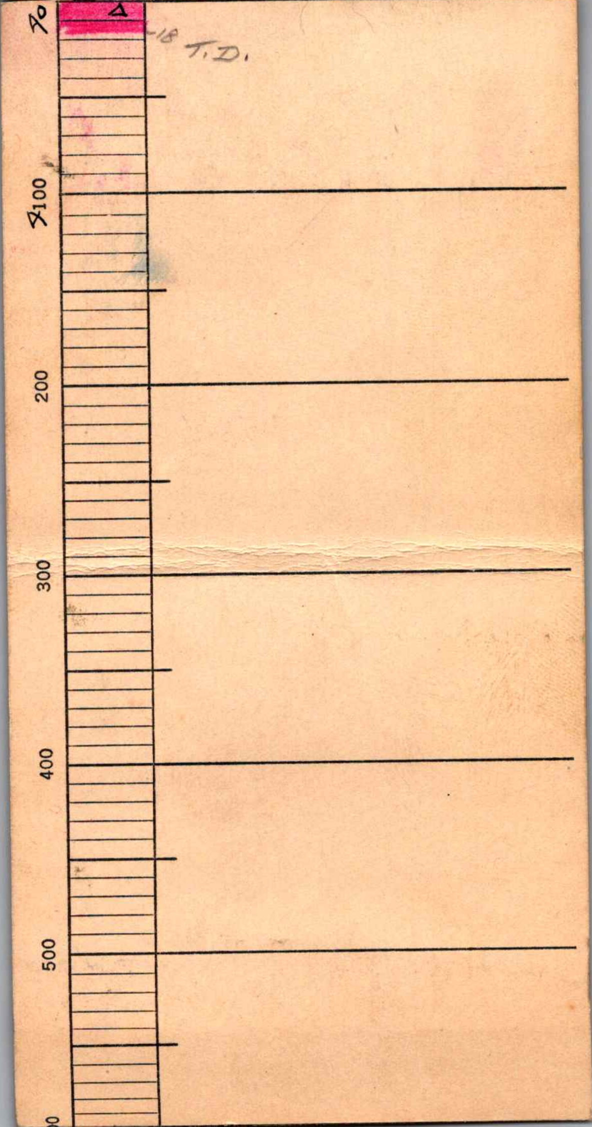-84 gray, co. Xln. cherty dolo.
scattered vuggy porosity
& spots dead oil staining
at top
-26
gray to buff, co. Xln. to rhombic
slightly sandy dol. oolitic chert
scattered vuggy porosity
-70
gray to buff, f. to co. Xln. dolo. sandy
in part. oolitic chert