


Contr. Holm Drlg. Co.			
STATE Kansas		FIELD	
COUNTY Finney		COMPANY Atlantic Refining	
SEC. 33	WELL NO. 1	FARM Wright	
T. 21	R. 34 W	DATE COM. 5-5-45	DATE COMPL. 7-26-45
		FOOTAGE LOC. SE NW NW	
		SHOT QUARTS	
		ACID GALS.	
ALT.		CASING 10-3/4" 286' Cem. 5-1/2" 4628' Cem.	
INIT'L. PROD. 9,115,000 cu.ft.		REMARKS 4" liner Top 2609 Bot- tom 4753	
T.D. 4915 PB 2688			

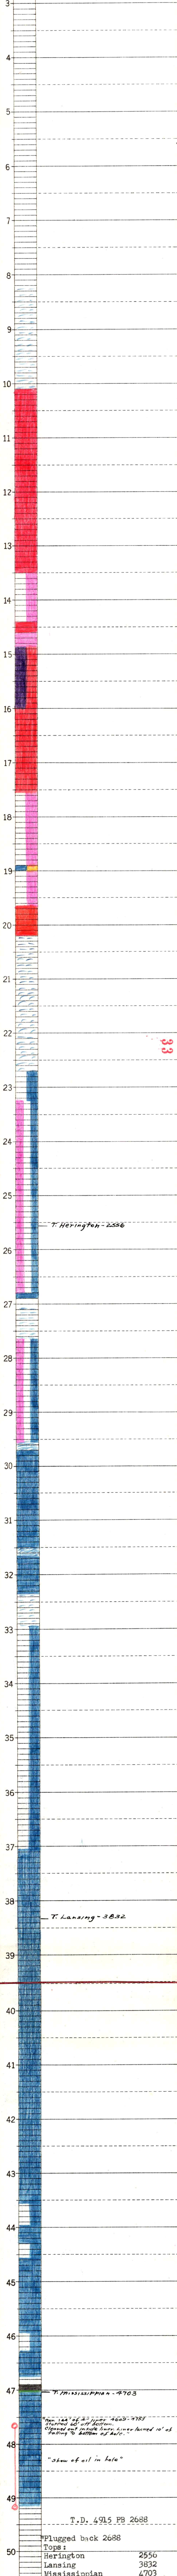

"DST 2528-2765 Open 1 hr & 40 mins.
Started blowing air immediately &
at end of one hr showed gas. Good
strong blow of gas (would burn) to
end of test.
Pulled drill pipe. Rec. 200' muddy
salt wtr & 220' drilling mud.

Cored: 4607-4621 Rec. 9'. 3'9" hrd
gy crystalline sdy lime, w/pin
points of oil.
1' dark green shale 3" drk crys-
talline cherty lime
1' hrd. brown dense fossiliferous
lime. 6" dark green shale.
1' dark brown crystalline cherty
lime. 6" hard lgt brown dense lime.
1' dark green shale, middle 3" fos-
siliferous lime.

Spotted por from 4888-4915, no sat-
uration.
Shot formation w/24 holes 4888-4915,
no show.
Plugged back to 4753
Perf. csg w/57 holes 4733-4743.

Acidized thru perf 4733-4743 w/2000
gals.
Bailed 3 gals wtr & 1 qt. of oil
per hr.

Plugged back to 2688 w/mud, dumped
two sax cem. on top of sand & mud.

Perf. 2629-2632 w/23 holes. Rec. 100'
of mud & some gas.

Squeezed w/300 sax cem.
Pressure 475# after 225 sax.
Staged the rest & finished w/900#
pressure.

Perf. 2598-2620 w/112 holes.
Rec. mud & water.
Did not have cem. job.

Cem. perf. from 2598-2620 w/500 sax.
Pressure started at 1500#, broke down
to 100#, finished w/no pressure.
Tested after 24 hrs w/2000# no input.

Perf 2618-2600 w/18 holes. Bailed 4
to 5 bbls fresh wtr per hr
Acidized w/1000 gals.
Tested 1,660,000 cu. ft. gas.

Re-acidized w/4000 gals.
Tested 3,180,000 cu. ft. gas

~~2537-2562~~ *
Set bridge plug @ 2590, spotted
calseal on top.
Perf 2537-2562 w/94 holes. Show of
gas.
Acidized w/1000 gals, press. 1000#.
Good show of gas.
Treated w/6000 gals acid.

State Pot. 9,115,000 cu. ft.

Gas Producing Zones:
2537-2562
2600-2618 "


