


Map No. _____ Sec. 29 Twp. 23 R. 24
 Well No. 3 Ferris Farm _____
Ohio Cities Gas Company

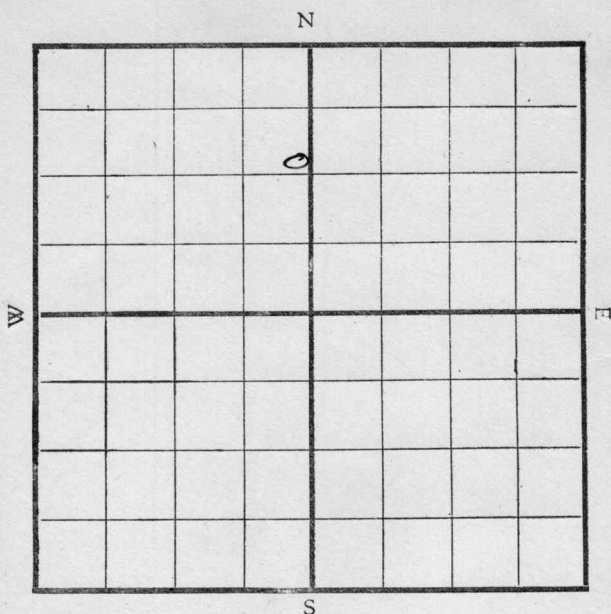

Location _____

Drilling Remarks:

Rig Up _____

Drilling Remarks:

COMPLETED

RECORD

Cased _____ in. _____ ft.

Sand _____

Gas _____

Oil _____

Total Depth _____

PRODUCTION

1st 24 hrs. Nat. _____

1st 24 hrs. after shot _____

Gas _____ cu. ft.

Dry Hole _____

Abandoned _____

Map No. _____ Sec. 29 Twp. 23 R. 4


Well No. 3. Ferrier Farm
Ohio Cities Gas Co Company

1120 Ft. from N. Line

_____ Ft. from S. Line

200 Ft. from E. Line

_____ Ft. from W. Line

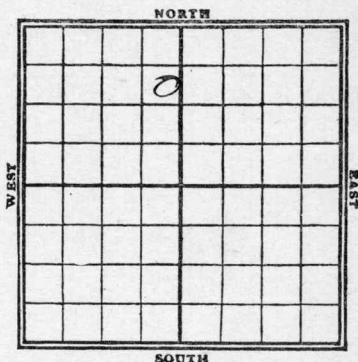

Date 1/27/50

REPORT **FIRST REPORT**

<u>29</u>	<u>Drilling</u>
<u>16</u>	<u>Dr 400'</u>
<u>23</u>	<u>Dr 1040'</u>
<u>31</u>	<u>Dr 1525</u>
<u>8</u>	<u>✓ 1950</u>
<u>15</u>	<u>✓ 2270</u>
<u>29</u>	<u>2378' - 84' 67 Oil</u>
	<u>75 ✓ Water</u>

COMPLETED

Map No. K14 Sec. 29 Twp. 23 R. 4Well No. 3 FerrisOhio Cities Gas Company

Contractor

SECTION PLAT

1120 Ft. from N. Line

Ft. from S. Line

200 Ft. from E. Line

Ft. from W. Line

FIRST REPORT

Location

Rig up

Drilling and Remarks:

Spud

RECORD

Cased _____ in., _____ ft.

Sand _____

Gas _____

Oil _____

Total Depth _____

PRODUCTION

1st 24 hrs. Nat. _____

1st 24 hrs. after shot _____

Gas _____ Cu.

Dry Hole _____

Abandoned _____


Date

2/9 1920

Pyle

Map No. K14 Sec. 29 Twp. 23 R. 4
 Well No. 3 Ferris
Ohio Cities Gas Company
 Contractor

SECTION PLAT

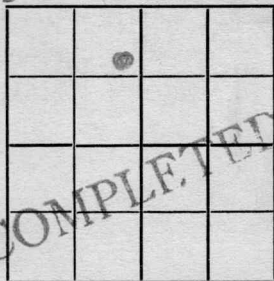

1120 Ft. from N. Line

_____ Ft. from S. Line

200 Ft. from E. Line

_____ Ft. from W. Line

Location _____

Rig up _____

Drilling and Remarks:

67 bbls Oil
75 bbls Water

RECORD

Cased _____ in., _____ ft.

Sand 2378-84

Gas _____

Oil _____

Total Depth _____

PRODUCTION

1st 24 hrs. Nat. _____

1st 24 hrs. after shot _____

Gas _____ Cu. Ft.

Dry Hole _____

Abandoned _____

Date

3/ 1910

Pyle

Scout

29