
Form 51—5M—7-25—19786

Map No. Tarrad Greenwood Sec. 24 Twp. 23 R. 8

Well No. 2 C Scott Farm

Manhattan Oil Company

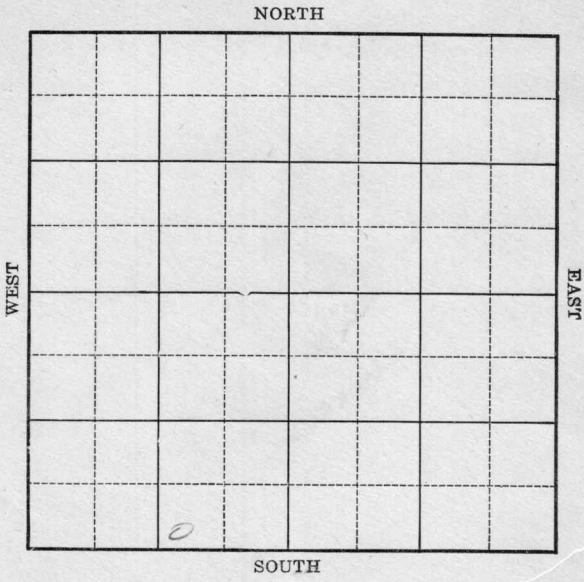

Location

Drilling Remarks

Rig Up

Drilling Remarks

RECORD

Cased in. ft.

Sand

Gas

Oil

Total Depth

PRODUCTION

1st 24 hrs. Nat.

1st 24 hrs. after shot

Gas cu. ft.

Dry Hole


Abandoned

Form 252A—5M—7-25—19684

Map No. Kansas Sec. 24 Twp. 23 R. 8 Greenwood

Well No. 2 C Scott Farm

Manhattan Oil Company

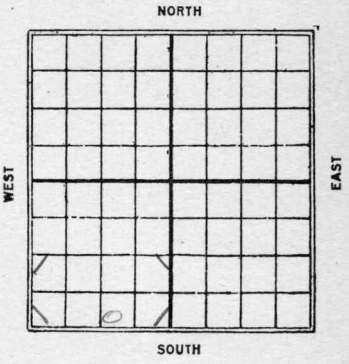

Ft. from N. Line

330 Ft. from S. Line

990 Ft. from E. Line

Ft. from W. Line

Date 1926	REPORT
3/25	Location
4/1	Rig
4/7	"
4/14	Rig
4/21	"
4/30	Dlg 550.
5/8	" 1115.
5/12	" 1660'
5/19	Dlg 2140'
6/-	Abandoned 2586'

Form 26—1M Bks.—3-23—11959. Sherwood

K15 KANSAS Map No. Sec. 24 Twp. 23 R. 8

Well No. 2 C Scott

Manhattan Oil Co. Company

Contractor

FIRST REPORTS

Ft. from N. Line

330 Ft. from S. Line

990 Ft. from E. Line

Ft. from W. Line


Location ✓

Rig up

Drilling and Remarks:

Formerly Hayes & Robert Lot.

SECTION PLAT

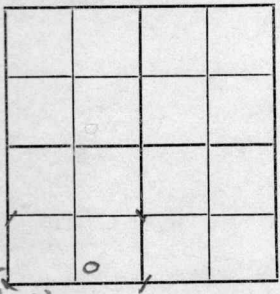

RECORD

Cased in., ft.

Sand

Gas

Oil

Total Depth

PRODUCTION

1st 24 hrs. Nat.

1st 24 hrs. after shot

Gas Cu. Ft.

Dry Hole

Abandoned

Date

MAR 25 1926 192

CHAS. L. SHERWOOD Scout

Form 26—1M Bks.—3-23—11959. Greenwood

K15 KANSAS

Map No. _____ Sec. 24 Twp. 23 R. 8

Well No. 2 "C" Scott

Manhattan Oil Co
_____ Company

_____ Contractor

COMPLETED

_____ Ft. from N. Line


330 Ft. from S. Line

990 Ft. from E. Line

_____ Ft. from W. Line

ABANDONED

SECTION PLAT

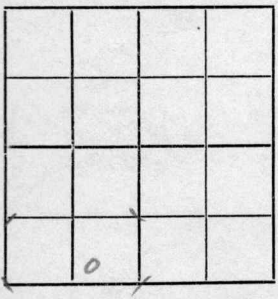

Location _____

Rig up _____

Drilling and Remarks:

Sdy Shale 2551-76
Show Oil
DRY 2586

RECORD

Cased _____ in., _____ ft.

Sand _____

Gas _____

Oil _____

Total Depth 2586

PRODUCTION

1st 24 hrs. Nat. _____

1st 24 hrs. after shot _____

Gas _____ Cu. Ft.

Dry Hole ✓

Abandoned ✓

Date

JUN 2 1926

192 CHAS. L. SHERWOOD Scout