
Map No. 5 Sec. 24 Twp. 23 R. 8

Well No. 3 Scott "C" Farm

Manhattan Oil Company

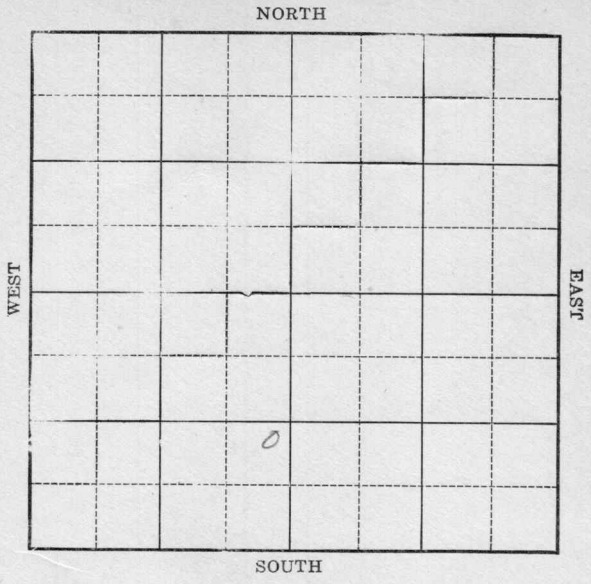

Location _____

Drilling Remarks

Rig Up _____

Drilling Remarks

RECORD

Cased _____ in. _____ ft.

Sand _____

Gas _____

Oil _____

Total Depth _____

PRODUCTION

1st 24 hrs. Nat. _____

1st 24 hrs. after shot _____

Gas _____ cu. ft.

Dry Hole _____


Abandoned _____

Form 252A—5M—11-25—20913 Greenwood

Map No. Kansas Sec. 24 Twp. 23 R. 8

Well No. 3 Scott "C" Farm

Manhattan Oil Company

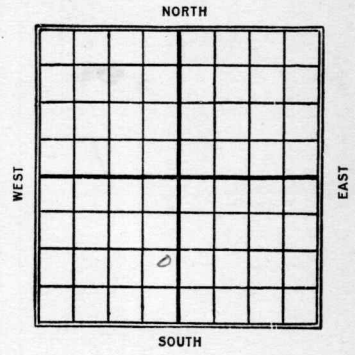

..... Ft. from N. Line

990 Ft. from S. Line

330 Ft. from E. Line

..... Ft. from W. Line

Date	REPORT
1926	
6/9	Location
6/18	Bldg rig
6/25	Rig
6-30	Drlg 320
7/8	" 1170'
7/15	Drlg - 1830
7/22	4 1/2 6" 2395-9'
7/28	Sand 2572-2626 show oil & H F W. will shoot
9/15	Sand 2572-2626 60 qts 20 oil 40 water

Form 26—1M Bks.—3-23—11959. Sherwood

K15 KANSAS

Map No. ---------- Sec. 24 Twp. 23 R. 8

Well No. 3 Scott "C"

Manhattan Oil Co Company

---------- Contractor

FIRST REPORTS


---------Ft. from N. Line

990 Ft. from S. Line

330 Ft. from E. Line

---------Ft. from W. Line

SECTION PLAT

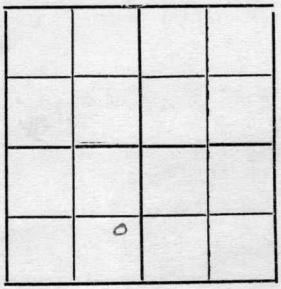

Location ✓

Rig up ----------

Drilling and Remarks:

RECORD

Cased ---------in., ---------ft.

Sand ----------

Gas ----------

Oil ----------

Total Depth ----------

PRODUCTION

1st 24 hrs. Nat. ----------

1st 24 hrs. after shot ----------

Gas ----------Cu. Ft.

Dry Hole ----------

Abandoned ----------

Date

JUN 9 1926

---------192---- CHAS. L. SHERWOOD ----------Scout

Form 26—1M Bks.—3-23—11959. J Sherwood

Map No. KANSAS 13 Sec. 24 Twp. 23 R. 8

Well No. 3 Scott "C"

Man Kelton Oil Co Company

Contractor

COMPLETED


Ft. from N. Line

990 Ft. from S. Line

330 Ft. from E. Line

Ft. from W. Line

SECTION PLAT

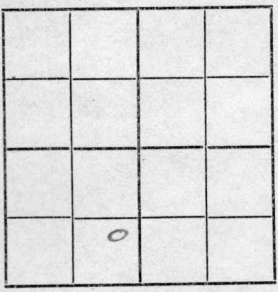

Location

Rig up

Drilling and Remarks:

Lay 20 lbs Oil
40 lbs Water

RECORD

Cased in., ft.

Sand 2572-2626

Gas

Oil

Total Depth 2626

PRODUCTION

1st 24 hrs. Nat.

1st 24 hrs. after shot

Gas Cu. Ft.

Dry Hole

Abandoned

Date

SEP 15 1926 CHAS. L. SHERWOOD

192 Scout