
Form 51—5M—7-25—19786

Map No. Kansas Sec. 25 Twp. 23 R. 8 Greenwood Co

Well No. 4 Sales Farm

Mission Oil Company

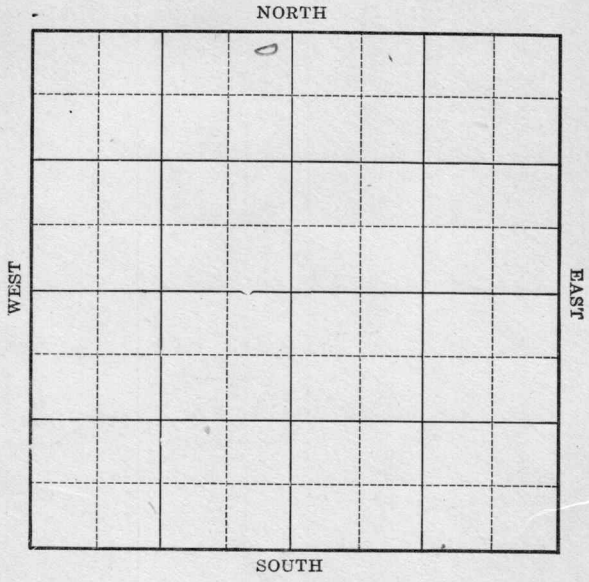

Location	Rig Up
Drilling Remarks	Drilling Remarks

RECORD			PRODUCTION	
Cased	in.	ft.	1st 24 hrs. Nat.	
Sand			1st 24 hrs. after shot	
Gas			Gas	cu. ft.
Oil			Dry Hole	
Total Depth			Abandoned	

Form 252A—5M—7-25—19684

Kansas Greenwood Co

Map No. Sec. 25 Twp. 23 R 8

Well No. 4 Dales Farm


Mission Oil Company

330 Ft. from N. Line

Ft. from S. Line

330 Ft. from E. Line

Ft. from W. Line

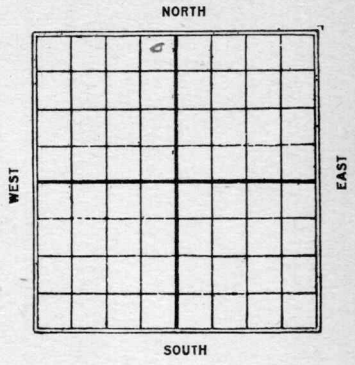

Date	REPORT
1925	
11/27	Bldg Rig
12/3	
12/10	Rigging up.
12/17	
12/23	S. D. 645'
12/31	Drlg 720'
1926	
1/8	Drlg 1335'
1/14	" 1800'
1/20	" 2260'
1/27	Oil 2576 Sand 2569-92'
	S. D. 2592' in sd 100 bbls.

Form 26—1M Bks.—3-23—11959. Moorewood Co


Map No. KANSAS Sec. 25 Twp. 22 R. 8

Well No. 4 DAHES

Mission Oil Co Company

Contractor

SECTION PLAT

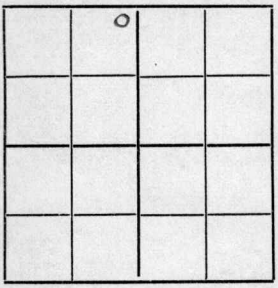

330 Ft. from N. Line

Ft. from S. Line

330 Ft. from E. Line

Ft. from W. Line

FIRST REPORTS

Location

Rig up

Drilling and Remarks:

Bldg Rig

RECORD

Cased in., ft.

Sand

Gas

Oil

Total Depth

PRODUCTION

1st 24 hrs. Nat.

1st 24 hrs. after shot

Gas Cu. Ft.

Dry Hole

Abandoned

Date

NOV 27 1925

192

CHAS. L. SHERWOOD Scout

Form 26—1M Bks.—3-23—11959. Sherwood Co

15 Map No. KANSAS Sec. 25 Twp. 33 R. 9

Well No. 4 Dale

Mission Oil Co Company

Contractor

COMPLETED


330 Ft. from N. Line

Ft. from S. Line

330 Ft. from E. Line

Ft. from W. Line

SECTION PLAT

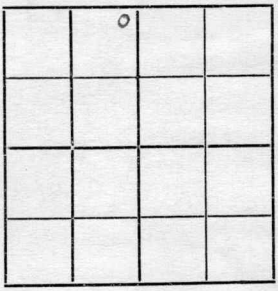

Location

Rig up

Drilling and Remarks:

Oil 2576'

Had 100 bbls.

RECORD

Cased in., ft.

Sand 2569-2592'

Gas

Oil

Total Depth 2592' Lmd.

PRODUCTION

1st 24 hrs. Nat.

1st 24 hrs. after shot

Gas Cu. Ft.

Dry Hole

Abandoned

Date

JAN 27 1926

192 CHAS. L. SHERWOOD

Scout