


Company Morrison Drlg.

NORTH

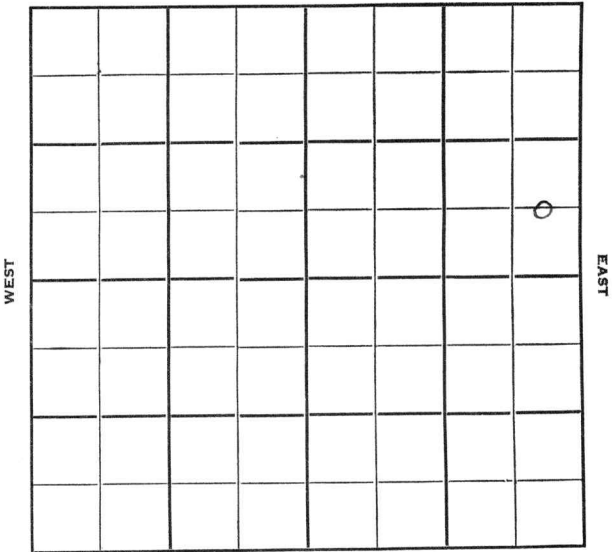

SOUTH

Butler

KANSAS

Sec. 12 Twp. 26 R. 4E

Well No. #2 Enyart Farm

Morrison Drlg. Company

El Dorado Pool Contractor


Ft. from N. Line

660' Ft. from S. Line

330' Ft. from E. Line

Ft. from W. Line

C E L S E N E

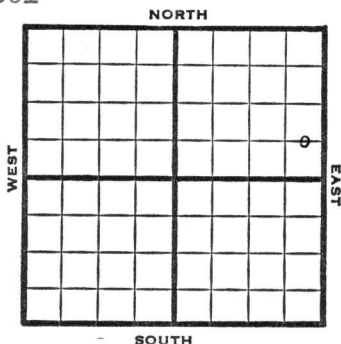

1950

Elev 1372' REPORT

12/6


Spud 12-1-50
8" @ 80'

1951

1/17

Spud 12-1-50
8" @ 80
Cong 2386-2403
4½" @ 2403
Arb 2416
TD 2493½
32/2428-38
32/2418-24
30 qt 2419-39
Comp 40 bopd
Completed


COMPLETED

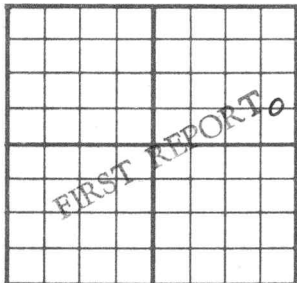County Butler State KansasSec. 12 (Blk. Twp.) 26 (Sur. Rge.) 4E Map No.Operator Morrison Drlg.Well No. 2 Farm EnyartElev. Location C E L S E N E660 Ft. From S Line NE330 Ft. From E Line Quarter1st. Report DEC 6 1950

Completion

Remarks

Spudding Date 12-1-50Drlg. Data Eldorado Pool8" @ 80

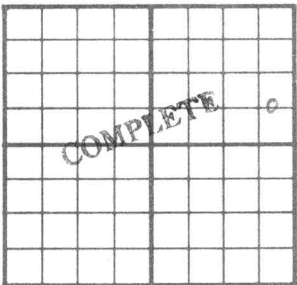County Butler State KansasSec. 12 (Blk.
Twp.) 26 (Sur.
Rge.) 4E Map No.Operator Morrison Drlg.Well No. 2 Farm EnyartElev. 1372 Location C E L S E N E660 Ft. From S Line NE330 Ft. From E Line Quarter

1st. Report _____

Completion JAN 17 1951Remarks Eldorado PoolSpudding Date 12-1-50Drlg. Data Oil well TD 2439 $\frac{1}{2}$ 8" @ 80 Cong. 2386-2403 4 $\frac{1}{2}$ " @ 2403Arb. 2416 TD 2439 $\frac{1}{2}$ 32/ 2428-3832/ 2418-24 30 qt/ 2419-39Comp. 40 bopd

J. E. TYRA