
Form 51—5M—7-25—19786

Map No. KANSAS Sec. 25 Twp. 22 R. 8 Gunward

Well No. 9 Dales Farm

Mission oil Company

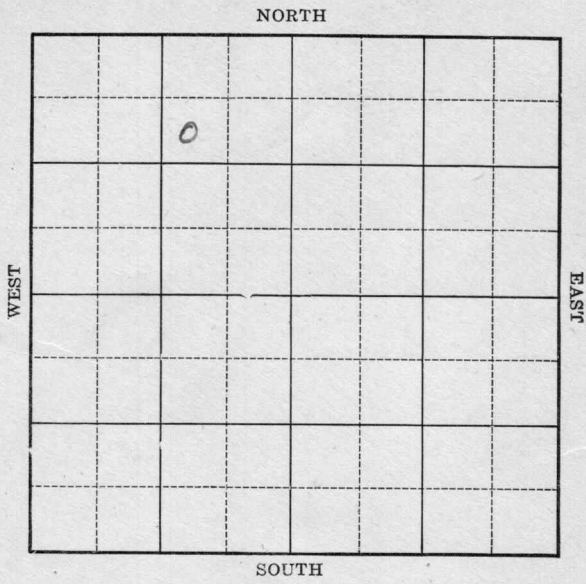

Location	Rig Up
Drilling Remarks	Drilling Remarks

RECORD

Cased ____ in. ____ ft.
Sand
Gas
Oil
Total Depth

PRODUCTION

1st 24 hrs. Nat.
1st 24 hrs. after shot
Gas ____ cu. ft.
Dry Hole
Abandoned

Form 252A—5M—7-25—19684

Kansas / Greenwood Co

Map No. Sec. 25 Twp. 22 R. 8

Well No. 9 Sales Farm


Mission Oil Company

990 Ft. from N. Line

Ft. from S. Line

990 Ft. from E. Line

Ft. from W. Line

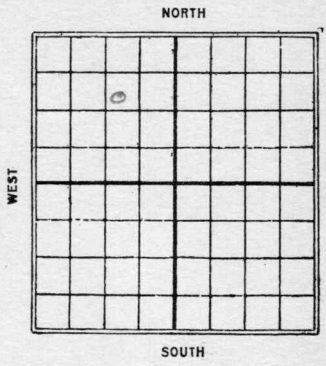

Date	REPORT
1/26	
1/27	Timbers
2/4	Rig
2/10	Rigging up.
2/17	Drlg 5550'
2/24	Running 6" 2145
3/5	Dlg 2025
3/10	S. 2519-2534 - Plugged B. 2532 Shot 20/1000' oil in hole.
3/18	Sand 2519-2534 P.B. to 2532 20 gts 35 bbls

Form 26—1M Bks.—3-23—11959. Sherwood Co

Map No. KANSAS Sec. 25 Twp. 23 R. 8

Well No. 9 DALES

Mission Oil Co Company

Contractor

FIRST REPORTS


990 Ft. from N. Line

Ft. from S. Line

990 Ft. from E. Line

Ft. from W. Line

SECTION PLAT

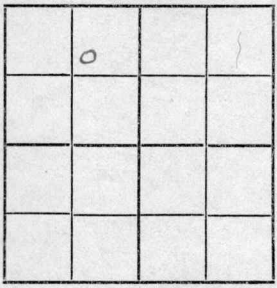

Location

Rig up

Drilling and Remarks:

Jenkins.

RECORD

Cased in., ft.

Sand

Gas

Oil

Total Depth

PRODUCTION

1st 24 hrs. Nat.

1st 24 hrs. after shot

Gas Cu. Ft.

Dry Hole

Abandoned

Date

JAN 27 1926

192

CHAS. L. SHERWOOD

Scout

Form 26—1M Bks.—3-23—11959. Sherwood

K15

Map No. KANSAS Sec. 25 Twp. 23 R. 8

Well No. 9 Dubois

Missouri Oil Co Company

Contractor

COMPLETED


990 Ft. from N. Line

Ft. from S. Line

990 Ft. from E. Line

Ft. from W. Line

SECTION PLAT

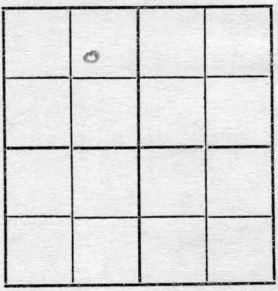

Location

Rig up

Drilling and Remarks:

Plugged Back to 2532'

2 a/ 35 Bbls.

RECORD

Cased in., ft.

Sand 2519-2534

Gas

Oil

Total Depth 2534

PRODUCTION

1st 24 hrs. Nat.

1st 24 hrs. after shot

Gas Cu. Ft.

Dry Hole

Abandoned

Date

MAR 18 1926

192

CHAS. L. SHERWOOD

Scout