


Map No. 100 Sec. 25 Twp. 23 R. 8

Well No. 10 Scott Farm

Jack Robinson Company

NORTH

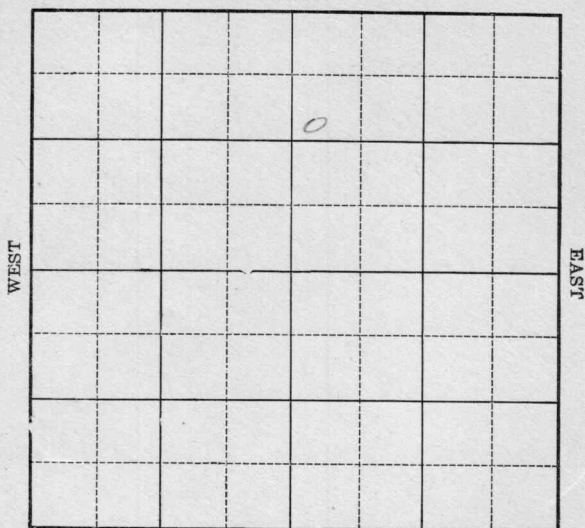

SOUTH

Location _____

Drilling Remarks

Rig Up

Drilling Remarks

RECORD

Cased _____ in. _____ ft.

Sand

Gas

Oil

Total Depth _____

PRODUCTION

1st 24 hrs. Nat.

1st 24 hrs. after shot _____

Gas_____cu. ft.

Dry Hole_____


Abandoned

Well No. 10 Scott Farm
Jack Robinson Company

Ft. from S. Line

-----Ft. from E. Line

330 Ft. from W. Line

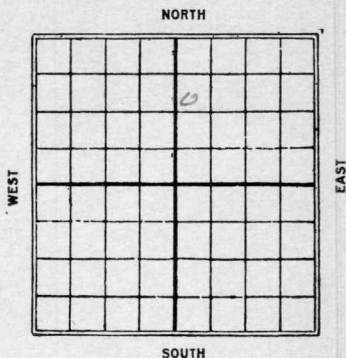

Date	REPORT
1925	
12/10	Location
12/17	Rigging up
12/23	
12/31	Spudding
1926	
1/8	Dry 760'
1/14	✓ 1400'
1/20	✓ 1940'
1/27	✓ 2490'
2/2	Sand 2546-2562
	70 gts 100 Bbls

Sherwood Co

Map No. KANSAS 15-25 Sec. 25 Twp. 23 R. 8Well No. 10 ScottJack Robinson Company

Contractor

SECTION PLAT

996 Ft. from N. Line

Ft. from S. Line

Ft. from E. Line

330 Ft. from W. Line

		o	

FIRST REPORTS

Location ☒

Rig up

Drilling and Remarks:

RECORD

Cased _____ in., _____ ft.

Sand _____

Gas _____

Oil _____

Total Depth _____

PRODUCTION

1st 24 hrs. Nat. _____

1st 24 hrs. after shot _____

Gas _____ Cu. Ft.

Dry Hole _____

Abandoned _____

Date

DEC 10 1925-192 CHAS. L. SHERWOOD

Scout

15 KANSAS 25 23 8
 Map No. Sec. Twp. R.

Well No. 10 Scott
 Jack Robinson Company

Contractor

COMPLETED

SECTION PLAT

990 Ft. from N. Line

_____ Ft. from S. Line

_____ Ft. from E. Line

330 Ft. from W. Line

		0	

Location _____

Rig up _____

Drilling and Remarks:

RECORD

Cased _____ in., _____ ft.

Sand 2546-2562

Gas _____

Oil _____

Total Depth 2562

PRODUCTION

1st 24 hrs. Nat. _____

1st 24 hrs. after shot _____

Gas _____ Cu. Ft.

Dry Hole _____

Abandoned _____

Date

FEB 3 1926

192

CHAS. L. SHERWOOD

Scout

79,100 bbs.