


Map No. 7445 Sec. 23 Twp. 22 R. 0

Well No. 10 Coll Farm

Greenland et al. Company

NORTH

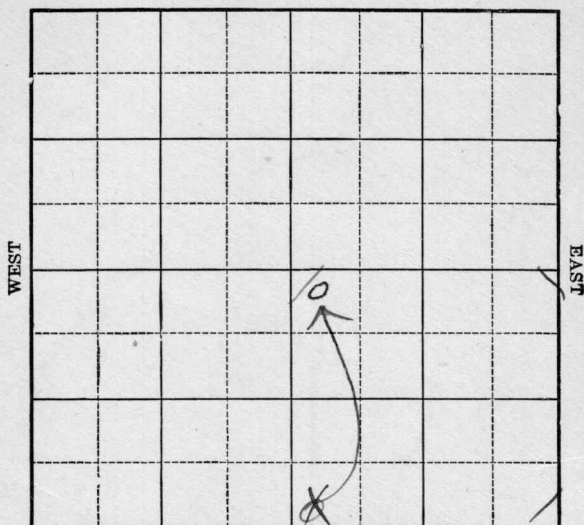

SOUTH

Location _____

Drilling Remarks

Rig Up _____

Drilling Remarks

RECORD

Cased _____ in. _____ ft.

Sand

Gas

Oil

Total Depth_____

PRODUCTION

1st 24 hrs. Nat.

1st. 24 hrs. after shot_____

Gas _____ cu. ft.

Dry Hole

Abandoned


Map No. *Kan* Sec. *25* Twp. *23* R. *8 E*
 Well No. *1 "B" Scott* Farm
Greenland Oil Company

330 Ft. from N. Line

330 Ft. from S. Line

Ft. from E. Line

330 Ft. from W. Line

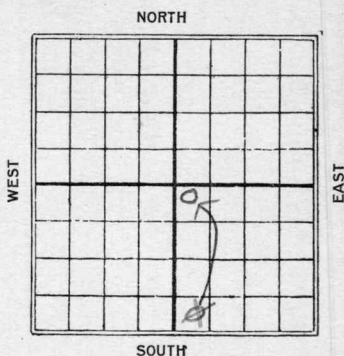

Date	REPORT
<i>1925</i>	
<i>7/22</i>	<i>Loc.</i>
<i>7/31</i>	<i>—</i>
<i>8/17</i>	<i>—</i>
<i>8/14</i>	<i>—</i>
<i>8/20</i>	<i>lin bers</i>
<i>8/26</i>	<i>Rig.</i>
<i>9/3</i>	<i>Rigin up</i>
<i>9/11</i>	<i>spud + sd.</i>
<i>9/16</i>	<i>—</i>
<i>9/24</i>	<i>—</i>
<i>10/1</i>	<i>Drig 400</i>
<i>10/8</i>	<i>1340</i>
<i>10/16</i>	<i>2085</i>
<i>10/22</i>	<i>Tap sand 2508 oil @ 2518 T.D. 2540 600' Oil Nat shot 80 gts to C.O. est 200 bbls.</i>
<i>10/29</i>	<i>Sand 2508-2540 80 gts 300 Bbls</i>

Map No. 15 Sec. 25 Twp. 23 R. 8Well No. 1 "B" ScottCompany Wen Lins oil Co, Ind

Contractor _____

FIRST REPORTS

SECTION PLAT

Ft. from N. Line

Ft. from S. Line

Ft. from E. Line

Ft. from W. Line

Location ☒

Rig up _____

Drilling and Remarks:

RECORD

Cased _____ in., _____ ft.

Sand _____

Gas _____

Oil _____

Total Depth _____

PRODUCTION

1st 24 hrs. Nat. _____

1st 24 hrs. after shot _____

Gas _____ Cu. Ft.

Dry Hole _____

Abandoned _____

Date

JUL 24 1925

CHAS. L. SHERWOOD

192

Scout

15 KANSAS 25 Twp. 23 R. 8

Well No. 1 B Scott

Robert Land also Inc Company

Contractor

CORRECTION


SECTION PLAT

330 Ft. from N. Line

Ft. from S. Line

Ft. from E. Line

330 Ft. from W. Line

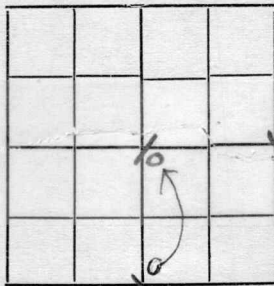

Location

Rig up Zimbers

Drilling and Remarks:

chg well No
to above.

RECORD

Cased _____ in., _____ ft.

Sand _____

Gas _____

Oil _____

Total Depth _____

PRODUCTION

1st 24 hrs. Nat. _____

1st 24 hrs. after shot _____

Gas _____ Cu. Ft.

Dry Hole _____

Abandoned _____

Date

AUG 20 1925

CHAS. L. SHERWOOD

192

Scout

K15
Map No. **KANSAS** Sec. **25** Twp. **23** R. **8**

Well No. **1 B Scott**
Mon Land & Oil Co Company

Contractor

COMPLETED

SECTION PLAT

330 Ft. from N. Line

_____ Ft. from S. Line

_____ Ft. from E. Line

330 Ft. from W. Line

		o	

Location _____

Rig up _____

Drilling and Remarks:

ord 2518

80/300 bhs

RECORD

Cased _____ in., _____ ft.

Sand **2508-2540'**

Gas _____

Oil _____

Total Depth **2540**

PRODUCTION

1st 24 hrs. Nat. _____

1st 24 hrs. after shot _____

Gas _____ Cu. Ft.

Dry Hole _____

Abandoned _____

Date

OCT 29 1925

192

CHAS. L. SHERWOOD
Scout