
Form 51—5M—7-25—19786

Map No. K Sec. 25 Twp. 23 R. 8

Well No. 2 Scott "B" Farm

Manhattan Oil Company

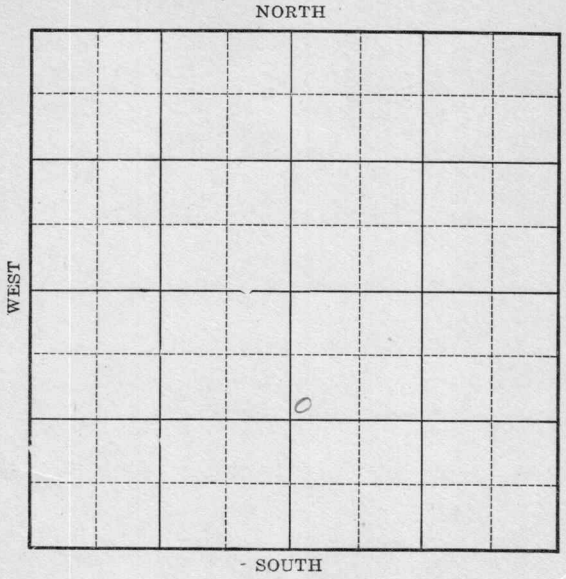

Location

Drilling Remarks

Rig Up

Drilling Remarks

RECORD

Cased in. ft.

Sand

Gas

Oil

Total Depth

PRODUCTION

1st 24 hrs. Nat.

1st 24 hrs. after shot

Gas cu. ft.

Dry Hole

Abandoned

Form 252A—5M—11-25—20913

Map No. Kansas Sec. 25 Twp. 23 R. 8 Greenwood

Well No. 2 Scott "B" Farm


Manhattan Oil Company

990 Ft. from N. Line

_____ Ft. from S. Line

_____ Ft. from E. Line

330 Ft. from W. Line

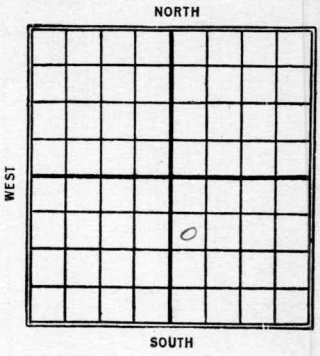

Date 1926	REPORT
6/1	Location
6/10	Same
6/18	rig-ing up
6/25	Spudding
6-30	Dlg 925'
7/8	" 1710
7/15	Dlg 2245'
7/22	Sand 2579- oil 2605'-2628 shot 40 qts., Est. 10 bbls.
7/28	Sand 2579-2628 oil 2605', 40/2 bbls 30 bbls Water. T.D. 2628'

Form 26—1M Bks.—3-23—11959. Sherwood

Map No. K15 KANSAS Sec. 25 Twp. 23 R. 8

Well No. 2 Scott "B"

Manhattan Oil Co. Company

Contractor

FIRST REPORTS


990 Ft. from N. Line

Ft. from S. Line

Ft. from E. Line

330 Ft. from W. Line

SECTION PLAT

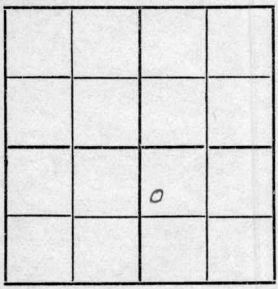

Location ✓

Rig up

Drilling and Remarks:

RECORD

Cased in., ft.

Sand

Gas

Oil

Total Depth

PRODUCTION

1st 24 hrs. Nat.

1st 24 hrs. after shot

Gas Cu. Ft.

Dry Hole

Abandoned

Date

JUN 2 1926

192

CHAS. L. SHERWOOD

Scout

Form 26—1M Bks.—3-23—11959.

Map No. K15 KANSAS Sec. 25 Twp. 22 R. 8

Well No. 2 Scott "B"

Manhattan Oil Co Company

Contractor

Eberwood

COMPLETED


990 Ft. from N. Line

Ft. from S. Line

Ft. from E. Line

330 Ft. from W. Line

SECTION PLAT

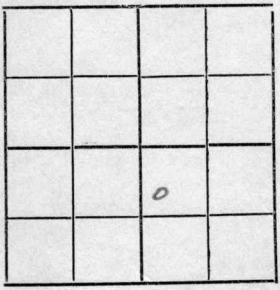

Location

Rig up

Drilling and Remarks:

oil 2605

40 gr 12 lbs oil

30 lbs Water

RECORD

Cased in., ft.

Sand 2579-2628

Gas

Oil

Total Depth 2628

PRODUCTION

1st 24 hrs. Nat.

1st 24 hrs. after shot

Gas Cu. Ft.

Dry Hole

Abandoned

Date

JUL 28 1926

192

CHAS. L. SHERWOOD

Scout