


Abandoned

Map No. **KANSAS** Sec. 31 Twp. 14 R. 13^w
Well No. 1- Miller Farm
J. J. Hall et al Company

330 Ft. from N. Line
990 Ft. from S. Line
330 Ft. from E. Line
1932 Ft. from W. Line *Our lease-*

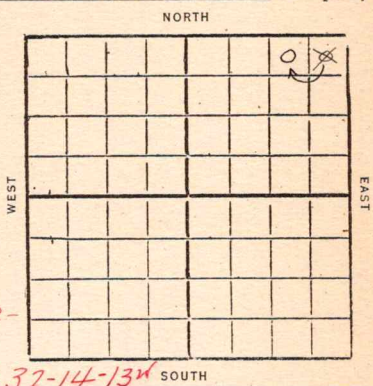

Date	REPORT
10/5	Rig
10/12	Rig up
10/19	
10/26	—
11/2	—
11/9	Rig & tools
11/16	—
11/23	—
11/30	—
12/7	—
12/14	—
12/21	—
12/28	—
1933	
1/4	—
1/11	—
1/18	—
1/25	—
2/1	—
2/8	20"-39
	SP 165'
2/15	Spdg 170'

2/22 Drilling 20" 171'

3/4 - dly 387

3/8 " 800'

3/15 - 15" - 170' 12 1/2 - 640' dly 1300'

3/22 dly 1676

3/29 run 10" 1888'

4/14 10" 1883 dly 2120'

4/12 show oil ~~dly~~ 2267-70 sandy
lime dly 2306

4/19 S.O. 2308'

4/26 S.O. 2317 for 8"

5/4 dly 2830

5/10 Top Lansing 2878 oil 2898'

S.O. 2901' - 1000' oil 1 hr

1600' oil in hole P.B.P.

5/17 Est 150 bbls will swab

5/24 —

6/1 —

6/8 —

6/15 —

6/21 —

6/28 —

7/12 Top Lansing 2878

oil 2898-2901

oil 2909-2916

Est 400 bbls

COMPLETED

1934

O.W.D.D.

2/28 Drilling deeper

3/1 - O.T.D 2918 Y.D 2984 1000'
oil acidizing

3/8 500 Gal acid No test

3/15 Correct Y.D 2995 1000 Gal acid

3/21 Y.D 2995 1000 Gal acid
80 Bbls,

COMPLETED

1934

10/10 Inc oil 3030
3043 T_D
1000 acid

10/18 Testing

10/24 T_D 3043 1000 acid
71 Bbls pot

COMPLETED

1935

O. W. D. D

2/6 Rgn

2/14 Blg 3123 3094 Inc Oil

2/21 Sand 3154 T_D 3155
2700' oil

2/27 Sand 3154
T_D 3155
597 Bbls.

COMPLETED

72 KANSAS

Map No. _____ Sec. 31 Twp. 14 R. 13

Well No. 1 Miller
J. J. Hall & Co. _____ Company

Contractor _____

FIRST REPORTS

SECTION PLAT

330 Ft. from N. Line

_____ Ft. from S. Line

330 Ft. from E. Line

_____ Ft. from W. Line

Our lease the

N² SE⁴ & NE⁴ Sec. 32.

			0

Location _____

Rig up _____

Drilling and Remarks:

RECORD

Cased _____ in., _____ ft.

Sand _____

Gas _____

Oil _____

Total Depth _____

PRODUCTION

1st 24 hrs. Nat. _____

1st 24 hrs. after shot _____

Gas _____ Cu. Ft.

Dry Hole _____

Abandoned _____

Date

OCT 5 1932

CHAS. L. SHERWOOD

192

Scout

Russell

W

KANSAS
Map No. 98 Sec. 31 Twp. 14 R. 13Well No. 1 Miller
J. J. Hall et al Company

Contractor

CORRECTION

SECTION PLAT

			040

330 Ft. from N. Line

Ft. from S. Line

990 Ft. from E. Line

Ft. from W. Line

Location

Rig up

Drilling and Remarks:

Chg Location
to Above.

RECORD

Cased in., ft.

Sand

Gas

Oil

Total Depth

PRODUCTION

1st 24 hrs. Nat.

1st 24 hrs. after shot

Gas Cu. Ft.

Dry Hole

Abandoned

Date

OCT 26 1932

CHAS. L. SHERWOOD

192

Scout

Russell
Map No. Sec. *31* Twp. *14* R. *13W*
72
Well No. *1 - Miller*
G. J. Hall et al Company
Contractor

SECTION PLAT

330 Ft. from N. Line
Ft. from S. Line
990 Ft. from E. Line
Ft. from W. Line

			0

SPECIAL

COMPLETED

Location.....
Rig up.....
Drilling and Remarks:

Top Landing 2878
oil 2898-2901
oil 2909-16
Est. 400 BALS

RECORD

Cased.....in.,ft.
Sand.....
Gas.....
Oil.....
Total Depth *2918*

PRODUCTION

1st 24 hrs. Nat.....
1st 24 hrs. after shot.....
Gas.....Cu. Ft.
Dry Hole.....
Abandoned.....

Date *7/12/33* 192..... *Orval Mannheim* Scout

Map No. 77 Sec. 31 Twp. 14 R. 13W

Well No. 1-Miller

G. J. Hall Company

Contractor

SPECIAL

SECTION PLAT

			0

330 Ft. from N. Line

..... Ft. from S. Line

990 Ft. from E. Line

..... Ft. from W. Line

OWP D

RECORD

Location.....

Cased..... in., ft.

Rig up.....

Sand.....

Drilling and Remarks:

Gas.....

Oil.....

Total Depth.....

OTD 2918

Deepened 2984

1000' oil.

well and gze

PRODUCTION

1st 24 hrs. Nat.....

1st 24 hrs. after shot.....

Gas..... Cu. Ft.

Dry Hole.....

Abandoned.....

Date

5-28-34

192

O. Manschreck Scout

Map No. 72 Sec. 31 Twp. 14 R. 13WWell No. 1-MillerJ. J. Hall Company

Contractor

COMPLETE SPECIAL SECTION PLAT

330 Ft. from N. Line

_____ Ft. from S. Line

990 Ft. from E. Line

_____ Ft. from W. Line

			0

Location _____

Rig up _____

Drilling and Remarks:

1000 gal. air80 bbls

RECORD

Cased _____ in., _____ ft.

Sand _____

Gas _____

Oil _____

Total Depth 2975

PRODUCTION

1st 24 hrs. Nat. _____

1st 24 hrs. after shot _____

Gas _____ Cu. Ft.

Dry Hole _____

Abandoned _____

Date

3/21/34 1934 O. Mannschreck Scout

KANSAS

Map No. 12 Sec. 31 Twp. 14 R. 13 WWell No. 1- MillerJ. J. Hall et al Company

Contractor

FIRST REPORTS

SECTION PLAT

330 Ft. from N. Line

_____ Ft. from S. Line

990 Ft. from E. Line

_____ Ft. from W. Line

			0

Location _____

Rig up _____

Drilling and Remarks:

OTU 2975
inc oil 3030
3043 TH
1000 acid

RECORD

Cased _____ in., _____ ft.

Sand _____

Gas _____

Oil _____

Total Depth _____

PRODUCTION

1st 24 hrs. Nat. _____

1st 24 hrs. after shot _____

Gas _____ Cu. Ft.

Dry Hole _____

Abandoned _____

Date

10-10-37 19

ORVAL MANNSCHRECK

Scout

KANSAS

Map No. 72 Sec. 31 Twp. 14 R. 13WWell No. 1-MillerJ. J. Hall Company

Contractor

SECTION PLAT

			0

330 Ft. from N. Line

_____ Ft. from S. Line

990 Ft. from E. Line

_____ Ft. from W. Line

awss

Location _____

Rig up _____

Drilling and Remarks:

1000 acid71 bbls
pot.

RECORD

Cased _____ in., _____ ft.

Sand _____

Gas _____

Oil _____

Total Depth 3043

PRODUCTION

1st 24 hrs. Nat. _____

1st 24 hrs. after shot _____

Gas _____ Cu. Ft.

Dry Hole _____

Abandoned _____

Date

10-24-34 19ORVAL MANNSCHRECK
Scout

Map No. 77 Sec. 31 Twp. 14 R. 13W
Well No. 1- Miller

J. J. Hall et al Company
(Smoky Hill Oil Co) Contractor

FIRST REPORTS

SECTION PLAT

330 Ft. from N. Line

..... Ft. from S. Line

990 Ft. from E. Line

..... Ft. from W. Line

QWP N

			<u>0</u>

Location.....

Rig up.....

Drilling and Remarks:

OTN 3043

Rgn

RECORD

Cased..... in., ft.

Sand.....

Gas.....

Oil.....

Total Depth.....

PRODUCTION

1st 24 hrs. Nat.....

1st 24 hrs. after shot.....

Gas..... Cu. Ft.

Dry Hole.....

Abandoned.....

Date

2-6-35 192.....

ORVAL MANNSCHRECK

Scout

Map No. 72 Sec. 31 Twp. 14 R. 13 WWell No. 1- MillerSmoky Hill

Company

Contractor

2000

SECTION PLAT

			0

330 Ft. from N. Line

Ft. from S. Line

990 Ft. from E. Line

Ft. from W. Line

COMPLETED

Location

Rig up

Drilling and Remarks:

597 fth

RECORD

Cased in. ft.

Sand 3154

Gas

Oil

Total Depth 3155

PRODUCTION

1st 24 hrs. Nat.

1st 24 hrs. after shot

Gas Cu. Ft.

Dry Hole

Abandoned

Date

ORVAL MANNSCHRECK

2-27-35 192

Scout