
FORM 51 10M 2-49 PETROL KANSAS Butler

Section 36 Township 23 Range 4E

Well No. 1 Knaussman

Company Rex & Morris

Misc.

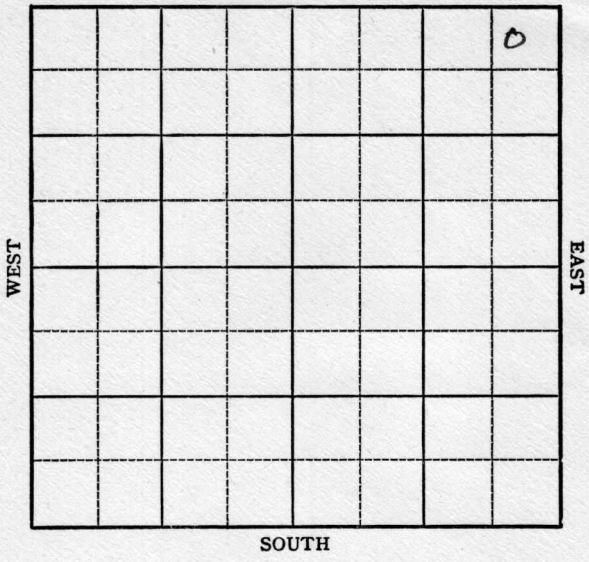

FORM 252-A
5M 10-48 PETROL

KANSAS Butler

Sec. 36 Twp. 23 R. 4E

Well No. #1 Knaussman Farm

Rex & Morris Company

Miscellaneous


330' Ft. from N. Line

Ft. from S. Line

330' Ft. from E. Line

Ft. from W. Line

NE/C

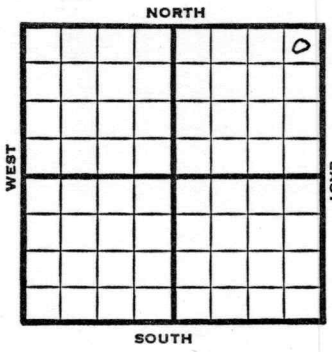

1949	Elev 1442' REPORT
2/16	Location
2/23	15" @ 173' 13" @ 337' Drlg. 910'
3/2	10" @ 1774' Lans 1820' Drlg. 1880'
3/9	TD 2449' Miss 2445' Aband.

ABANDONED

Form 26 200 Bks. 9-48 Petrol

Kansas

Miscellaneous

Map No. _____ Sec. 36 Twp. 23 R. 4E

Well No. 1 Knaussman

Rex & Morris Company

FIRST REPORT Contractor

NE/C


330 Ft. from N. Line

_____ Ft. from S. Line

330 Ft. from E. Line

_____ Ft. from W. Line

SECTION PLAT

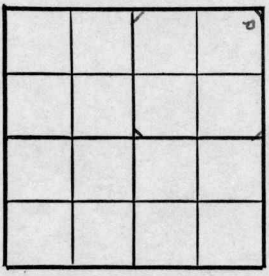

Butler County

Location x

Rig up _____

Drilling and Remarks:

RECORD

Cased _____ in., _____ ft.

Sand _____

Gas _____

Oil _____

Total Depth _____

PRODUCTION

1st 24 hrs. Nat. _____

1st 24 hrs. after shot _____

Gas _____ Cu. Ft.

Dry Hole _____

Abandoned _____

Date

FEB 16 1949 19 S. J. LEWIS Scout

Form 26 200 Bks. 9-48 Petrol

Miscellaneous

Kansas

Map No. 14 Sec. 36 Twp. 23 R. 4E ~~4E~~

Well No. 1 Knaussman


Rex & Morris Company

ABANDONED Contractor

NE/C

E. 1/4 42

SECTION PLAT

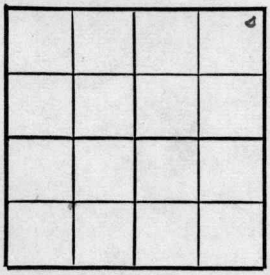

330 Ft. from N. Line

Ft. from S. Line

330 Ft. from E. Line

Ft. from W. Line

Butler County

Location

Rig up

Drilling and Remarks:

Miss 2445

RECORD

Cased in., ft.

Sand

Gas

Oil

Total Depth 2449

PRODUCTION

1st 24 hrs. Nat.

1st 24 hrs. after shot

Gas Cu. Ft.

Dry Hole

Abandoned

Date

MAR 9 1949 19

S. J. LEWIS Scout