


Section 12 Township 26 Range 4E

Well No. #4 Enyart

Company Morrison Drlg.

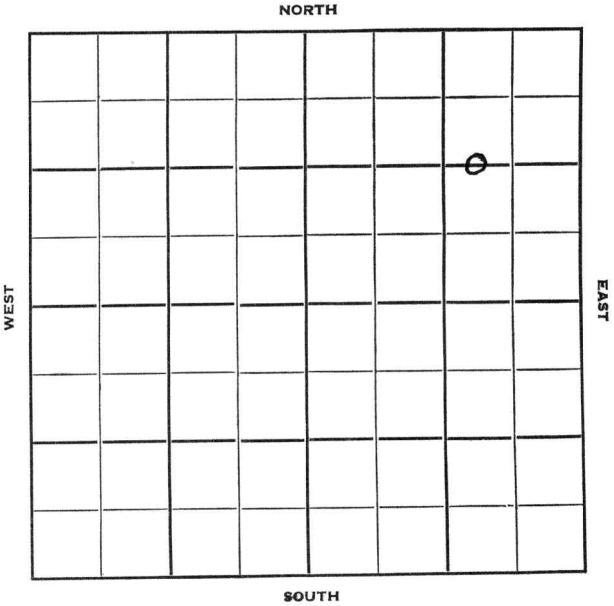

Butler KANSAS

Sec. 12 Twp. 26 R. 4 E

Well No. # 4 Enyart Farm

Morrison Drlg.

Company

Contractor

El Dorado


1320 Ft. from N. Line

Ft. from S. Line

825 Ft. from E. Line

Ft. from W. Line

W/2 E/2 NE

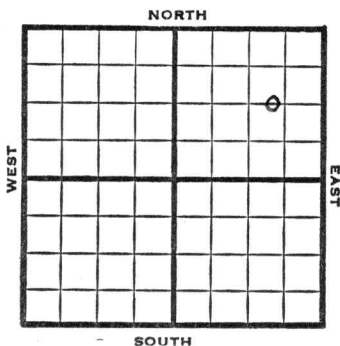

1952

Elev. 1383 REPORT

1/9

Spud 1-8-52

Drilling

2/6

TD 2420 Arb. 2404

32/2445-59 CO

2/13

Spud 1-8-52

Oil Well TD 2459


8" @ 105

Arb. 2404 5" @ 2420

TD 2459 32 qt. 2445-59

Comp. 15 bopd

COMPLETED

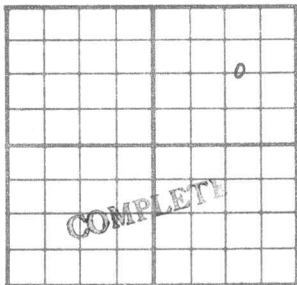County Butler State KansasSec. 12 (Blk.
Twp.) 26 (Sur.
Rge.) 4E Map No.Operator Morrison Drlg.Well No. 4 Farm EnyartElev. 1383 Location C W L E $\frac{1}{2}$ NE1320 Ft. From N Line NE825 Ft. From E Line Quarter

1st. Report

Completion FEB 13 1950Remarks ElDorado PoolSpudding Date 1-8-52Drlg. Data Oil well TD 24598" @ 105 Arb. 2404 5" @ 2420 TD 245932 qt/ 2445-59 Comp. 15 bopd

J. G. McGEHEE