

Map No. _____ Sec. 12 Twp. 26 R. ✓Well No. 4 Enyart Farm __________Empire Company

NORTH

WEST

EAST

SOUTH

Location _____

Rig Up _____

Drilling Remarks:

Drilling Remarks:

RECORD

Cased _____ in. _____ ft.

Sand _____

Gas _____

Oil _____

Total Depth _____

PRODUCTION

1st 24 hrs. Nat. _____

1st 24 hrs. after shot _____

Gas _____ cu. ft

Dry Hole _____

Abandoned _____

Map No. _____ Sec. 12 Twp. 26 R. 4Well No. 4 E. August Farm _____

Company _____

NORTH

WEST

FIRST REPORT

EAST

SOUTH

Location _____

Rig Up _____

Drilling and remarks _____

RECORD

Cased _____ in _____ Ft.

Sand _____

Gas _____

Oil _____

Total Depth _____

PRODUCTION

1st 24 hrs. Nat. _____

1st 24 hrs. after shot _____

Gas _____ Cu. Ft.

Dry Hole _____

Abandoned _____

FIRST REPORT

Date

191


Scout

Map No. _____ Sec. 12 Twp. 26 R. 4Well No. 4. Empire Farm _____

Company _____

NORTH

WEST

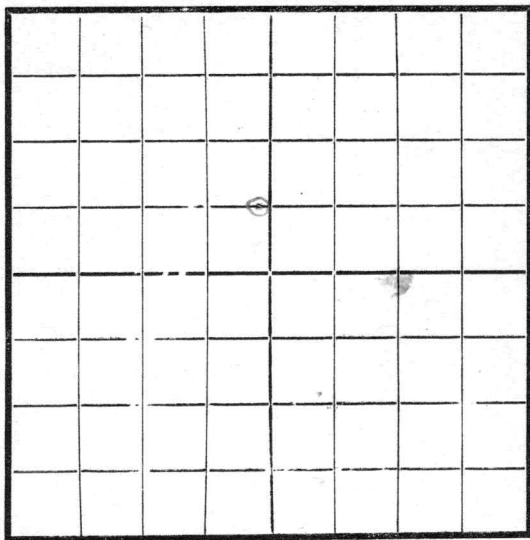

EAST

SOUTH

Location _____

Rig Up ☒ _____

Drilling and remarks _____

RECORD

Cased _____ in. _____ Ft.

Sand _____

Gas _____

Oil _____

Total Depth _____

PRODUCTION

1st 24 hrs. Nat. _____

1st 24 hrs. after shot _____

Gas _____ Cu. Ft.

Dry Hole _____


Abandoned _____

Date

8-24, 1917 Lantz Scout

Map No. _____ Sec. 12 Twp. 26 R. 4Well No. 4 E. scout Farm
Empire Company

NORTH

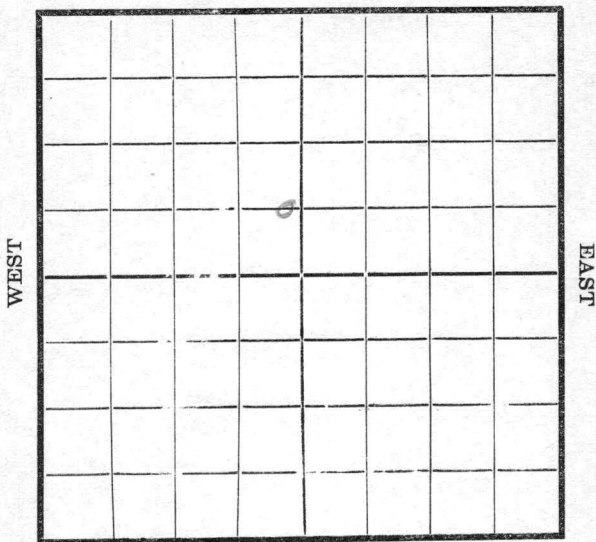

SOUTH

Location _____

Rig Up _____

Drilling and remarks

2165

RECORD

Cased _____ in. _____ Ft.

Sand _____

Gas _____

Oil _____

Total Depth _____

PRODUCTION

1st 24 hrs. Nat. _____

1st 24 hrs. after shot _____

Gas _____ Cu. Ft.

Dry Hole _____

Abandoned _____

Date

10/9, 1917 Empire Scout

Map No. _____ Sec. 12 Twp. 26 R. 4Well No. 4 Canyon _____ Farm

_____ Company

NORTH

WEST

EAST

SOUTH

Location _____

Rig Up _____

Drilling and remarks

Top sand
2412

RECORD

Cased _____ in. _____ Ft.

Sand _____

Gas _____

Oil _____

Total Depth _____

PRODUCTION

1st 24 hrs. Nat. _____

1st 24 hrs. after shot _____

Gas _____ Cu. Ft.

Dry Hole _____

Abandoned _____


Date

10/17, 1917, *Carby* _____ Scout

Map No. _____ Sec. 12 Twp. 26 R. 4Well No. 4 _____ Farm _____
Engine Company

NORTH

WEST

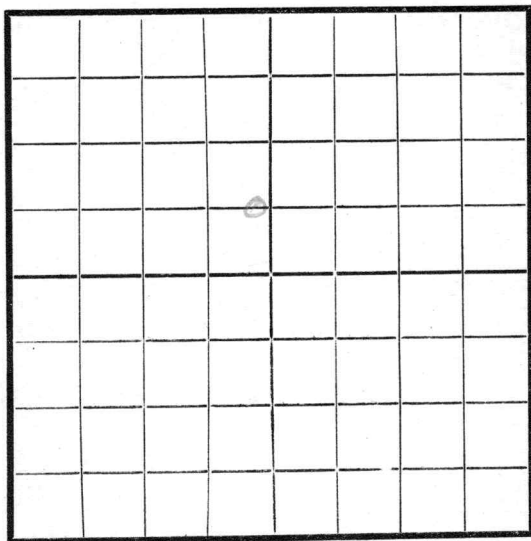

EAST

SOUTH

Location _____

Rig Up _____

Drilling and remarks

2 D on
top sand
2412

RECORD

Cased _____ in. _____ Ft.

Sand _____

Gas _____

Oil _____

Total Depth _____

PRODUCTION

1st 24 hrs. Nat. _____

1st 24 hrs. after shot _____

Gas _____ Cu. Ft.

Dry Hole _____


Abandoned _____

Date

10/24/1912 _____ Scout

Map No. _____ Sec. 12 Twp. 26 R. 4
 Well No. 4 Emyant Farm _____
Emphire Company _____

NORTH

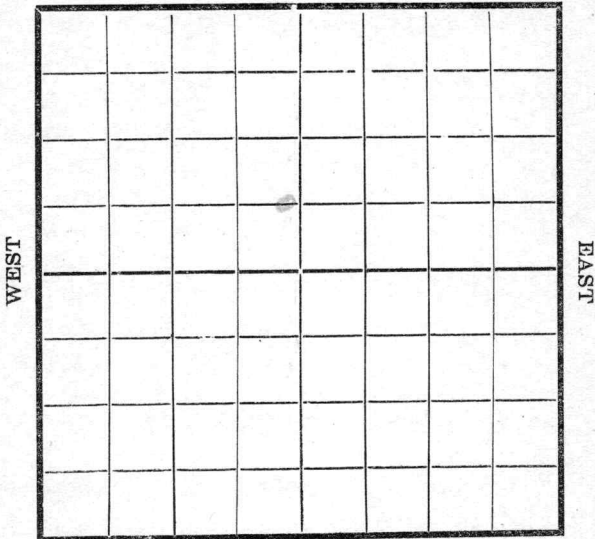

SOUTH

		RECORD	
Location _____		Cased _____ in. _____ Ft.	
Rig Up _____		Sand _____	
Drilling and remarks		Gas _____	
<u>22</u>		Oil _____	
<u>2412</u>		Total Depth _____	
<u>Top sand</u>		PRODUCTION	
		1st 24 hrs. Nat. _____	
		1st 24 hrs. after shot _____	
		Gas _____ Cu. Ft.	
		Dry Hole _____	
		Abandoned _____	


Date

10/31, 1917 Condy Scout

Map No. _____ Sec. 12 Twp. 26 R. 4Well No. 4 Engard Farm _____
Engard Company

NORTH

WEST

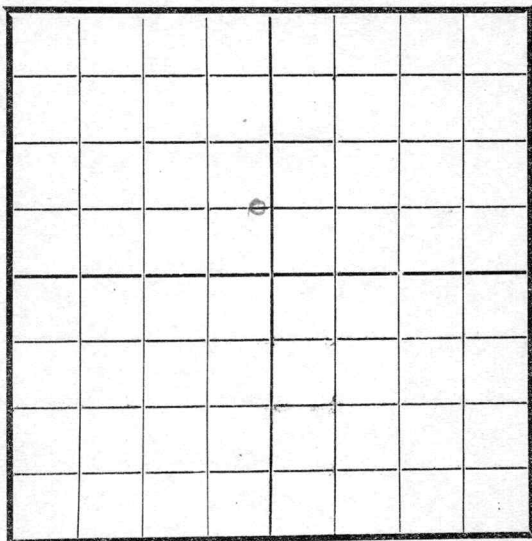

EAST

SOUTH

Location _____

Rig Up _____

Drilling and remarks

*SD on top
Sand
2412*

RECORD

Cased _____ in. _____ Ft.

Sand _____

Gas _____

Oil _____

Total Depth _____

PRODUCTION

1st 24 hrs. Nat. _____

1st 24 hrs. after shot _____

Gas _____ Cu. Ft.

Dry Hole _____

Abandoned _____


Date

11-2, 1917 Conley Scout

Map No. _____ Sec. 12 Twp. 26 R. 4
 Well No. 48 Engine Farm _____
 _____ Company

NORTH

WEST

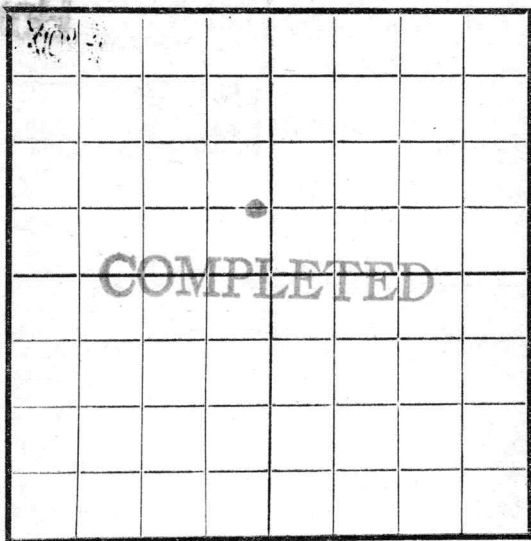

EAST

SOUTH

Location _____
 Rig Up _____
 Drilling and remarks

Est at
300
Bbls

RECORD

Cased _____ in. _____ Ft.
 Sand 2394-2475
 Gas _____
 Oil _____
 Total Depth _____

PRODUCTION

1st 24 hrs. Nat. _____
 1st 24 hrs. after shot _____
 Gas _____ Cu. Ft.
 Dry Hole _____
 Abandoned _____

Date

11/14, 1917 Condy Scout