
Greenwood

FORM 51-5M-6-29-PETROL

Map No. KANSAS Sec. 32 Twp. 23 R. 13E

Well No. 3 Neylin Farm

Freedy Trail Company

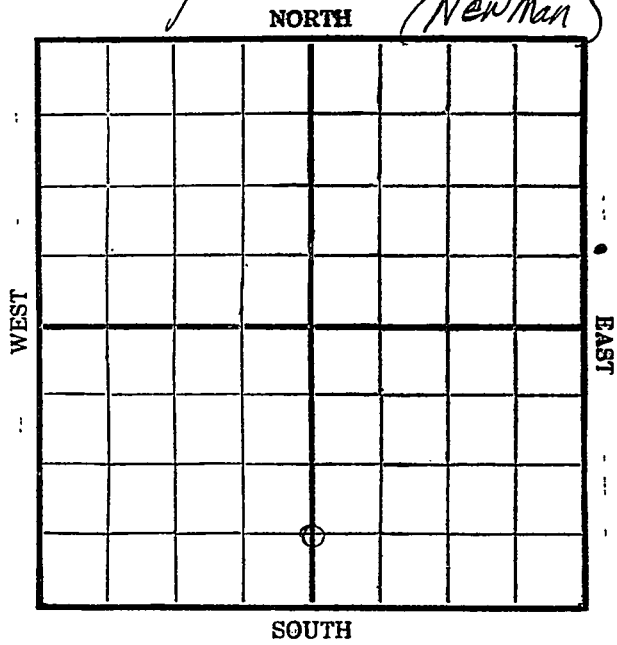

Location

Drilling Remarks

Rig Up

Drilling Remarks

RECORD

Cased ____ in. ____ ft.

Sand

Gas

Oil

Total Depth

PRODUCTION

1st 24 hrs. Nat.

1st 24 hrs. after shot

Gas ____ cu. ft.

Dry Hole


Abandoned

FORM 252A-5M-12-28-PETROL

Map No. KANSAS Sec. 32 Twp. 23 R. 13E

Well No. 3 - Newlin Farm

Sheedy et al Company

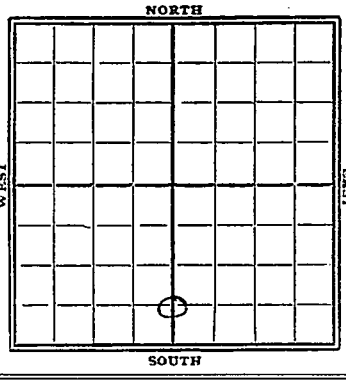

_____ Ft. from N. Line

660 Ft. from S. Line

_____ Ft. from E. Line

2640 Ft. from W. Line

1929

Date	REPORT
8/21	Drlg 200'
8/28	" 900
9/4	" 1150'
9/11	Top lime 1625 Sand 1640 - 45' T.D. 1647 show oil Dry & Abandoned

Form 26—1M Bks.—2-29

Sherwood

17 KANSAS

Map No. Sec. 32 Twp. 23 R. 13 E

Well No. 3 Newlin

Steedy et al Company

Contractor

FIRST REPORTS


_____ Ft. from N. Line

660 Ft. from S. Line

_____ Ft. from E. Line

1620 Ft. from W. Line

SECTION PLAT

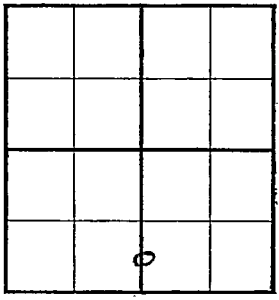

Location

Rig up

Drilling and Remarks:

Dg 200'—

RECORD

Cased _____ in., _____ ft.

Sand

Gas

Oil

Total Depth

PRODUCTION

1st 24 hrs. Nat.

1st 24 hrs. after shot

Gas Cu. Ft.

Dry Hole

Abandoned

Date 8/21 19 29

CHAS. L. SHERWOOD Scout

Form 26—1M Bks.—2-29 Sherwood

17 Map No. KANSAS Sec. 32 Twp. 23 R. 13


Well No. 3 Newman

Sheedy et al Company

Contractor

COMPLETE

SECTION PLAT

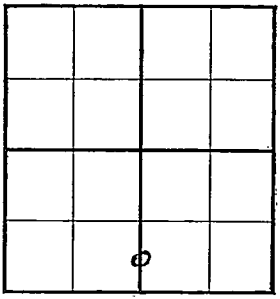

____ Ft. from N. Line

660 Ft. from S. Line

____ Ft. from E. Line

1640 Ft. from W. Line

ABANDONED

Location

Rig up

Drilling and Remarks:

Top lime 1625'

Sand 1640-45'

Show oil

RECORD

Cased ____ in., ____ ft.

Sand

Gas

Oil

Total Depth 1647

PRODUCTION

1st 24 hrs. Nat.

1st 24 hrs. after shot

Gas Cu. Ft.

Dry Hole ✓

Abandoned ✓

Date

SEP 1 1 1929

19

CHAS. L. SHERWOOD

Scout