


Map No. _____ Sec. 23 Twp. 23 R. 13
 Well No. 8 Blue Babe Farm
Boorden Co Company

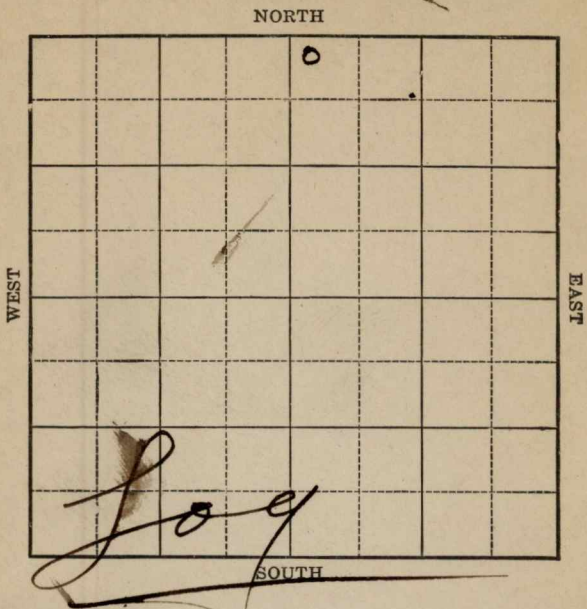

Location _____

Drilling Remarks:

Rig Up _____

Drilling Remarks:

RECORD

Cased _____ in. _____ ft.

Sand _____

Gas _____

Oil _____

Total Depth _____

PRODUCTION

1st 24 hrs. Nat. _____

1st 24 hrs. after shot _____

Gas _____ cu. ft.

Dry Hole _____

Abandoned _____

Map No. 75 Sec. 23 Twp. 23 R. 13

Well No. 8 Chris Baker Farm


Corden Company

200 Ft. from N. Line

_____ Ft. from S. Line

_____ Ft. from E. Line

300 Ft. from W. Line

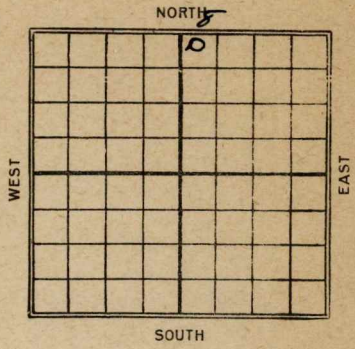

Date
1924
4/14
5/29

REPORT

Location
TD. 1793' - 25 Bbl

Map No. **KANSAS** Sec. 23 Twp. 23 R. 13

Well No. 8 Baker
Casden O & G Company

Contractor

FIRST REPORT

SECTION PLAT

200 Ft. from N. Line

----- Ft. from S. Line

----- Ft. from E. Line

200 Ft. from W. Line

		0	
		0	

Location -----

Rig up -----

Drilling and Remarks:

spud

RECORD

Cased ----- in., ----- ft.

Sand -----

Gas -----

Oil -----

Total Depth -----

PRODUCTION

1st 24 hrs. Nat. -----

1st 24 hrs. after shot -----

Gas ----- Cu. Ft.

Dry Hole -----

Abandoned -----

Date

MAY 22 1924

M. A. BENEAR

192

Scout

Map No. **KANSAS** Sec. 23 Twp. 23 R. 13
 Well No. 8 Baker
Cosden Oil & S. Company

Contractor

COMPLETED SECTION PLAT

200 Ft. from N. Line

_____ Ft. from S. Line

_____ Ft. from E. Line

200 Ft. from W. Line

		0	

Location _____

Rig up _____

Drilling and Remarks:

Tap L. 1760

Pay 1780 - 92

TD, 1793

50/30 Hb

RECORD

Cased _____ in., _____ ft.

Sand _____

Gas _____

Oil _____

Total Depth _____

PRODUCTION

1st 24 hrs. Nat. _____

1st 24 hrs. after shot _____

Gas _____ Cu. Ft.

Dry Hole _____

Abandoned _____

Date

M. A. BENEAR

JUL 9 1924

192

Scot