

KANSAS


FORM 51 5M PETROL

Woodson

Section 23 Township 23 Range 13E

Well No. #9 Chris Bahr #2

Company Mid-Continent Petroleum Corp.

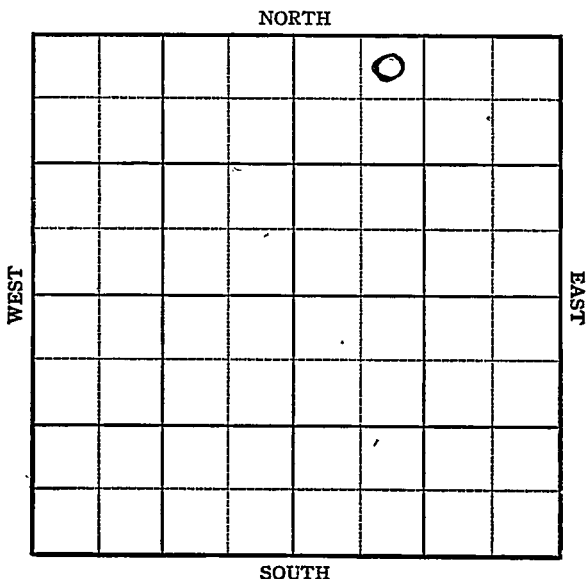

Sec. 23 Twp. 23-S R. 13-E

Well No. #9 Chris Bahr #2 Farm


Mid-Continent Petr. Corp. Company

330 Ft. from N. Line

 Ft. from S. Line

 Ft. from E. Line

990 Ft. from W. Line

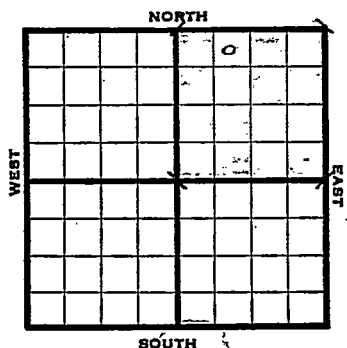

NE/4

1944

REPORT
No Elev. - 1944

3/30

Location Notice

4/5

"

4/19

"

5/1

Location

5/3

"

5/6

Rigging up

10" @ 30' TD 38 WOC Spud 5/6/44

5/12

Drilling 1300'

5/16

Top Mississippi 1730'
set casing at 1736 with 150 sacks

5/17

Bart. 1582
B. Bart 1650
Bottom 18' showing some saturation
Miss. 1730-40 T.D.
6-5/8" - 1736
RUST

5/24

"

5/31

"

6/7

TD 1766 SSO

OVER

1944

6/21

Miss 1730
6-5/8" @ 1736
T?D. 1766
2500 Acid
Pump 20 Pot
37.0 Gr.

COMPLETED


Pool Name Virgil

KANSAS
 Map No. 17 Sec. 23 Twp. 23 R. 13E

Well No. 9 Chris Bahr #2Mid-Continent Petroleum CompanyFIRST REPORT Contractor

NE NW NE

SECTION PLAT

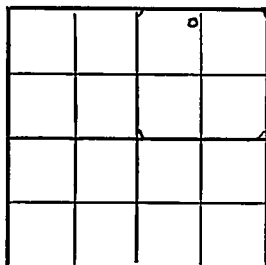330 Ft. from N. Line Ft. from S. Line Ft. from E. Line990 Ft. from W. LineWoodson CountyLocation XRig up

Drilling and Remarks:

RECORD

Cased in., ft.Sand Gas Oil Total Depth

PRODUCTION

1st 24 hrs. Nat. 1st 24 hrs. after shot Gas Cu. Ft.Dry Hole Abandoned

Date

APR 19 1944 19S I I FWIS Scout

KANSAS

FORM 20 200 BKS 1 44 PETROL

Pool Name VirgilMap No. 17 Sec. 23 Twp. 23 R. 13EWell No. 9 Chris Bahr #2

Mid-Continent Petroleum Company

COMPLETED

Contractor

NE NW NE

SECTION PLAT

330 Ft. from N. Line

Ft. from S. Line

Ft. from E. Line

990 Ft. from W. Line

		0	
			.

Woodson County

Location

Rig up

Drilling and Remarks:

*Mus 1730**6 5/8" @ 1736**2500 acia C**Pump 20 P & Y**1372 1/2*

RECORD

Cased _____ in., _____ ft.

Sand _____

Gas _____

Oil _____

Total Depth 1766

PRODUCTION

1st 24 hrs. Nat. _____

1st 24 hrs. after shot _____

Gas _____ Cu. Ft.

Dry Hole _____

Abandoned _____

Date

JUN 21 1944 19

S. J. LEWIS Scout