


KANSAS

FORM 51 25M 3-49 PETROL

Butler

Section 29 Township 23 Range 5-EWell No. #1 FannieCompany Rex & Morris

NORTH

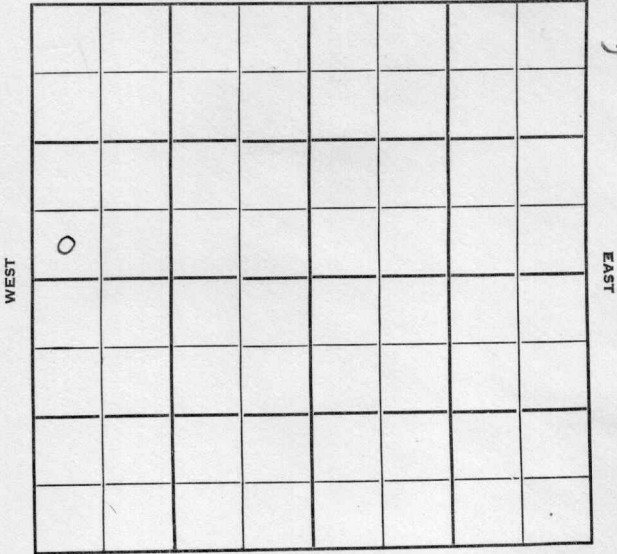

SOUTH

KANSAS

Butler

Sec. 29 Twp. 23 R. 5-E

Well No. #1 Fannie Farm

Rex & Morris Company

Hazlett, North Contractor


 Ft. from N. Line

330 Ft. from S. Line

 Ft. from E. Line

330 Ft. from W. Line

SW SW NW

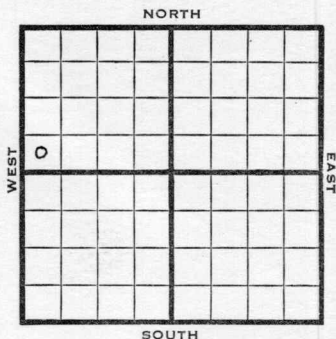

1950

Elev 1472

REPORT

7/19

RUR

8/16

15" @ 218

13" @ 710

10" @ 1270

KC 2075

7" @ 2450

TD 2477

Comp 35 bopd

Completed

COMPLETED


Chat 2453

Kansas

Map No. _____ Sec. 29 Twp. 23 R. 5EWell No. 1 Fannie_____
Rex & Morris Company_____
Contractor

SW SW NW

SECTION PLAT

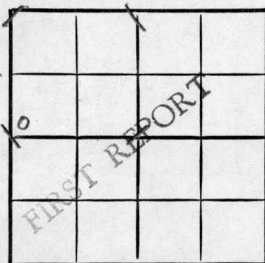_____
Ft. from N. Line330 Ft. from S. Line_____
Ft. from E. Line330 Ft. from W. Line

Butler County

Location _____

Rig up _____

Drilling and Remarks:

R U R

RECORD

Cased _____ in., _____ ft.

Sand _____

Gas _____

Oil _____

Total Depth _____

PRODUCTION

1st 24 hrs. Nat. _____

1st 24 hrs. after shot _____

Gas _____ Cu. Ft.

Dry Hole _____

Abandoned _____


Date

JUL 19 1950

19

J. E. TYRA

Scout

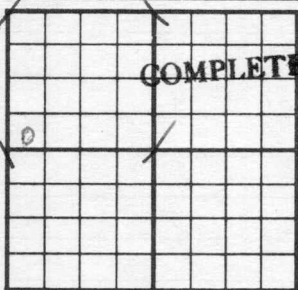County Butler State KansasSec. 29 (Blk.
Twp.) 23 (Sur.
Rge.) 5E Map No.Operator Rex & MorrisWell No. 1 Farm FannieElev. 1472 Location SW SW NW330 Ft. From S Line NW330 Ft. From W Line Quarter

1st. Report

Completion AUG 16 1950

Remarks

North Hazlett Pool

Spudding Date

Drlg. Data Oil well TD 247715" @ 218 13" @ 710 10" @ 1270KC 2075 Chat. 2453 7" @ 2450TD 2477 Comp. 35 bopd

J. E. TYRA