


Section 29 Township 23 Range 5-E

Well No. #1 Goering

Company K T Weidemann

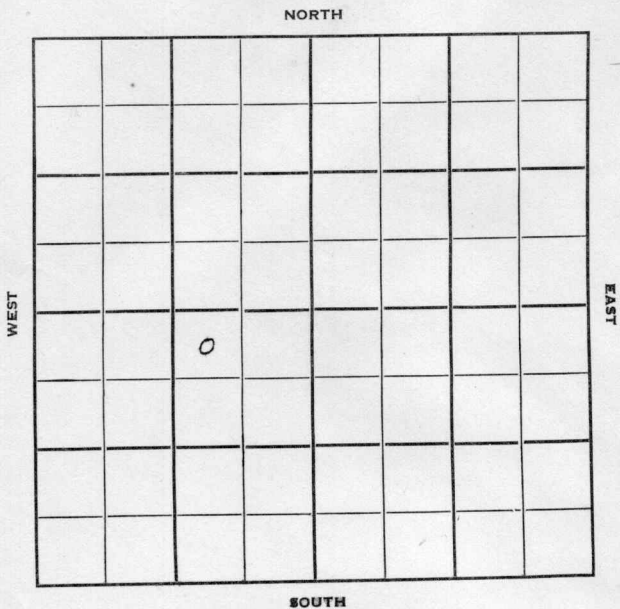

Butler

Sec. 29 Twp. 23 R. 5E ✓

Well No. #1 Goering Farm

K. T. Weidemann Company

Contractor

Miscellaneous


330' Ft. from N. Line

_____ Ft. from S. Line

990' Ft. from E. Line

_____ Ft. from W. Line

NW NE SW

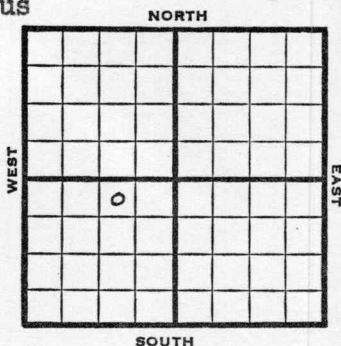

SOUTH

1950

Elev 1460 REPORT

9/20
11/29

Location

Spud 9-24-50

8" @ 122

Miss 2412-13

5" @ 2413

TD 2448

FU 294' fluid 50% wtr


PB 2436

Hydrafrac

Compl2 bopd

Completed

COMPLETED

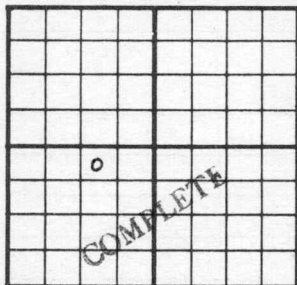County Butler State KansasSec. 29 (Blk.
Twp.) 23 (Sur.
Rge.) 5E Map No.Operator K. T. WeidemannWell No. 1 Farm GoeringElev. 1460 Location NW NE SW330 Ft. From N Line SW990 Ft. From E Line Quarter

1st. Report

Completion NOV 29 1950

Remarks

Spudding Date 9-24-50Drlg. Data Oil well TD 24488" @ 122 Miss. 2412-13 5" @ 2413TD 2448 FU 294' fluid 50% waterPB 2436 Hydrofrac Comp. 12 bopd

J. E. TYRA