


Section 29 Township 23 Range 5-E

Well No. #3 Fannie

Company Rex & Morris et al

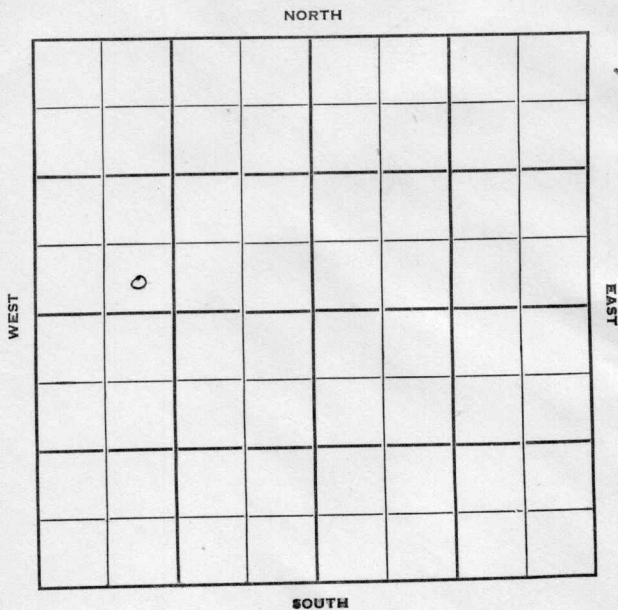

Butler
23

KANSAS
5E

Sec. 29 Twp. R. ☒

Well No. #3 Fannie Farm

Rex & Morris et al Company

Contractor

Miscellaneous


Ft. from N. Line

330' Ft. from S. Line

Ft. from E. Line

990' Ft. from W. Line

SE SW NW

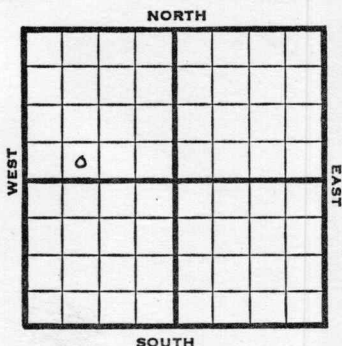

1950

Elev 1464

REPORT

9/20

RUR

10/25

Spud 9-22-50

15" @ 200

10" @ 754

Miss 2431

5" @ 2433

TD 2456

Comp 35 bopd

Completed

COMPLETED

County Butler State Kansas
 Sec. 29 (Blk.) 23 (Sur.) 5E Map No.
 Operator Rex & Morris et al.
 Well No. 3 Farm Fannie
 Elev. Location SE SW NW

0

FIRST REPORT

330 Ft. From S Line NW
990 Ft. From W Line Quarter

1st. Report SEP 20 1950

Completion

Remarks

Spudding Date

Drlg. Data

Miscellaneous

RUR

J. E. TYRA

