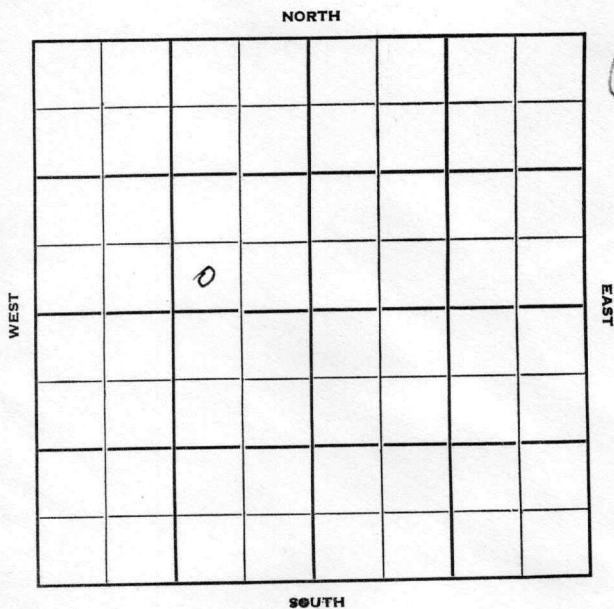


Section 29 Township 23 Range 5EWell No. #5 FannieCompany Rex & Morris

Butler

KANSAS

Sec. 29 Twp. 23 R. 5 E ✓

Well No. # 5 Fannie Farm

Rex & Morris Company

Contractor

Hazlett Pool


Ft. from N. Line

330 Ft. from S. Line

990 Ft. from E. Line

Ft. from W. Line

SW SE NW

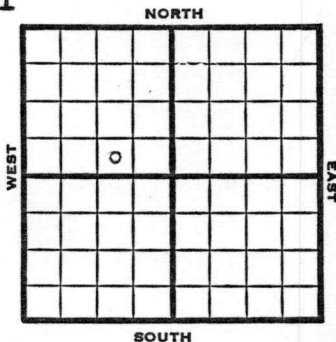

1951 Elev. 1455' REPORT

6/6 Location

7/11 Spud 6-17-51 Oil well TD 2447'
8" @ 90 Lans. 2046' Miss 2428'
5" @ 2428' TD 2447' FU 170' oil
overnite Hydrofrac
Comp. 40 BOPD

COMPLETED

County **Butler** State **Kansas**Sec. **29** (Blk.) **23** (Sur.) **5E** Map No.Operator **Rex & Morris**Well No. **5** Farm **Fannie**Elev. Location **SW SE NW**

0

FIRST REPORT


330 Ft. From **S** Line **NW****990** Ft. From **E** Line QuarterIst. Report **JUN 6 1951**

Completion

Remarks

Spudding Date

Drlg. Data **Hazlett Pool****Location****J. E. TYRA**

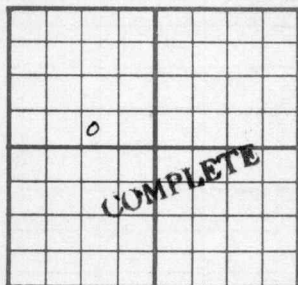County Butler State KansasSec. 29 (Blk.
Twp.) 23 (Sur.
Rge.) 5E Map No.Operator Rex & MorrisWell No. 5 Farm FannieElev. 1455 Location SW SE NW330Ft. From S Line NW990Ft. From E Line Quarter1st. ReportCompletion JUL 11 1951Remarks Hazlett PoolSpudding Date 6-17-51Drlg. Data Oil well TD 24478" @ 90 Lans. 2046 Miss. 24285" @ 2428 TD 2447 FU 170' oilovernite Hydrofrac Comp. 40 bopd

J. E. TYRA