


Section 30 Township 23 Range 5-EWell No. #3 FlickingerCompany Rex & MorrisMiscellaneous

NORTH

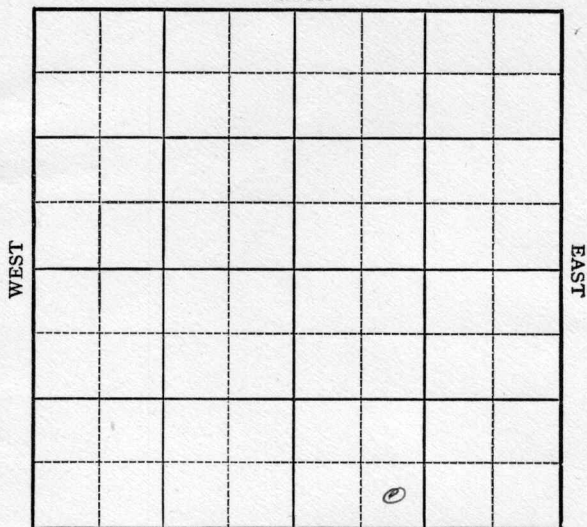

SOUTH

Sec. 30 Twp. 23 R. 5E

Well No. #3 Flickinger Farm

Rex & Morris Company

Rex & Morris Contractor

Miscellaneous


Ft. from N. Line

330' Ft. from S. Line

Ft. from E. Line

990' Ft. from W. Line

SE SW SE

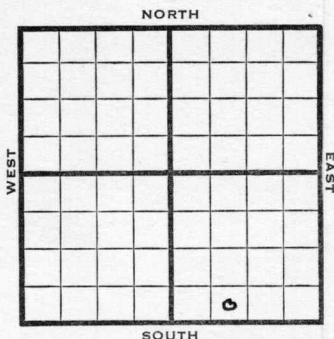

1949 Elev. 1462' REPORT

11/9 Location

11/16 Mach

11/23 15" @ 202'
Drlg. 440'

11/29 13" @ 720'
Drlg 1287'

12/7 8" @ 1840'
Drlg 2350'

12/14 Miss. 2435'
5" @ 2459'
Pump 35 Oil Pot.
TD 2484'
Gr. 38°

COMPLETED

Map No. _____ Sec. 30 Twp. 23 R. 5E

Well No. 3 Flickinger

Rex & Morris Company

Rex & Morris Contractor

SE SW SE


FIRST REPORT
SECTION PLAT

_____ Ft. from N. Line

330 Ft. from S. Line

_____ Ft. from E. Line

990 Ft. from W. Line

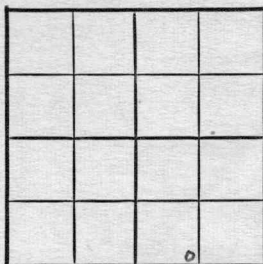

Butler County

Location X

Rig up _____

Drilling and Remarks:

RECORD

Cased _____ in., _____ ft.

Sand _____

Gas _____

Oil _____

Total Depth _____

PRODUCTION

1st 24 hrs. Nat. _____

1st 24 hrs. after shot _____

Gas _____ Cu. Ft.

Dry Hole _____

Abandoned _____

Date

NOV 9 1949

19

S. J. LEWIS

Scout


Kansas

Map No. _____ Sec. 30 Twp. 23 R. 5EWell No. 3 FlickingerRex & Morris

Company

COMPLETE

Contractor

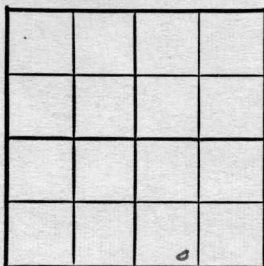SE SW SEE 11462
SECTION PLAT Ft. from N. Line330 Ft. from S. Line Ft. from E. Line990 Ft. from W. LineButler County

Location _____

Rig up _____

Drilling and Remarks:

Misc 24355' @ 2439.Open soil88-6

RECORD

Cased _____ in., _____ ft.

Sand _____

Gas _____

Oil _____

Total Depth 2484

PRODUCTION

1st 24 hrs. Nat. _____

1st 24 hrs. after shot _____

Gas _____ Cu. Ft.

Dry Hole _____

Abandoned _____

Date

DEC 14 1949 19S. J. LEWIS

Scout