FORM 51 10M 2-49 PETROL

KANSAS

Burtler


Section 30 Township 23 Range 5-E

Well No. #2 Flickinger

Company Rex & Morris

Miscellaneous

15

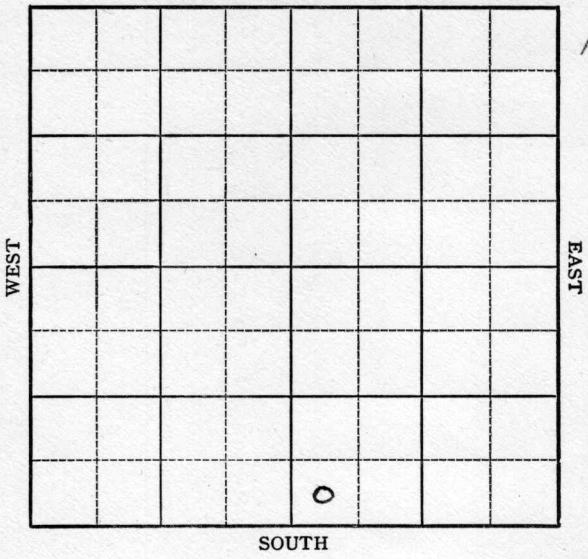

FORM 252-A
5M 10-48 PETROL

KANSAS Butler

Sec. 30 Twp. 23 R. 5E

Well No. 2 Flickinger Farm

Rex & Morris Company

Misc.


_____ Ft. from N. Line

330 Ft. from S. Line

_____ Ft. from E. Line

330 Ft. from W. Line

SW SE

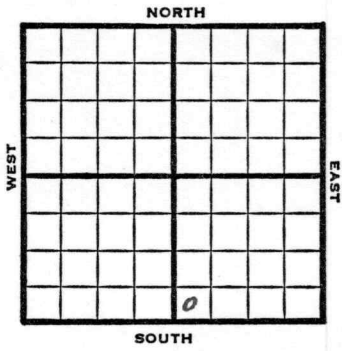

1949	Elev 1464' REPORT
8/24	Spud
8/31	15"@ 155' 12"@ 750' Drlg 860'
9/7	10" @ 1300' 8" @ 1800' Drlg. 1830'
9/14	7"@ 2454' Mississippi 2455' Drlg 2472'
9/21	TD 2477' Miss 2455' 8"@ 2458' Pump 30 oil Pot 38° Gr. Comp
	COMPLETED

Form 26 200 Bks. 6-49 Petrol

Miscellaneous

Kansas

Map No. _____ Sec. 30 Twp. 23 R. 5E

Well No. 2 Flickinger


Rex & Morris Company

Contractor

SW SE

FIRST REPORT

SECTION PLAT

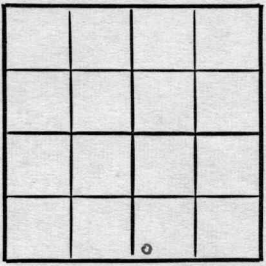

_____ Ft. from N. Line

330 Ft. from S. Line

_____ Ft. from E. Line

330 Ft. from W. Line

Butler County

Location _____

Rig up _____

Drilling and Remarks:

Spud

RECORD

Cased _____ in., _____ ft.

Sand _____

Gas _____

Oil _____

Total Depth _____

PRODUCTION

1st 24 hrs. Nat. _____

1st 24 hrs. after shot _____

Gas _____ Cu. Ft.

Dry Hole _____

Abandoned _____

Date

AUG 24 1949 19 S. J. LEWIS Scout

Form 26 200 Bks. 6-49 Petrol

Miscellaneous

Kansas

Map No. K14 Sec. 30 Twp. 23 R. 5E

Well No. 2 Flickinger


Rex & Morris Company

COMPLETE Contractor

SW SE

E 1,1464

SECTION PLAT

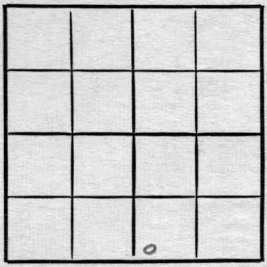

____ Ft. from N. Line

330 Ft. from S. Line

____ Ft. from E. Line

330 Ft. from W. Line

Butler County

Location

Rig up

Drilling and Remarks:

Wait 24hrs
8" @ 2455'.
Pump 30 oil Bbls

58°-4

RECORD

Cased ____ in., ____ ft.

Sand

Gas

Oil

Total Depth 2477

PRODUCTION

1st 24 hrs. Nat.

1st 24 hrs. after shot

Gas ____ Cu. Ft.

Dry Hole

Abandoned

Date

SEP 21 1949 19

S. J. LEWIS Scout