

KANSAS Butler

Section 30 Township 23 Range 5-E

Well No. #4 Flickinger

Company Rex & Morris

Miscellaneous

NORTH

WEST

EAST

SOUTH

10

0

Butler

KANSAS

Sec. 30 Twp. 23 R. 5E

Well No. #4 Flickinger Farm

Rex & Morris

Company


Miscellaneous (Rex & Morris, Contr.)

990' Ft. from N. Line

 Ft. from S. Line

 Ft. from E. Line

330' Ft. from W. Line

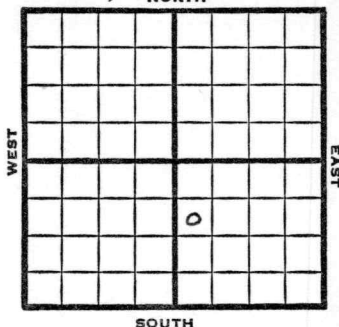

SW NW SE

1949 Elev. 1460' REPORT

11/23 Spud
11/29 15"@ 210'
13"@ 712'
Drlg 850'
12/7 10"@ 1250'
Drlg 1420'
12/14 Drlg. 2360'
12/28 Miss 2465'
7" @ 2435'
Pump 25 oil & W Pot.
Gr. 38°
TD 2483'

COMPLETED

Map No. _____ Sec. 30 Twp. 23 R. 5E

Well No. 4 Flickinger

Rex & Morris Company

Rex & Morris Contractor

SW NW SE


**FIRST REPORT
SECTION PLAT**

990 Ft. from N. Line

_____ Ft. from S. Line

_____ Ft. from E. Line

330 Ft. from W. Line

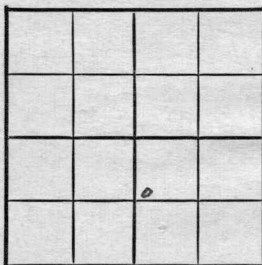

Butler County

Location _____

Rig up _____

Drilling and Remarks:

Spud

RECORD

Cased _____ in., _____ ft.

Sand _____

Gas _____

Oil _____

Total Depth _____

PRODUCTION

1st 24 hrs. Nat. _____

1st 24 hrs. after shot _____

Gas _____ Cu. Ft.

Dry Hole _____

Abandoned _____

Date

NOV 23 1949 19

S. J. LEWIS Scout

Map No. _____ Sec. 30 Twp. 23 R. 5EWell No. 4 Flickinger

Rex & Morris

Company

COMPLETE


Contractor

SW NW SE

E 1/4 60
SECTION PLAT990 Ft. from N. Line

_____ Ft. from S. Line

_____ Ft. from E. Line

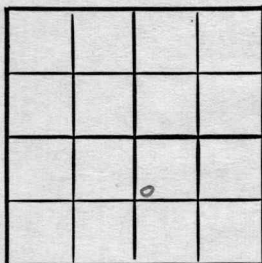330 Ft. from W. Line

Butler County

Location _____

Rig up _____

Drilling and Remarks:

*Misc 2465**7" C 2435**Prod 25 oil 7 1/2*
*BD**35 1/2*

RECORD

Cased _____ in., _____ ft.

Sand _____

Gas _____

Oil _____

Total Depth 2483

PRODUCTION

1st 24 hrs. Nat. _____

1st 24 hrs. after shot _____

Gas _____ Cu. Ft.

Dry Hole _____

Abandoned _____

Date

DEC 28 1949

19

S. J. LEWIS

Scout