


Section 30 Township 23 Range 5E

Well No. #6 Flickinger

Company Rex & Morris

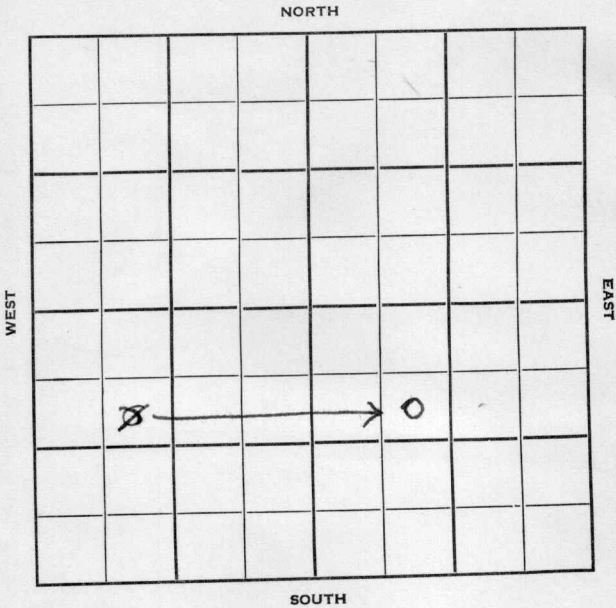

10

Butler

KANSAS

Sec. 30 Twp. 23 R. 5E

Well No. #6 Flickinger Farm

Rex & Morris

Company


Hazlett North

990' Ft. from N. Line

 Ft. from S. Line

 Ft. from E. Line

990' Ft. from W. Line

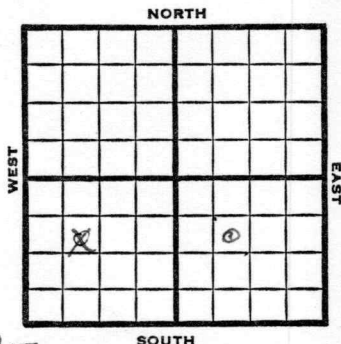

~~SE NW SW~~ SE NW SE

1950

Elev 1464'

REPORT

1/18

RUR

2/15

TD 2477'

13" @ 708'

10" @ 1215'

8" @ 2110'

7" @ 2442'

Chat 2460'

35 BOPD

Comp

COMPLETED

Kansas

Map No. _____ Sec. 30 Twp. 23 R. 5EWell No. 6 FlickingerRex & Morris Company

Contractor

SE NW SW

SECTION PLAT

990 Ft. from N. Line

_____ Ft. from S. Line

_____ Ft. from E. Line

990 Ft. from W. Line

FIRST REPORT			
o			

Butler County

Location _____

Rig up _____

Drilling and Remarks:

R U R

RECORD

Cased _____ in., _____ ft.

Sand _____

Gas _____

Oil _____

Total Depth _____

PRODUCTION

1st 24 hrs. Nat. _____

1st 24 hrs. after shot _____

Gas _____ Cu. Ft.

Dry Hole _____

Abandoned _____

Date

JAN 18 1950

19

J. E. TYRA

Scout

Map No. _____ Sec. 30 Twp. 23 R. 5EWell No. 6 Flickinger_____
Rex & Morris Company

CORRECTION

Contractor

SE NW SE

El. 1464

SECTION PLAT

990 Ft. from N. Line

_____ Ft. from S. Line

_____ Ft. from E. Line

990 Ft. from W. Line

		0	

Butler County

Location _____

Rig up _____

Drilling and Remarks:

Reported

SE NW SW

RECORD

Cased _____ in., _____ ft.

Sand _____

Gas _____

Oil _____

Total Depth _____

PRODUCTION

1st 24 hrs. Nat. _____

1st 24 hrs. after shot _____

Gas _____ Cu. Ft.

Dry Hole _____

Abandoned _____

Date

JAN 25 1950 19

J. E. TYRA

Scout

Map No. _____ Sec. 30 Twp. 23 R. 5EWell No. 6 FlickingerRex & Morris

Company


Contractor

SE NW SE

El. 1464
SECTION PLAT990 Ft. from N. Line

_____ Ft. from S. Line

_____ Ft. from E. Line

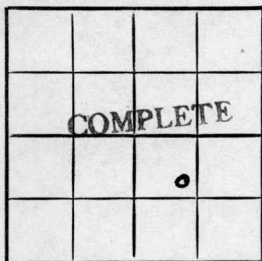990 Ft. from W. Line

Butler County

Location _____

Rig up _____

Drilling and Remarks:

13" @ 70810" @ 12158" @ 21107' @ 2442Chat 246035 BOPD

RECORD

Cased _____ in., _____ ft.

Sand _____

Gas _____

Oil _____

Total Depth 2477

PRODUCTION

1st 24 hrs. Nat. _____

1st 24 hrs. after shot _____

Gas _____ Cu. Ft.

Dry Hole _____

Abandoned _____

Date

FEB 15 1950

19

J. E. TYRA

Scout