

FORM 51 25M 3-49 PETROL

Section 30 Township 23 Range 5-EWell No. #3 GehringCompany Rex & Morris

NORTH

							0

SOUTH

WEST

EAST

16

Butler
23

KANSAS

5E

30

Sec. _____ Twp. _____ R. _____

#3 Gehring

Well No. _____ Farm _____

Rex & Morris

Company _____

Miscellaneous

Contractor _____

_____ Ft. from N. Line

330'


_____ Ft. from S. Line

330'

_____ Ft. from E. Line

_____ Ft. from W. Line

SE SE SE

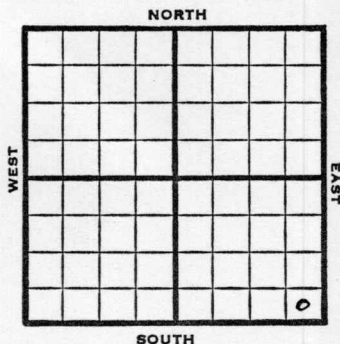

1950

Lev. 1473'

REPORT

5/10

MIR

6/7

15" @ 200'

13" @ 715'

10" @ 1240'

8" @ 1757'

Lans. 1810'

KC 2085'

Congl 2430'

Chat 2447'

7" @ 2450'

35 BOPD

TD 2472

COMPLETED

Map No. _____ Sec. 30 Twp. 23 R. 5EWell No. 3 GehringRex & Morris Company

Contractor

SE SE SE

SECTION PLAT

_____ Ft. from N. Line

330 Ft. from S. Line330 Ft. from E. Line

_____ Ft. from W. Line



Butler

Location _____

Rig up _____

Drilling and Remarks:

Min.

RECORD

Cased _____ in., _____ ft.

Sand _____

Gas _____

Oil _____

Total Depth _____

PRODUCTION

1st 24 hrs. Nat. _____

1st 24 hrs. after shot _____

Gas _____ Cu. Ft.

Dry Hole _____

Abandoned _____

Date

MAY 10 1950

19

J. E. TYRA

Scout

Map No. _____ Sec. 30 Twp. 23 R. 5E

Well No. 3 Gehring

Rex & Morris _____ Company

_____ Contractor

SE SE SE

E1.1473
SECTION PLAT

_____ Ft. from N. Line

330 Ft. from S. Line

330 Ft. from E. Line

_____ Ft. from W. Line



Butler

Location _____

Rig up _____

Drilling and Remarks:

15" @ 200
 13" @ 715
 10" @ 1240
 8" @ 1757
 Lams 1810
 KC 2085

RECORD

Cased _____ in., _____ ft.

Sand _____

Gas _____

Oil _____

Total Depth 2472

PRODUCTION

1st 24 hrs. Nat. _____

1st 24 hrs. after shot _____

Gas _____ Cu. Ft.

Dry Hole _____

Abandoned _____

Cong 2430, Chat 2447,

Date 7" @ 2450 35 BOPD.

JUN 7 1950 19 J. E. TYRA Scout