

KANSAS

Butler

Section 30 Township 23 Range 5-EWell No. #5 GehringCompany Rex & Morris

NORTH

							Q

SOUTH

WEST

EAST

9

Bulter

KANSAS

5E ✓

Sec. 30 Twp. 23 R. 5E

Well No. #5 Gehring Farm

Rex & Morris

Company

Hazlett, North

Contractor


330' Ft. from N. Line

Ft. from S. Line

330' Ft. from E. Line

Ft. from W. Line

NE NE SE

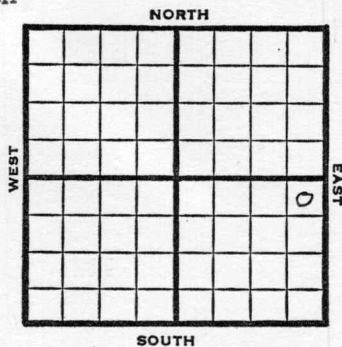

1950

Elev 1474

REPORT

6/21

Rig up

7/19

15 1/2" @ 218

13" @ 715

10" @ 1270

Miss 2465

7" @ 2468

T^D 2488

Comp 35 wopd

Completed

COMPLETED

Map No. _____ Sec. 30 Twp. 23 R. 5EWell No. 5 GehringRex & Morris Company

Contractor

NE NE SE

SECTION PLAT

330 Ft. from N. Line

_____ Ft. from S. Line

330 Ft. from E. Line

_____ Ft. from W. Line



Butler County

Location _____

Rig up X

Drilling and Remarks:

RECORD

Cased _____ in., _____ ft.

Sand _____

Gas _____

Oil _____

Total Depth _____

PRODUCTION

1st 24 hrs. Nat. _____

1st 24 hrs. after shot _____

Gas _____ Cu. Ft.

Dry Hole _____

Abandoned _____

Date

JUN 21 1950 19J. E. TYRA Scout

~~Kansas~~

Hazlett, North

Map No. _____ Sec. 30 Twp. 23 R. 5EWell No. 5 GehringRex & Morris

Company

Contractor

NE NE SE

E1. 1474
SECTION PLAT330


Ft. from N. Line

Ft. from S. Line

330

Ft. from E. Line

Ft. from W. Line

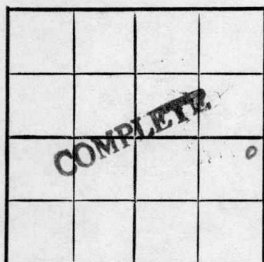

Butler County

Location _____

Rig up _____

Drilling and Remarks:

15½" @ 21813" @ 71510" @ 1270~~MISS. 2465~~Miss. 24657" @ 2468TD 2488

RECORD

Cased _____ in., _____ ft.

Sand _____

Gas _____

Oil _____

Total Depth 2488

PRODUCTION

1st 24 hrs. Nat. _____

1st 24 hrs. after shot _____

Gas _____ Cu. Ft.

Dry Hole _____

Abandoned _____

Comp. 35 bopd

Date

JUL 19 1950