

Section 31 Township 23 Range 5E

Well No. 1 Clearwater

Company Rex & Morris  
Misc.

NORTH

WEST

EAST

SOUTH

|  |  |   |  |  |  |  |  |
|--|--|---|--|--|--|--|--|
|  |  | 0 |  |  |  |  |  |
|  |  |   |  |  |  |  |  |
|  |  |   |  |  |  |  |  |
3

KANSAS

Butler

Sec. 31 Twp. 23 R. 5E ✓

Well No. #1 Clearwater Farm

Rex & Morris

Company

Miscellaneous (Rex & Morris, Cont.)

NORTH


330' Ft. from N. Line

Ft. from S. Line

990' Ft. from E. Line

Ft. from W. Line

NW NE NW

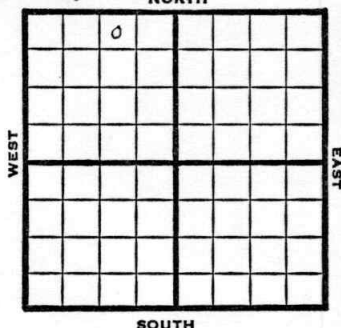

1949

Elev. 1448'

REPORT

6/22

15" @ 150'

Drlg. 200'

6/28

12" @ 685'

10" @ 1283'

Drlg. 1710'

7/6

8" @ 2010

Drlg 2045'

7/12

7" @ 2429'

TD 2438'

7/20

Complete

Chat 2449'

7" @ 2429'

Pump 35 oil Pot

38 Grav

TD 2466'

COMPLETED

Map No. \_\_\_\_\_ Sec. 31 Twp. 23 R. 5E

Well No. 1 Clearwater

Rex & Morris Company

Rex & Morris Contractor

NW NE NW


FIRST REPORT  
SECTION PLAT

330 Ft. from N. Line

\_\_\_\_\_ Ft. from S. Line

990 Ft. from E. Line

\_\_\_\_\_ Ft. from W. Line

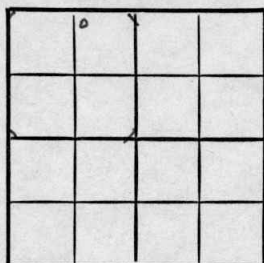

Butler County

Location \_\_\_\_\_

Rig up \_\_\_\_\_

Drilling and Remarks:

15" @ 150

drlg. 200

RECORD

Cased \_\_\_\_\_ in., \_\_\_\_\_ ft.

Sand \_\_\_\_\_

Gas \_\_\_\_\_

Oil \_\_\_\_\_

Total Depth \_\_\_\_\_

PRODUCTION

1st 24 hrs. Nat. \_\_\_\_\_

1st 24 hrs. after shot \_\_\_\_\_

Gas \_\_\_\_\_ Cu. Ft.

Dry Hole \_\_\_\_\_

Abandoned \_\_\_\_\_

Date

JUN 22 1949

19

S. J. LEWIS

Scout

Kansas

Miscellaneous

Map No. K14 Sec. 31 Twp. 23 R. 5EWell No. 1 Clearwater

Rex &amp; Morris

Company

COMPLETE

Contractor

NW NE NW

SECTION PLAT

330 Ft. from N. Line

Ft. from S. Line

990 Ft. from E. Line

Ft. from W. Line

Butler County

|  |   |  |  |
|--|---|--|--|
|  | 6 |  |  |
|  |   |  |  |
|  |   |  |  |
|  |   |  |  |
|  |   |  |  |

Location

Rig up

Drilling and Remarks:

*Cha 42449**7" 32429**Prod 35 oil 1948**38-1/2*

## RECORD

Cased \_\_\_\_\_ in., \_\_\_\_\_ ft.

Sand \_\_\_\_\_

Gas \_\_\_\_\_

Oil \_\_\_\_\_

Total Depth 2466

## PRODUCTION

1st 24 hrs. Nat. \_\_\_\_\_

1st 24 hrs. after shot \_\_\_\_\_

Gas \_\_\_\_\_ Cu. Ft.

Dry Hole \_\_\_\_\_

Abandoned \_\_\_\_\_

Date

JUL 20 1949

19

S. J. LEWIS

Scout