


Section 30 Township 23 Range 5-E

Well No. #6 Gehring

Company Rex & Morris

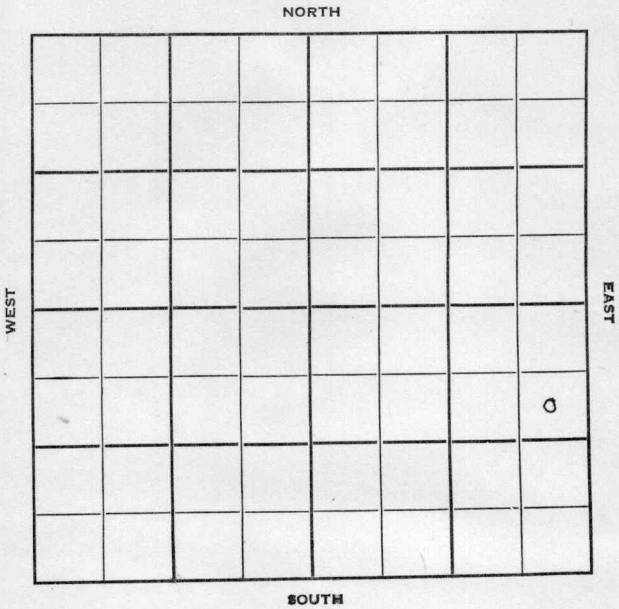

Sec. 30 Twp. 23 R. 5E ✓

Well No. #6 Gehring Farm

Rex & Morris Company

Contractor


990' Ft. from N. Line

_____ Ft. from S. Line

330' Ft. from E. Line

_____ Ft. from W. Line

SE NE SE

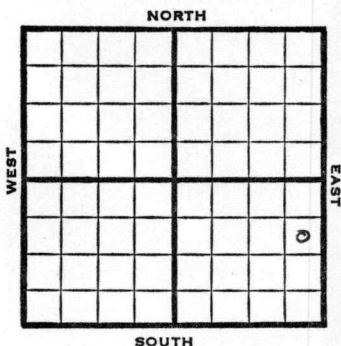

SOUTH

1950

Elev 1471

REPORT

7/5 Rig up

7/26 15" @ 210
12" @ 730
10" @ 1230
8" @ 1870
Chat 2459
7" @ 2462-83 TD
Comp 35 bopd
TD 2483
Completed

COMPLETED

Map No. _____ Sec. 30 Twp. 23 R. 5EWell No. 6 Gehring_____
Rex & Morris Company_____
Contractor

SE NE SE

SECTION PLAT

990 Ft. from N. Line

_____ Ft. from S. Line

330 Ft. from E. Line

_____ Ft. from W. Line

Butler County

Location _____

Rig up x

Drilling and Remarks:

RECORD

Cased _____ in., _____ ft.

Sand _____

Gas _____

Oil _____

Total Depth _____

PRODUCTION

1st 24 hrs. Nat. _____

1st 24 hrs. after shot _____

Gas _____ Cu. Ft.

Dry Hole _____

Abandoned _____

Date

JUL 5 1950 19J. E. TYRA

Scout

Kansas

Map No. _____ Sec. 30 Twp. 23 R. 5EWell No. 6 GehringRex & Morris

Company

Contractor

SE NE SE

El. 1471


SECTION PLAT

990 Ft. from N. Line

_____ Ft. from S. Line

330 Ft. from E. Line

_____ Ft. from W. Line

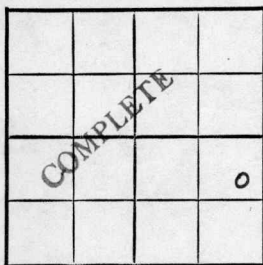

Butler County

Location _____

Rig up _____

Drilling and Remarks:

15" @ 210

12" @ 730

10" @ 1230

8" @ 1870

Chat 2459

7" @ 2462-83 TD

Comp. 35 bopd

RECORD

Cased _____ in., _____ ft.

Sand _____

Gas _____

Oil _____

Total Depth 2483

PRODUCTION

1st 24 hrs. Nat. _____

1st 24 hrs. after shot _____

Gas _____ Cu. Ft.

Dry Hole _____

Abandoned _____

Date

JUL 26 1950

19

J. E. TYRA

Scout