


Ellis
 Carmichael
 Farm
 Dickey Oil Co.
 County No. 7 "C"
 Company
 Sec. Twp.
 11 S 17 W
 17
 Township
 Section
 Elev. _____ TD. 3373
 Date Drilled 8/29/41
 Correlation by
 Prod. Pat. 5483 B.

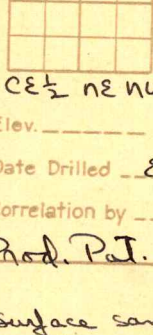

6	5	4	3	2	1
7	8	9	10	11	12
13	14	15	16	17	18
19	20	21	22	23	24
25	26	27	28	29	30
31	32	33	34	35	36


CE 1/2 NE NW

Elev. _____ TD. 3373

Date Drilled 8/29/41

Correlation by

Prod. Pat. 5483 B.

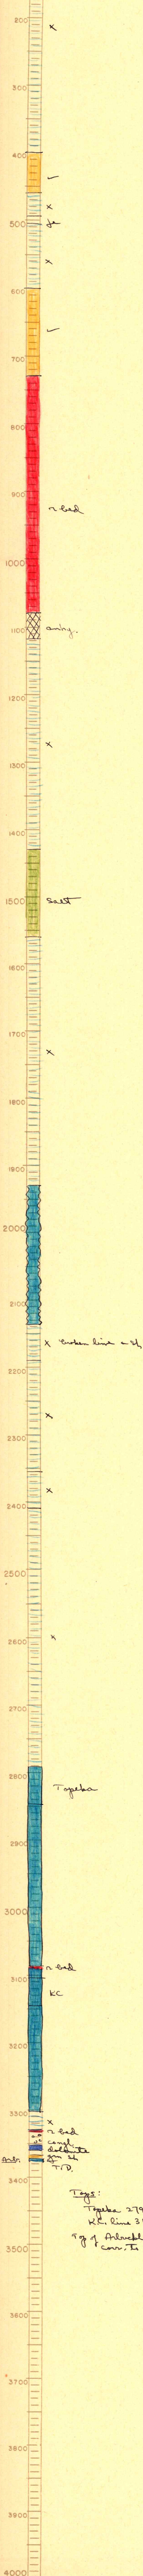

Tops:
 Topoka 2792
 K.C. line 3105
 Top of Arkville
 corr. to 3369 DF