
Butler KANSAS

FORM 51 25M 3-49 PETROL

Section 31 Township 23 Range 5E

Well No. #4 Clearwater

Company Rex & Morris

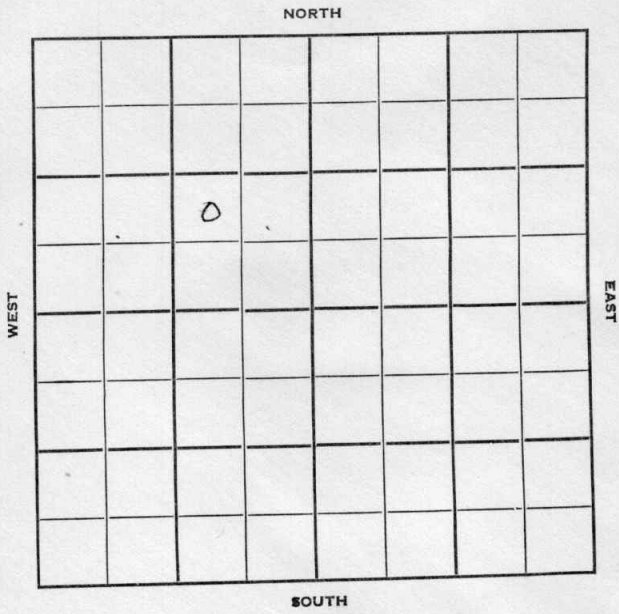

6

FORM 252-B
10M 9-49 PETROL

Butler KANSAS

Sec. 31 Twp. 23 R. 5E ✓

Well No. #4 Clearwater Farm

Rex & Morris Company

Contractor

Miscellaneous


Ft. from N. Line

990' Ft. from S. Line

990' Ft. from E. Line

Ft. from W. Line

NW SE NW

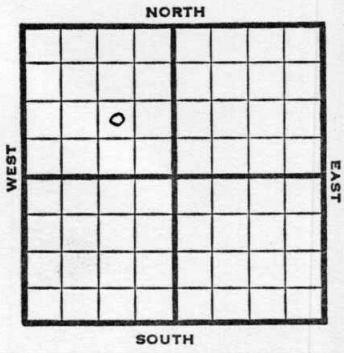

1950	REPORT
	Elev 1449'
4/12	RUR
5/10	TD 2475' 12"@ 730' 10"@ 1275' Lans 1810' 8"@ 1839' Cong Sd 2430' Chat 2458' 7"@ 2460' 35 BOPD Comp COMPLETED

Form 26 200 Bks. 11-49 Petrol

Kansas Miscellaneous

Map No. _____ Sec. 31 Twp. 23 R. 5E


Well No. 4 Clearwater

Rex & Morris Company

Contractor

NW SE NW

SECTION PLAT

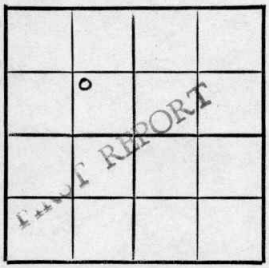

_____ Ft. from N. Line

990 Ft. from S. Line

990 Ft. from E. Line

_____ Ft. from W. Line

Butler County

Location _____

Rig up _____

Drilling and Remarks:

R U R

RECORD

Cased _____ in., _____ ft.

Sand _____

Gas _____

Oil _____

Total Depth _____

PRODUCTION

1st 24 hrs. Nat. _____

1st 24 hrs. after shot _____

Gas _____ Cu. Ft.

Dry Hole _____

Abandoned _____

Date

APR 12 1950 19 J. E. TYRA Scout

Form 26 200 Bks. 11-49 Petrol

Miscellaneous

Kansas

Map No. _____ Sec. 31 Twp. 23 R. 5E

Well No. 4 Clearwater

Rex & Morris Company

Contractor

El. 1449

NW SE NW


SECTION PLAT

_____ Ft. from N. Line

990 Ft. from S. Line

990 Ft. from E. Line

_____ Ft. from W. Line

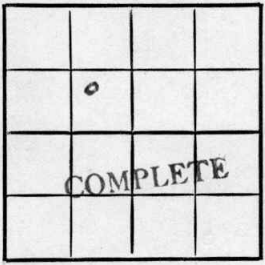

Butler

Location _____

Rig up _____

Drilling and Remarks:

12" @ 730
10" @ 1275
Lans 1810
8" @ 1839
cong sd 2430
chat 2458
7" @ 2460
35 BOPD

RECORD

Cased _____ in., _____ ft.

Sand _____

Gas _____

Oil _____

Total Depth 2475

PRODUCTION

1st 24 hrs. Nat. _____

1st 24 hrs. after shot _____

Gas _____ Cu. Ft.

Dry Hole _____

Abandoned _____

Date

MAY 10 1950

19 _____

J. E. TYRA Scout