



Range 15 Township 11 Section 16
 County Russell No. 1 "B"
 L. M. Hines Farm
 C. Ernest Liggett Oil Co.
 Elev. 1944 T.D. 3453
 Date Drilled 7-5-41
 Correlation by _____
 Prod. Pat. 137 B

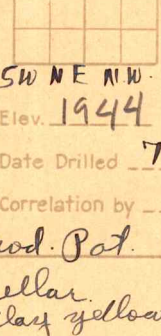

6	5	4	3	2	1
7	8	9	10	11	12
18	17	16	15	14	13
19	20	21	22	23	24
30	29	28	27	26	25
31	32	33	34	35	36

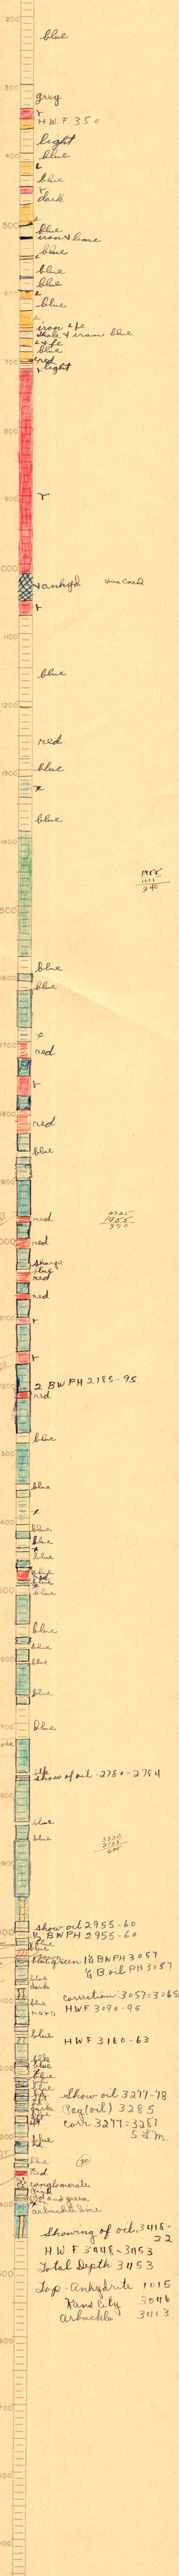

1958
 1015
 940

2225
 1955
 270

3330
 2725
 605

