


Russell

Form 51—5M—11-38—Palace

Section 36 Township 15 Range 14-W

Well No. 9 Deines

Company Coralena
Trapp Pool

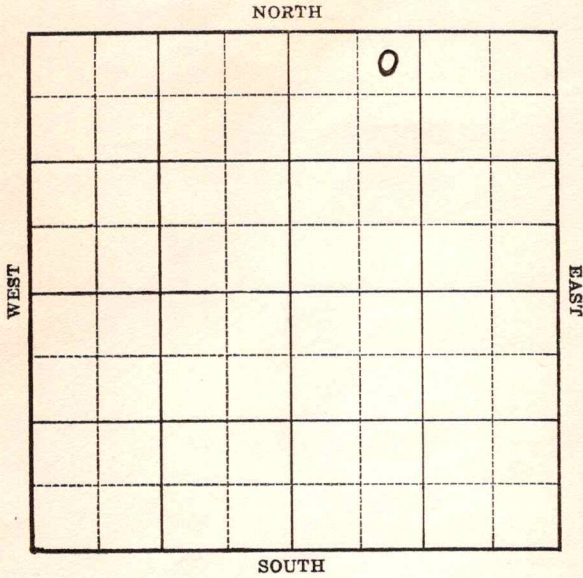

KANSAS

Russell

Sec. 36 Twp. 15 R. 14-W

Well No. #9 Deines Farm

Coralena _____ Company


(Trapp)

330 Ft. from N. Line

Ft. from S. Line

Ft. from E. Line

990 Ft. from W. Line

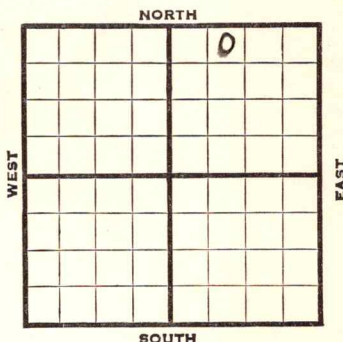

1939	REPORT
4/5	S. H.
4/14	10" - 245' Drlg. 2045'
4/21	Lans. 3045' Arb. 3282'
	T. D. 3286' S. O. 7" - 3282'
	RUST.
4/28	"
5/3	Arb. 3282'
	7" - 3282'
	T. D. 3296'
	Depthograph potential 2259 bbls.
	COMPLETED

Russell

KANSAS

Map No. 73 Sec. 36 Twp. 15 R. 14WWell No. 9 DeinesCoralena

Company

Contractor

FIRST REPORT

NE NW NE

330 Ft. from N. Line

Ft. from S. Line

Ft. from E. Line

990 Ft. from W. Line

TRAPP POOL

SECTION PLAT

		0	

Location

Rig up

Drilling and Remarks:

SH

RECORD

Cased _____ in., _____ ft.

Sand _____

Gas _____

Oil _____

Total Depth _____

PRODUCTION

1st 24 hrs. Nat. _____

1st 24 hrs. after shot _____

Gas _____ Cu. Ft.

Dry Hole _____

Abandoned _____

Date

APR 5 - 1938

19

H. D. Hatfield Scout

Russell **KANSAS**Map No. 73 Sec. 36 Twp. 15 R. 14 WWell No. 9 HeinesCoralena Company

Contractor

Trapp Pool

SECTION PLAT

		o	

330 Ft. from N. Line

_____ Ft. from S. Line

_____ Ft. from E. Line

990 Ft. from W. Line

COMPLETE

Location _____

Rig up _____

Drilling and Remarks:

Cr. 32827" @ 3282Depthograph Pool
2259

RECORD

Cased _____ in., _____ ft.

Sand _____

Gas _____

Oil _____

Total Depth 3296

PRODUCTION

1st 24 hrs. Nat. _____

1st 24 hrs. after shot _____

Gas _____ Cu. Ft.

Dry Hole _____

Abandoned _____

Date

MAY 3 1939

S. J. LEWIS

Scout