


Section 4 Township 18 Range 25 W

Well No. # 1 Reed "K"

Company Magnolia Pet.

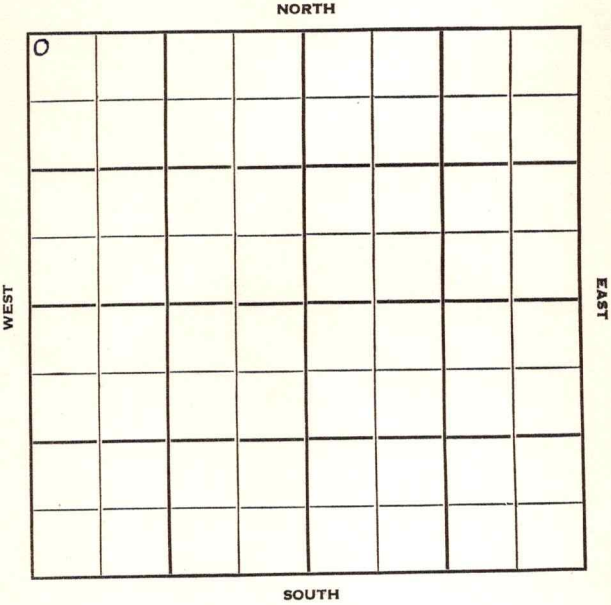

Ness

KANSAS

Sec. 4 Twp. 18 R. 25 W

Well No. # 1 Reed "K" Farm

Magnolia Pet. Company

Contractor

Aldridge Pool


160 Ft. from N. Line

Ft. from S. Line

Ft. from E. Line

160 Ft. from W. Line

NW NW NW

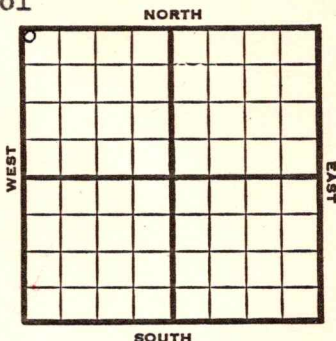

1951

Elev. 2372' REPORT

5/2

Location

6/20

Comm. 5-5-51

Oil Well TD 4303

8" @ 657

Lans. 3712

DST 4184-92 opn 1 hr Rec. 120' oil
30' mud

Miss 4270

5" @ 4271

TD 4294

B/5 boph 500 A 7 go 12 gwph

DD 4303 B/20 goph 500 A

B/20 goph 7 gwph CO to 4302

1000 A S/23 bo 15 bw 13 hr.

Comp. 43 bo 18 bwpd

COMPLETED

County **Ness** State **Kansas**Sec. **4** (Blk.) **18** (Sur.) **25W** Map No.Operator **Magnolia Pet.**Well No. **1** Farm **Reed "K"**Elev. Location **NW NW NW**

o					

160 Ft. From **N** Line **NW****160** Ft. From **W** Line Quarter1st. Report **MAY 2 1951**

Completion

Remarks

Spudding Date

Drlg. Data **Aldridge Pool**

Location

County	Ness			State	Kansas	
Sec.	4	(Blk.) Twp.)	18	(Sur.) Rge.)	25W	Map No.
Operator	Magnolia Pet.					
Well No.	1	Farm	Reed "K"			
Elev.	2372	Location	NW NW NW			
COMPLETE	160		Ft. From	N	Line	NW
	160		Ft. From	W	Line	Quarter
	1st. Report					
	Completion JUN 20 1951					
	Remarks Aldridge Pool					
Spudding Date 5-5-51						
Drilg. Data	Oil well		TD 4303			
8" @ 657 Lans. 3712 DST 4184-92						
open 1 hr. Rec. 120' oil 30' mud						
Miss. 4270 5" @ 4271 TD 4294 B/ 5 goph						
500 A 7 go 12 gwph DD 4303 B/ 20 goph						
500 A B/ 20 goph 7 gwph CO to 4302						
1000 A S/ 23 bo 15 bw 13 hr.						
Comp. 43 bo 18 bwpd						

J. E. TYRA