


Map No. 975 Sec. 12 Twp. 26 R. 4  
 Well No. Empire Farm  
Empire Company  
 NORTH

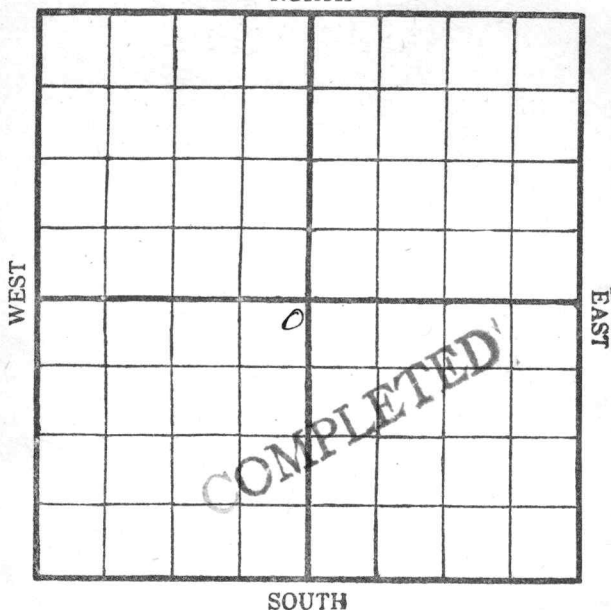

Location\_\_\_\_\_

Rig Up\_\_\_\_\_

Drilling Remarks:

Drilling Remarks:

## RECORD

Cased\_\_\_\_\_ in. \_\_\_\_\_ ft.

Sand \_\_\_\_\_

Gas \_\_\_\_\_

Oil \_\_\_\_\_

Total Depth\_\_\_\_\_

## PRODUCTION

1st 24 hrs. Nat. \_\_\_\_\_

1st 24 hrs. after shot \_\_\_\_\_

Gas \_\_\_\_\_ cu. ft

Dry Hole \_\_\_\_\_

Abandoned \_\_\_\_\_


Map No. \_\_\_\_\_ Sec. 12 Twp. 26 R. 4

Well No. 12. Emyart Farm \_\_\_\_\_

Empire Company \_\_\_\_\_

NORTH

WEST

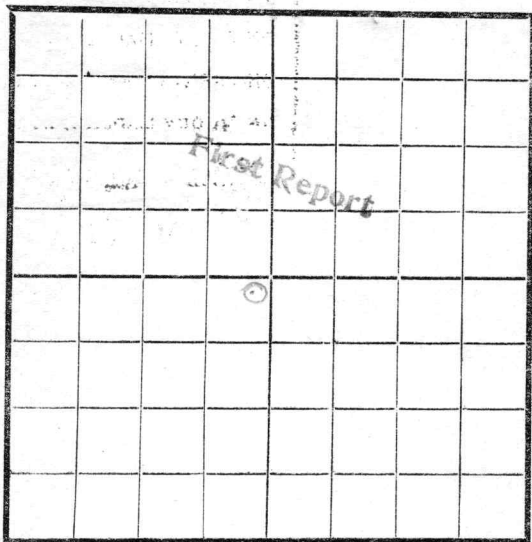

EAST

SOUTH

Location \_\_\_\_\_

Rig Up ☒ \_\_\_\_\_

Drilling and remarks \_\_\_\_\_

### RECORD

Cased \_\_\_\_\_ in \_\_\_\_\_ Ft

Sand \_\_\_\_\_

Gas \_\_\_\_\_

Oil \_\_\_\_\_

Total Depth \_\_\_\_\_

### PRODUCTION

1st 24 hrs. Nat. \_\_\_\_\_

1st 24 hrs. after shot \_\_\_\_\_

Gas \_\_\_\_\_ Cu. Ft.

Dry Hole \_\_\_\_\_

Abandoned \_\_\_\_\_


Date

8-29-1917 Lantz Scout

Map No. \_\_\_\_\_ Sec. 12 Twp. 26 R. 4Well No. 12 Ensign Farm \_\_\_\_\_  
Engine Company \_\_\_\_\_

NORTH

WEST

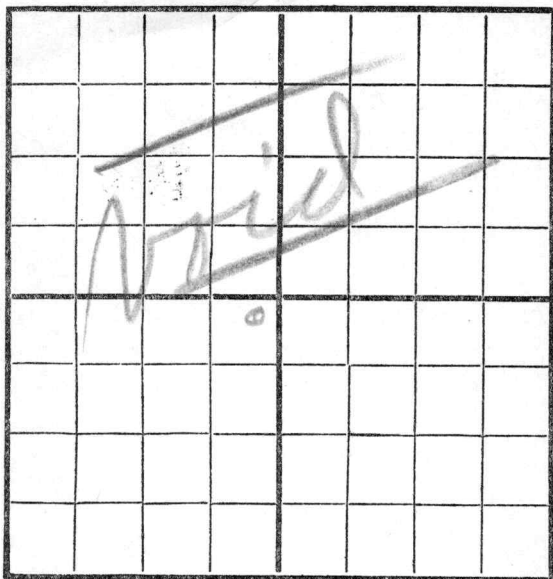

EAST

SOUTH

Location \_\_\_\_\_

Rig Up \_\_\_\_\_

Drilling and remarks

*Numbered  
Wrong*

## RECORD

Cased \_\_\_\_\_ in. \_\_\_\_\_ Ft.

Sand \_\_\_\_\_

Gas \_\_\_\_\_

Oil \_\_\_\_\_

Total Depth \_\_\_\_\_

## PRODUCTION

1st 24 hrs. Nat. \_\_\_\_\_

1st 24 hrs. after shot \_\_\_\_\_

Gas \_\_\_\_\_ Cu. Ft.

Dry Hole \_\_\_\_\_

Abandoned \_\_\_\_\_


Date

8/29, 1917, Cardiff Scout

Map No. \_\_\_\_\_ Sec. 12 Twp. 26 R. 4  
Well No. 9 Bryant Farm \_\_\_\_\_  
Empire Company \_\_\_\_\_

NORTH

WEST

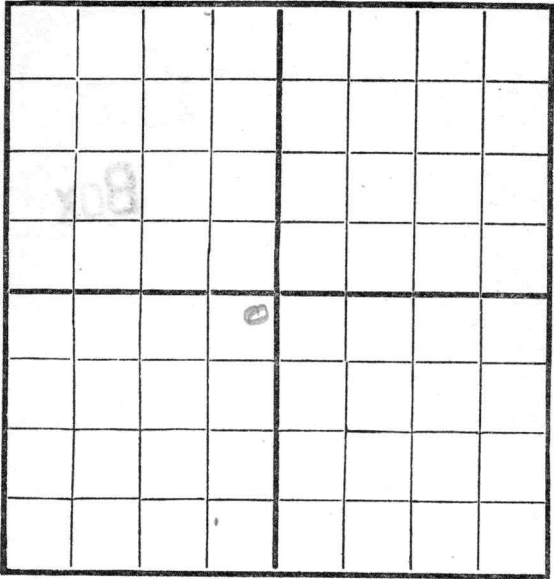

EAST

SOUTH

Location \_\_\_\_\_  
Rig Up ☒ \_\_\_\_\_  
Drilling and remarks \_\_\_\_\_

RECORD

Cased \_\_\_\_\_ in. \_\_\_\_\_ Ft.  
Sand \_\_\_\_\_  
Gas \_\_\_\_\_  
Oil \_\_\_\_\_  
Total Depth \_\_\_\_\_


PRODUCTION

1st 24 hrs. Nat. \_\_\_\_\_  
1st 24 hrs. after shot \_\_\_\_\_  
Gas \_\_\_\_\_ Cu. Ft.  
Dry Hole \_\_\_\_\_  
Abandoned \_\_\_\_\_

Date 9/26, 1917, Cardiff Scout

Map No. \_\_\_\_\_ Sec. 12 Twp. 26 R. 4  
 Well No. 9 Canyon Farm \_\_\_\_\_  
Empire Company \_\_\_\_\_

NORTH

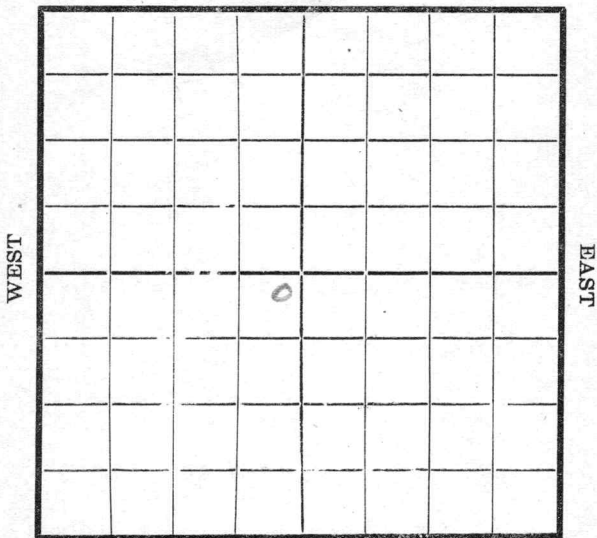

SOUTH

Location \_\_\_\_\_

Rig Up \_\_\_\_\_

Drilling and remarks

725

**RECORD**

Cased \_\_\_\_\_ in. \_\_\_\_\_ Ft.

Sand \_\_\_\_\_

Gas \_\_\_\_\_

Oil \_\_\_\_\_

Total Depth \_\_\_\_\_

**PRODUCTION**

1st 24 hrs. Nat. \_\_\_\_\_

1st 24 hrs. after shot \_\_\_\_\_

Gas \_\_\_\_\_ Cu. Ft.

Dry Hole \_\_\_\_\_


Abandoned \_\_\_\_\_

Date

10/9, 1917 Candy Scout

Map No. \_\_\_\_\_ Sec. 12 Twp. 36 R. 4  
Well No. 9 E myant Farm \_\_\_\_\_  
Emphire Company \_\_\_\_\_

NORTH

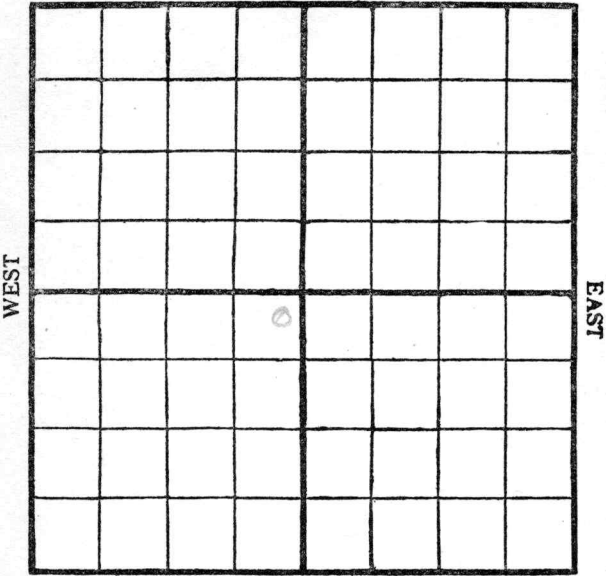

SOUTH


|                      |                              |
|----------------------|------------------------------|
| Location _____       | <b>RECORD</b>                |
| Rig Up _____         | Cased _____ in. _____ Ft.    |
| Drilling and remarks | Sand _____                   |
| <u>860</u>           | Gas _____                    |
|                      | Oil _____                    |
|                      | Total Depth _____            |
|                      | <b>PRODUCTION</b>            |
|                      | 1st 24 hrs. Nat. _____       |
|                      | 1st 24 hrs. after shot _____ |
|                      | Gas _____ Cu. Ft.            |
|                      | Dry Hole _____               |
|                      | Abandoned _____              |

Date \_\_\_\_\_  
10/17, 1917, Emphire Scout

Map No. \_\_\_\_\_ Sec. 12 Twp. 26 R. 4Well No. 9 \_\_\_\_\_ Farm  
Empire \_\_\_\_\_ Company

NORTH

WEST

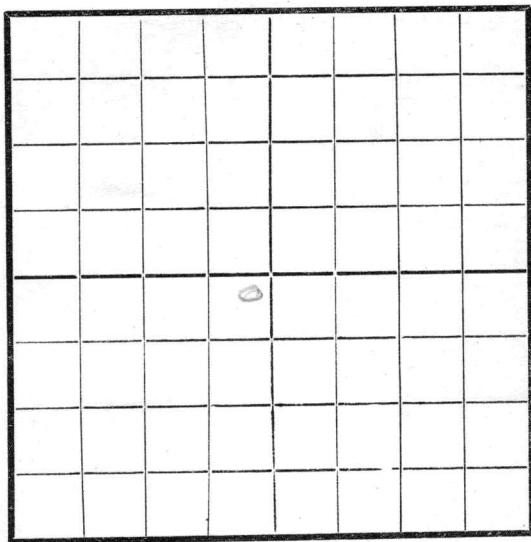

EAST

SOUTH

Location \_\_\_\_\_

Rig Up \_\_\_\_\_

Drilling and remarks

1050

## RECORD

Cased \_\_\_\_\_ in \_\_\_\_\_ Ft.

Sand \_\_\_\_\_

Gas \_\_\_\_\_

Oil \_\_\_\_\_

Total Depth \_\_\_\_\_

## PRODUCTION

1st 24 hrs. Nat. \_\_\_\_\_

1st 24 hrs. after shot \_\_\_\_\_

Gas \_\_\_\_\_ Cu. Ft.

Dry Hole \_\_\_\_\_

Abandoned \_\_\_\_\_

Date


10/24, 1917Condy

Scout

Map No. \_\_\_\_\_ Sec. 12 Twp. 26 R. 4Well No. 9 Empire Farm \_\_\_\_\_Empire Company \_\_\_\_\_

NORTH

WEST

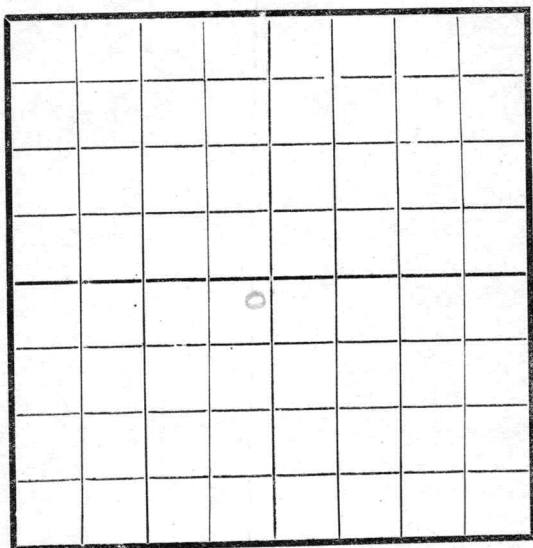

EAST

SOUTH

## RECORD

Location \_\_\_\_\_

Cased \_\_\_\_\_ in. \_\_\_\_\_ Ft.

Rig Up \_\_\_\_\_

Sand \_\_\_\_\_

Drilling and remarks

Gas \_\_\_\_\_

Oil \_\_\_\_\_

Total Depth \_\_\_\_\_

## PRODUCTION

1st 24 hrs. Nat. \_\_\_\_\_

1st 24 hrs. after shot \_\_\_\_\_

Gas \_\_\_\_\_ Cu. Ft.

Dry Hole \_\_\_\_\_

Abandoned \_\_\_\_\_

Date

10/31, 1912 2 Cardiff Scout \_\_\_\_\_


Map No. \_\_\_\_\_ Sec. 12 Twp. 26 R. 4

Well No. 9 \_\_\_\_\_ Farm \_\_\_\_\_

Empire \_\_\_\_\_ Company \_\_\_\_\_

NORTH

WEST

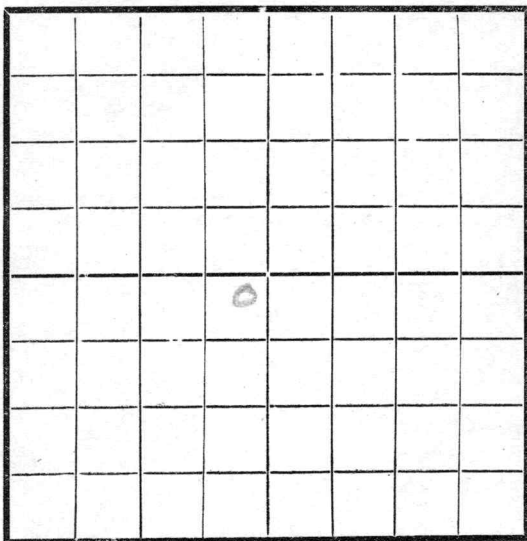

EAST

SOUTH

Location \_\_\_\_\_

Rig Up \_\_\_\_\_

Drilling and remarks

221050

RECORD

Cased \_\_\_\_\_ in. \_\_\_\_\_ Ft.

Sand \_\_\_\_\_

Gas \_\_\_\_\_

Oil \_\_\_\_\_

Total Depth \_\_\_\_\_

PRODUCTION

1st 24 hrs. Nat. \_\_\_\_\_

1st 24 hrs. after shot \_\_\_\_\_

Gas \_\_\_\_\_ Cu. Ft.

Dry Hole \_\_\_\_\_

Abandoned \_\_\_\_\_


Date

11-7, 1917 Carly \_\_\_\_\_ Scout

Map No. \_\_\_\_\_ Sec. 12 Twp. 26 R. 4  
Well No. 9 Bryant Farm \_\_\_\_\_  
Engine Company \_\_\_\_\_

NORTH

WEST

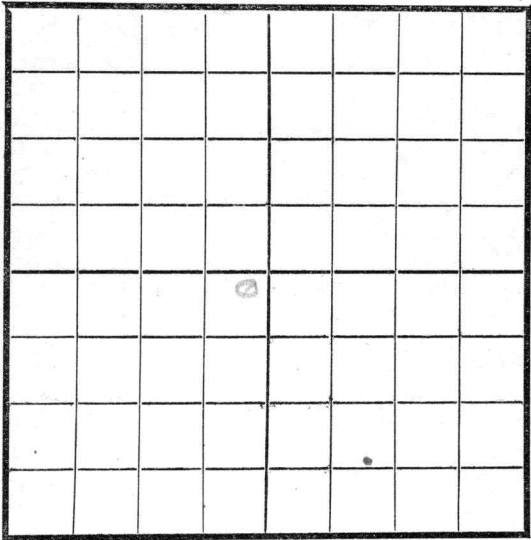

EAST

SOUTH

Location \_\_\_\_\_  
Rig Up \_\_\_\_\_  
Drilling and remarks

SD 1050

RECORD

Cased \_\_\_\_\_ in. \_\_\_\_\_ Ft.  
Sand \_\_\_\_\_  
Gas \_\_\_\_\_  
Oil \_\_\_\_\_  
Total Depth \_\_\_\_\_

PRODUCTION

1st 24 hrs. Nat. \_\_\_\_\_  
1st 24 hrs. after shot \_\_\_\_\_  
Gas \_\_\_\_\_ Cu. Ft.  
Dry Hole \_\_\_\_\_  
Abandoned \_\_\_\_\_

Date


11/14, 1917 Condyff Scout \_\_\_\_\_

Map No. \_\_\_\_\_ Sec. 12 Twp. 26 R. 4Well No. 9 Farm \_\_\_\_\_

Company \_\_\_\_\_

NORTH

WEST

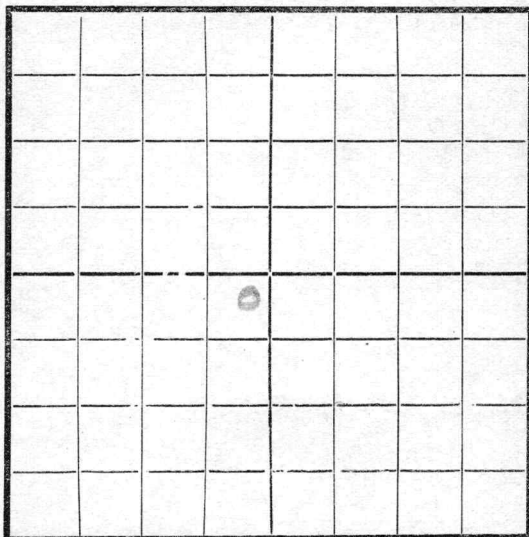

EAST

SOUTH

## RECORD

Location \_\_\_\_\_

Cased \_\_\_\_\_ in \_\_\_\_\_ Ft.

Rig Up \_\_\_\_\_

Sand \_\_\_\_\_

Drilling and remarks

Gas \_\_\_\_\_

Oil \_\_\_\_\_

Total Depth \_\_\_\_\_

## PRODUCTION

1st 24 hrs. Nat. \_\_\_\_\_

1st 24 hrs. after shot \_\_\_\_\_

Gas \_\_\_\_\_ Cu. Ft.

Dry Hole \_\_\_\_\_

Abandoned \_\_\_\_\_

Date


11/21, 1917 \_\_\_\_\_ Scout

Map No. \_\_\_\_\_ Sec. 12 Twp. 26 R. 4Well No. 2 \_\_\_\_\_ Farm \_\_\_\_\_

Company \_\_\_\_\_

NORTH

WEST

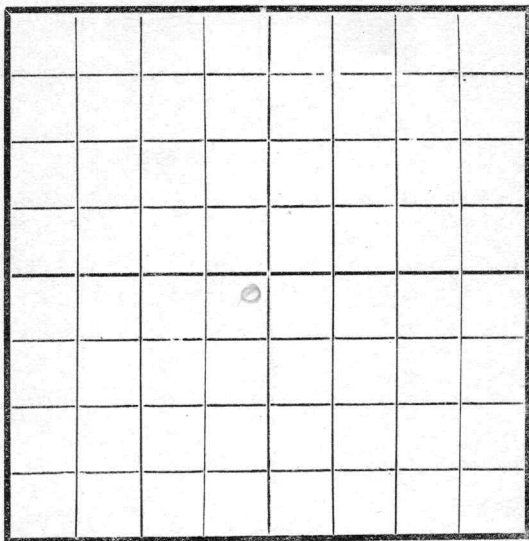

EAST

SOUTH

Location \_\_\_\_\_

Rig Up \_\_\_\_\_

Drilling and remarks

1550

## RECORD

Cased \_\_\_\_\_ in. \_\_\_\_\_ Ft.

Sand \_\_\_\_\_

Gas \_\_\_\_\_

Oil \_\_\_\_\_

Total Depth \_\_\_\_\_

## PRODUCTION

1st 24 hrs. Nat. \_\_\_\_\_

1st 24 hrs. after shot \_\_\_\_\_

Gas \_\_\_\_\_ Cu. Ft.

Dry Hole \_\_\_\_\_

Abandoned \_\_\_\_\_


Date

11/28, 1917 Conley Scout

Map No. \_\_\_\_\_ Sec. 12 Twp. 26 R. 4  
 Well No. 98 Bryant Farm \_\_\_\_\_  
Enigma Company \_\_\_\_\_

NORTH

WEST

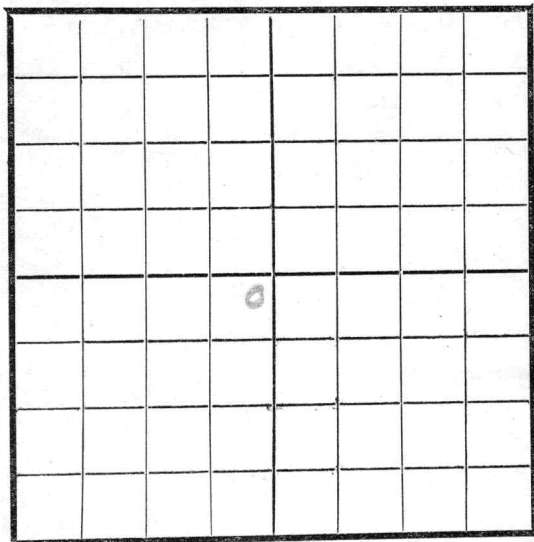

EAST

SOUTH

### RECORD

Location \_\_\_\_\_  
 Rig Up \_\_\_\_\_  
 Drilling and remarks

Cased \_\_\_\_\_ in. \_\_\_\_\_ Ft.  
 Sand \_\_\_\_\_  
 Gas \_\_\_\_\_  
 Oil \_\_\_\_\_  
 Total Depth \_\_\_\_\_

### PRODUCTION

1st 24 hrs. Nat. \_\_\_\_\_  
 1st 24 hrs. after shot \_\_\_\_\_  
 Gas \_\_\_\_\_ Cu. Ft.  
 Dry Hole \_\_\_\_\_  
 Abandoned \_\_\_\_\_

Date

12/5/1911 Scout \_\_\_\_\_

Map No. \_\_\_\_\_ Sec. 12 Twp. 26 R. 4


Well No. 9 \_\_\_\_\_ Farm \_\_\_\_\_

Empire \_\_\_\_\_ Company \_\_\_\_\_

NORTH

WEST

EAST

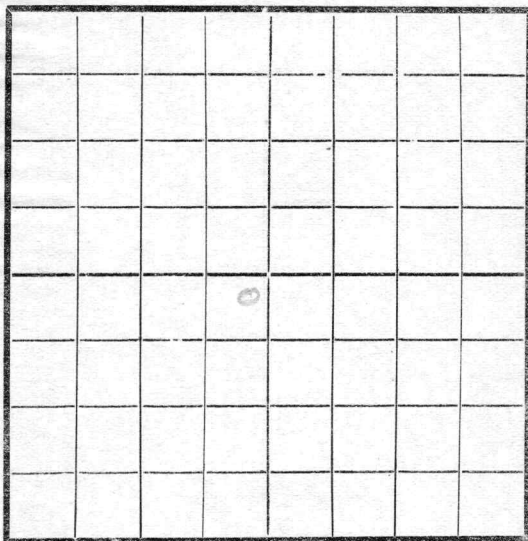

SOUTH

Location \_\_\_\_\_

Rig Up \_\_\_\_\_

Drilling and remarks

*Collapsed  
Casing  
1700*

### RECORD

Cased \_\_\_\_\_ in. \_\_\_\_\_ Ft.

Sand \_\_\_\_\_

Gas \_\_\_\_\_

Oil \_\_\_\_\_

Total Depth \_\_\_\_\_

### PRODUCTION

1st 24 hrs. Nat. \_\_\_\_\_

1st 24 hrs. after shot \_\_\_\_\_

Gas \_\_\_\_\_ Cu. Ft.

Dry Hole \_\_\_\_\_

Abandoned \_\_\_\_\_


Date

1/2, 1911 S. C. C. C. Scout

Map No. \_\_\_\_\_ Sec. 13 Twp. 26 R. 4Well No. 9 E. Bryant Farm \_\_\_\_\_Engineered Company \_\_\_\_\_

NORTH

WEST

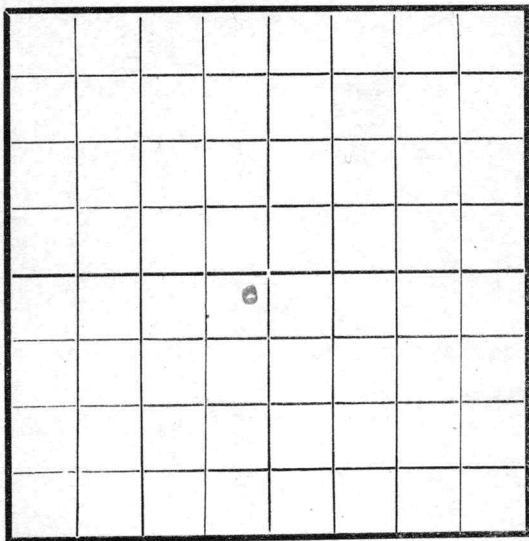

EAST

SOUTH

Location \_\_\_\_\_

Rig Up \_\_\_\_\_

Drilling and remarks \_\_\_\_\_

## RECORD

Cased \_\_\_\_\_ in. \_\_\_\_\_ Ft.

Sand \_\_\_\_\_

Gas \_\_\_\_\_

Oil \_\_\_\_\_

Total Depth \_\_\_\_\_

## PRODUCTION

1st 24 hrs. Nat. \_\_\_\_\_

1st 24 hrs. after shot \_\_\_\_\_

Gas \_\_\_\_\_ Cu. Ft.

Dry Hole \_\_\_\_\_

Abandoned \_\_\_\_\_


Date

1/16, 1918 E. Bryant Scout

Map No. \_\_\_\_\_ Sec. 12 Twp. 26 R. 4  
 Well No. 9 Empire Farm  
Empire Company

NORTH

WEST

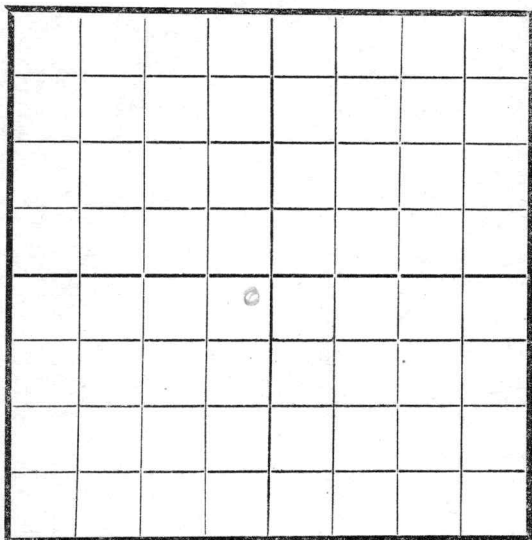

EAST

SOUTH

Location \_\_\_\_\_  
 Rig Up \_\_\_\_\_  
 Drilling and remarks

22 1700

### RECORD

Cased \_\_\_\_\_ in. \_\_\_\_\_ Ft.  
 Sand \_\_\_\_\_  
 Gas \_\_\_\_\_  
 Oil \_\_\_\_\_  
 Total Depth \_\_\_\_\_

### PRODUCTION

1st 24 hrs. Nat. \_\_\_\_\_  
 1st 24 hrs. after shot \_\_\_\_\_  
 Gas \_\_\_\_\_ Cu. Ft.  
 Dry Hole \_\_\_\_\_  
 Abandoned \_\_\_\_\_

Date


1/30, 1918 Empire Scout

Map No. \_\_\_\_\_ Sec. 12 Twp. 26 R. 4Well No. 9 \_\_\_\_\_ Farm \_\_\_\_\_

\_\_\_\_\_ Company \_\_\_\_\_

Date Started \_\_\_\_\_ Ft. from N. \_\_\_\_\_ S. \_\_\_\_\_ E. \_\_\_\_\_ W. \_\_\_\_\_ line

NORTH

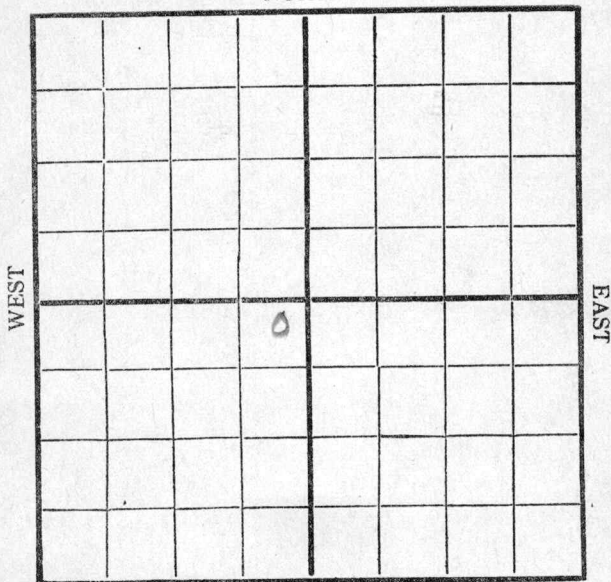

SOUTH

Cased \_\_\_\_\_ In. \_\_\_\_\_ Ft.

Sand \_\_\_\_\_

Pay { Gas \_\_\_\_\_  
Oil \_\_\_\_\_

Total Depth \_\_\_\_\_

Production Remarks


Condition of Well on this date 2/6/18Roll casing 1750Conley

Scout

Map No. \_\_\_\_\_ Sec. 12 Twp. 26 R. 4Well No. 9 Bryant Farm  
Engine Company

NORTH

WEST

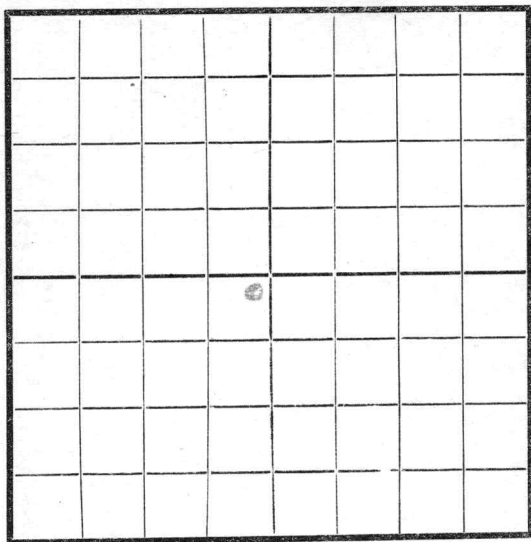

EAST

SOUTH

Location \_\_\_\_\_

Rig Up \_\_\_\_\_

Drilling and remarks

SD 1700

## RECORD

Cased \_\_\_\_\_ in \_\_\_\_\_ Ft.

Sand \_\_\_\_\_

Gas \_\_\_\_\_

Oil \_\_\_\_\_

Total Depth \_\_\_\_\_

## PRODUCTION

1st 24 hrs. Nat. \_\_\_\_\_

1st 24 hrs. after shot \_\_\_\_\_

Gas \_\_\_\_\_ Cu. Ft.

Dry Hole \_\_\_\_\_

Abandoned \_\_\_\_\_


Date

2/3, 1918 End Scout

Map No. \_\_\_\_\_ Sec. 12 Twp. 26 R. 4  
Well No. 9 Ensign Farm \_\_\_\_\_  
Engine Company \_\_\_\_\_

NORTH

WEST

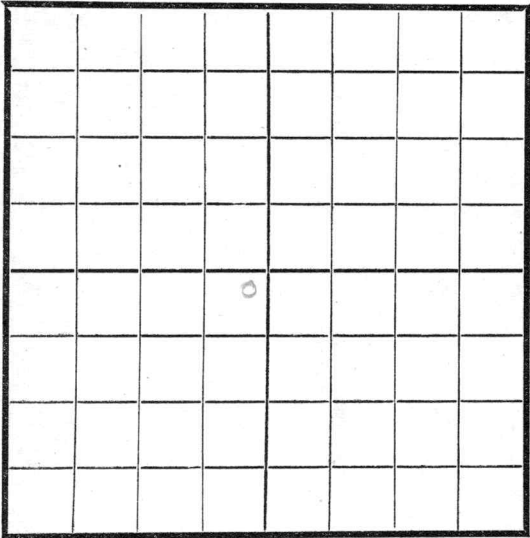

EAST

SOUTH

|                      | RECORD                       |
|----------------------|------------------------------|
| Location _____       | Cased _____ in. _____ Ft.    |
| Rig Up _____         | Sand _____                   |
| Drilling and remarks | Gas _____                    |
|                      | Oil _____                    |
|                      | Total Depth _____            |
|                      | PRODUCTION                   |
|                      | 1st 24 hrs. Nat. _____       |
|                      | 1st 24 hrs. after shot _____ |
|                      | Gas _____ Cu. Ft.            |
|                      | Dry Hole _____               |
|                      | Abandoned _____              |


Date 7/27, 1918 Carney Scout

Map No. \_\_\_\_\_ Sec. 12 Twp. 26 R. 4

Well No. 9 Canyon Farm \_\_\_\_\_  
Canyon Company

NORTH

WEST

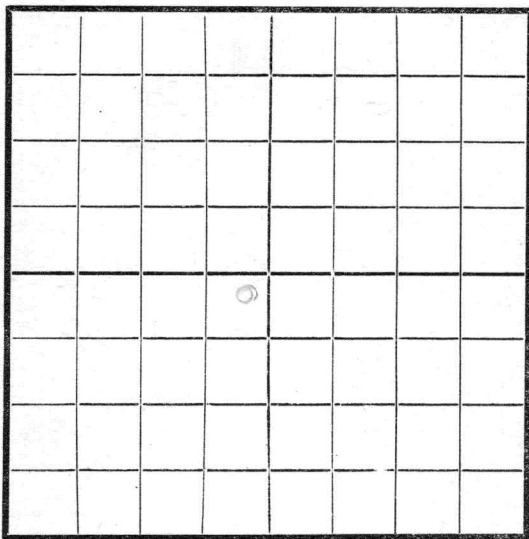

EAST

SOUTH

Location \_\_\_\_\_

Rig Up \_\_\_\_\_

Drilling and remarks

1790

RECORD

Cased \_\_\_\_\_ in. \_\_\_\_\_ Ft.

Sand \_\_\_\_\_

Gas \_\_\_\_\_

Oil \_\_\_\_\_

Total Depth \_\_\_\_\_

PRODUCTION

1st 24 hrs. Nat. \_\_\_\_\_

1st 24 hrs. after shot \_\_\_\_\_

Gas \_\_\_\_\_ Cu. Ft.

Dry Hole \_\_\_\_\_

Abandoned \_\_\_\_\_


Date

3/6, 1918 Scout

Map No. \_\_\_\_\_ Sec. 12 Twp. 26 R. 4  
 Well No. 9 Canyon Farm \_\_\_\_\_  
Canyon Company \_\_\_\_\_

NORTH

WEST

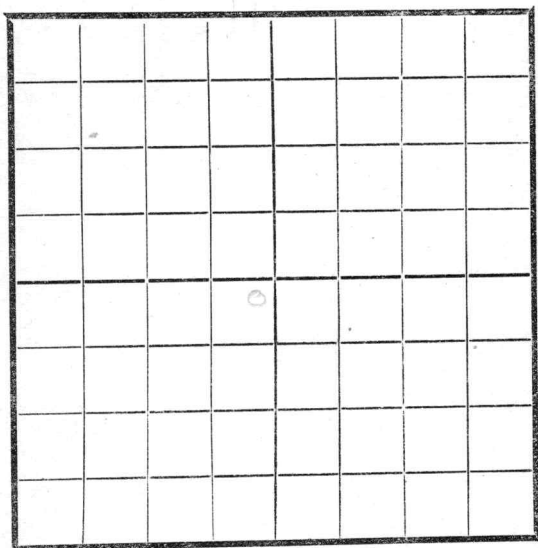

EAST

SOUTH

Location \_\_\_\_\_  
 Rig Up \_\_\_\_\_  
 Drilling and remarks

2085

### RECORD

Cased \_\_\_\_\_ in \_\_\_\_\_ Ft.  
 Sand \_\_\_\_\_  
 Gas \_\_\_\_\_  
 Oil \_\_\_\_\_  
 Total Depth \_\_\_\_\_

### PRODUCTION

1st 24 hrs. Nat. \_\_\_\_\_  
 1st 24 hrs. after shot \_\_\_\_\_  
 Gas \_\_\_\_\_ Cu. Ft.  
 Dry Hole \_\_\_\_\_  
 Abandoned \_\_\_\_\_


Date

3/13, 1911 S. Candy Scout

Map No. \_\_\_\_\_ Sec. 12 Twp. 26 R. 4  
 Well No. 9E myant Farm \_\_\_\_\_  
Engine Company \_\_\_\_\_

NORTH

WEST

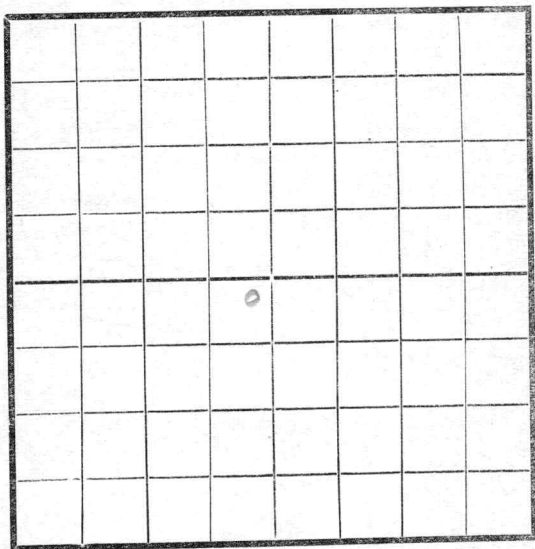

EAST

SOUTH

### RECORD

Location \_\_\_\_\_  
 Rig Up \_\_\_\_\_  
 Drilling and remarks

Cased \_\_\_\_\_ in. \_\_\_\_\_ Ft.  
 Sand \_\_\_\_\_  
 Gas \_\_\_\_\_  
 Oil \_\_\_\_\_  
 Total Depth \_\_\_\_\_

2410

### PRODUCTION

1st 24 hrs. Nat. \_\_\_\_\_  
 1st 24 hrs. after shot \_\_\_\_\_  
 Gas \_\_\_\_\_ Cu. Ft.  
 Dry Hole \_\_\_\_\_  
 Abandoned \_\_\_\_\_

Date


3/20, 1911 J. C. C. C. Scout

Map No. \_\_\_\_\_ Sec. 13 Twp. 26 R. 4

Well No. 9 \_\_\_\_\_ Farm \_\_\_\_\_  
Empire \_\_\_\_\_ Company

NORTH

WEST

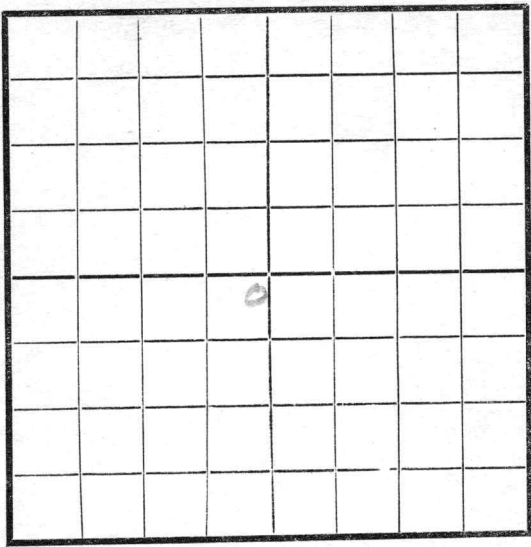

EAST

SOUTH

RECORD

Location \_\_\_\_\_  
 Rig Up \_\_\_\_\_  
 Drilling and remarks

Cased \_\_\_\_\_ in. \_\_\_\_\_ Ft.  
 Sand \_\_\_\_\_  
 Gas \_\_\_\_\_  
 Oil \_\_\_\_\_  
 Total Depth \_\_\_\_\_

PRODUCTION

1st 24 hrs. Nat. \_\_\_\_\_  
 1st 24 hrs. after shot \_\_\_\_\_  
 Gas \_\_\_\_\_ Cu. Ft.  
 Dry Hole \_\_\_\_\_  
 Abandoned \_\_\_\_\_

Date


3/11, 1918 Empire Scout

Map No. K14 Sec. 12 Twp. 26 R. 4Well No. 95Company Empire

Contractor \_\_\_\_\_

NORTH

WEST

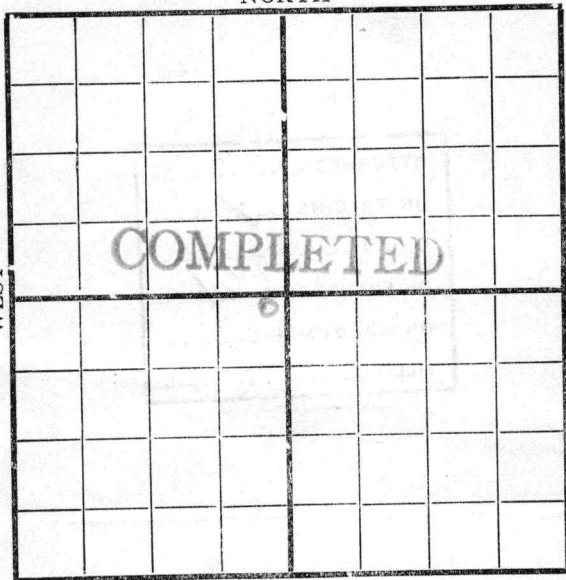

EAST

SOUTH

## RECORD

Location \_\_\_\_\_

Cased \_\_\_\_\_ in., \_\_\_\_\_ ft.

Rig up \_\_\_\_\_

Sand 2410-2465

Drilling and Remarks:

Gas \_\_\_\_\_

Oil \_\_\_\_\_

Total Depth \_\_\_\_\_

## PRODUCTION

1st 24 hrs. Nat. \_\_\_\_\_

1st 24 hrs. after shot \_\_\_\_\_

Gas \_\_\_\_\_ Cu. Ft.

Dry Hole \_\_\_\_\_

Abandoned \_\_\_\_\_

Date

3/27 191 8 Cardiff Scout