


Map No. _____ Sec. 12 Twp. 26 R. 4
 Well No. 10 Empart Farm _____
Empire Company _____

NORTH

WEST

EAST

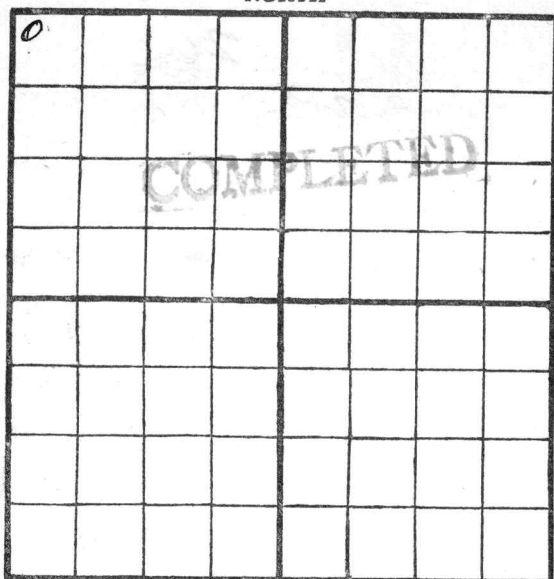

SOUTH

Location _____

Rig Up _____

Drilling Remarks:

Drilling Remarks:

RECORD

Cased _____ in. _____ ft.

Sand _____

Gas _____

Oil _____

Total Depth _____

PRODUCTION

1st 24 hrs. Nat. _____

1st 24 hrs. after shot _____

Gas _____ cu. ft


Dry Hole _____

Abandoned _____

Map No. _____ Sec. 12 Twp. 26 R. 4
 Well No. 10 Emyant Farm _____
Emyant Company _____

NORTH

WEST

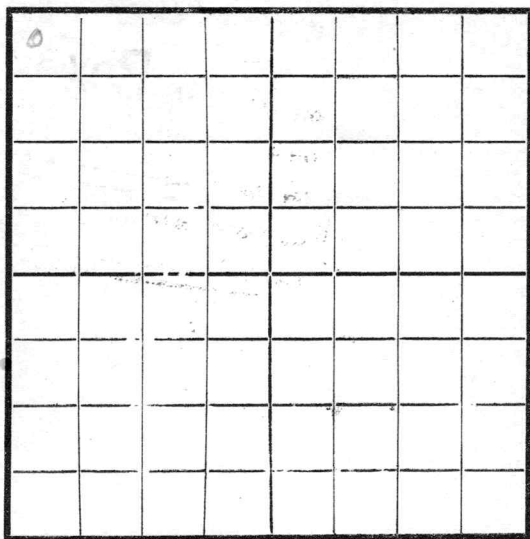

EAST

SOUTH

Location _____

Rig Up ☒ _____

Drilling and remarks

In shallow well

FIRST REPORT

RECORD

Cased _____ in. _____ Ft.

Sand _____

Gas _____

Oil _____

Total Depth _____

PRODUCTION

1st 24 hrs. Nat. _____

1st 24 hrs. after shot _____

Gas _____ Cu. Ft.

Dry Hole _____

Abandoned _____


Date

9/5, 1917 Condy Scout

Map No. _____ Sec. 12 Twp. 26 R. 4Well No. 10 Engine Farm _____
Engine Company _____

NORTH

WEST

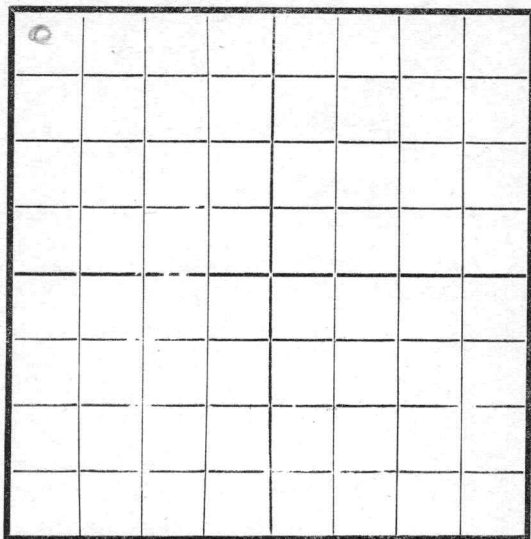

EAST

SOUTH

Location _____

Rig Up _____

Drilling and remarks

1320

RECORD

Cased _____ in. _____ Ft.

Sand _____

Gas _____

Oil _____

Total Depth _____

PRODUCTION

1st 24 hrs. Nat. _____

1st 24 hrs. after shot _____

Gas _____ Cu. Ft.

Dry Hole _____

Abandoned _____


Date

10/9, 1917 Conley Scout

Map No. _____ Sec. 12 Twp. 26 R. 4
Well No. 10 E. Bryant Farm _____
Bryant Company

NORTH

WEST

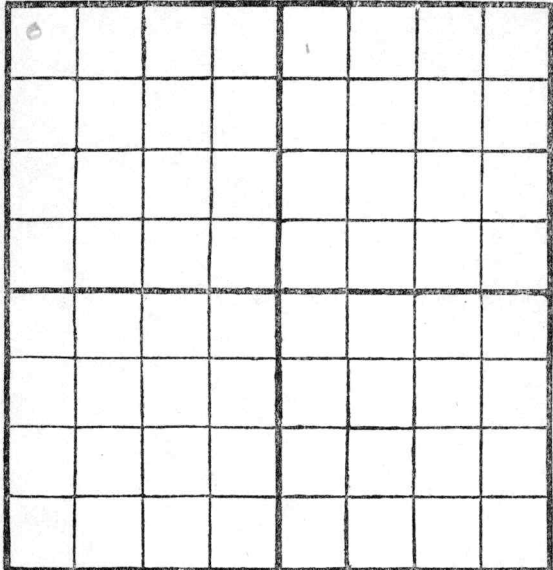

EAST

SOUTH

Location _____
Rig Up _____
Drilling and remarks
1410

RECORD

Cased _____ in. _____ Ft.
Sand _____
Gas _____
Oil _____
Total Depth _____

PRODUCTION

1st 24 hrs. Nat. _____
1st 24 hrs. after shot _____
Gas _____ Cu. Ft.
Dry Hole _____
Abandoned _____


Date 10/17, 1917, Condy Scout

Map No. _____ Sec. 12 Twp. 26 R. 4

Well No. 10 Enquest Farm _____
Enquest Company

NORTH

WEST

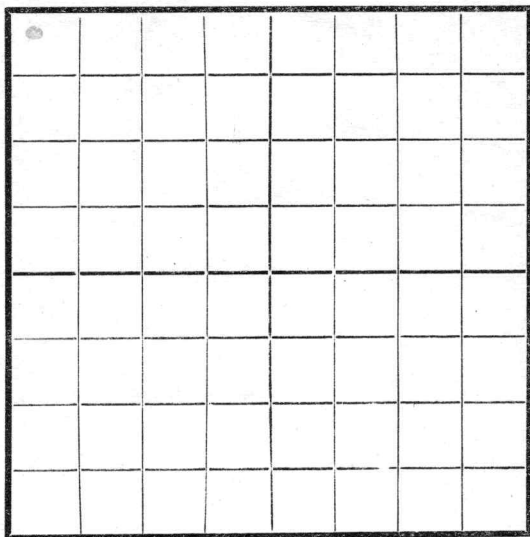

EAST

SOUTH

Location _____

Rig Up _____

Drilling and remarks

1536

RECORD

Cased _____ in. _____ Ft.

Sand _____

Gas _____

Oil _____

Total Depth _____

PRODUCTION

1st 24 hrs. Nat. _____

1st 24 hrs. after shot _____

Gas _____ Cu. Ft.

Dry Hole _____

Abandoned _____


Date

10/24, 1917 Corbett Scout

Map No. _____ Sec. 12 Twp. 26 R. 4
Well No. 10 Empire Farm _____
Empire Company

NORTH

WEST

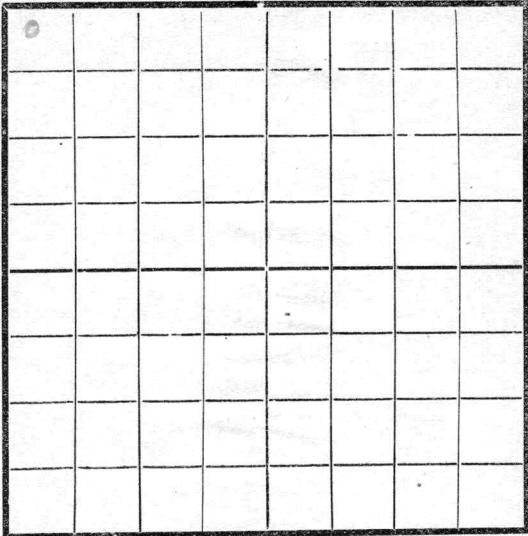

EAST

SOUTH

Location _____
Rig Up _____
Drilling and remarks
22 1536

RECORD

Cased _____ in. _____ Ft.
Sand _____
Gas _____
Oil _____
Total Depth _____

PRODUCTION

1st 24 hrs. Nat. _____
1st 24 hrs. after shot _____
Gas _____ Cu. Ft.
Dry Hole _____
Abandoned _____

Date 10/31, 1917 Condy Scout

Map No. _____ Sec. 12 Twp. 26 R. 4

Well No. 10 Empire Farm _____

_____ Company

NORTH

WEST

EAST

COMPLETED

SOUTH

Location _____

Rig Up _____

Drilling and remarks

Est 4

100

13bl

RECORD

Cased _____ in _____ Ft.

Sand 1652-1696

Gas _____

Oil _____

Total Depth _____

PRODUCTION

1st 24 hrs. Nat. _____

1st 24 hrs. after shot _____

Gas _____ Cu. Ft.

Dry Hole _____

Abandoned _____

Date

11-7, 1917 Carby Scout