
Form 51—8-18 -5M—Mid West

Map No._____ Sec. 18 Twp. 23 R. 4

Well No. 6 Leasing Farm

Elbing A. & G. Company

NORTH

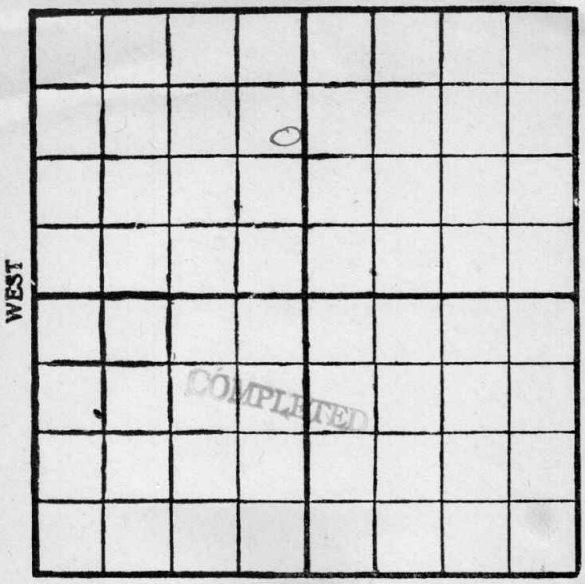

SOUTH

Location _____

Drilling Remarks:

Rig Up _____

Drilling Remarks:

RECORD

Cased_____ in._____ ft.

Sand _____

Gas _____

Oil_____

Total Depth _____

PRODUCTION

1st 24 hrs. Nat._____

1st 24 hrs. after shot_____

Gas _____ cu. ft.

Dry Hole _____

Abandoned _____


Form 26—1M Books of 100 Sheets Each—4-15-18

Map No. K14 Sec. 18 Twp. 23 R. 4

Well No. 6 Ludin

Elbing 10 K.G. Company

Contractor

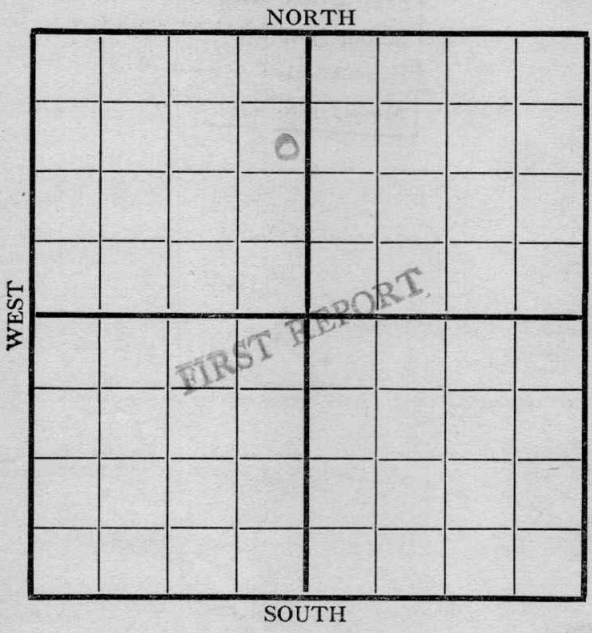

Location 200-E 1120-N

Rig up

Drilling and Remarks:

RECORD

Cased ____ in., ____ ft.

Sand

Gas

Oil

Total Depth

PRODUCTION

1st 24 hrs. Nat.

1st 24 hrs. after shot

Gas ____ Cu. Ft.

Dry Hole

Abandoned

Date

11/14 191 8 Scout


Form 26—'M Books of 100 Sheets Each—4-15-18

Map No. 514 Sec. 18 Twp. 23 R. 4

Well No. 6 Ludig

Elbing O & G. Company

Contractor

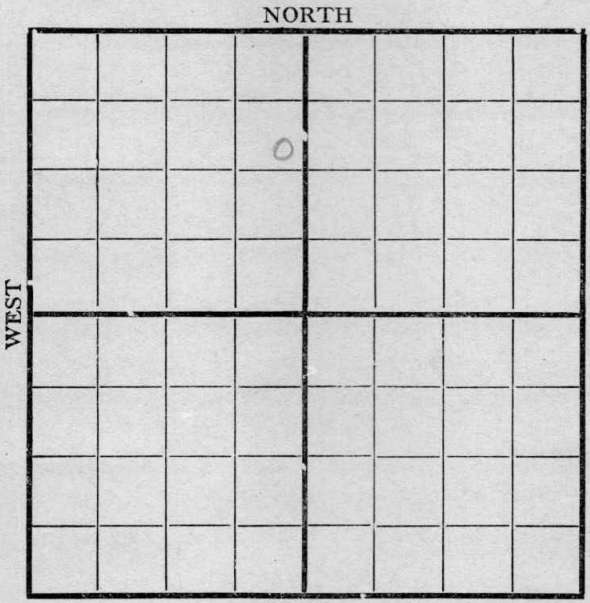

Location

Rig up ✓

Drilling and Remarks:

RECORD

Cased ____ in., ____ ft.

Sand

Gas

Oil

Total Depth

PRODUCTION

1st 24 hrs. Nat.

1st 24 hrs. after shot

Gas ____ Cu. Ft.

Dry Hole

Abandoned

Date

11/20 1918 Cyph Scout


Form 26—1M Books of 100 Sheets Each—4-15-18

Map No. K 14 Sec. 18 Twp. 23 R. 4

Well No. 6 Leyding

Elbing O & G. Company

Contractor

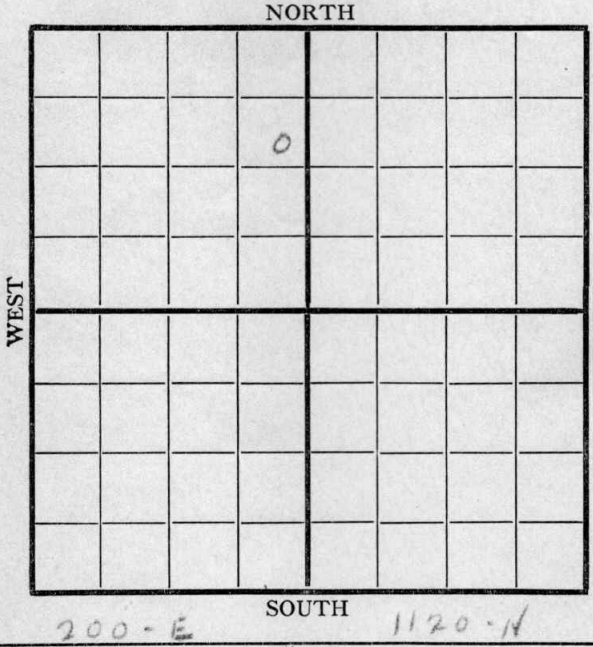

Location

Rig up ✓

Drilling and Remarks:

RECORD

Cased ____ in., ____ ft.

Sand

Gas

Oil

Total Depth

PRODUCTION

1st 24 hrs. Nat.

1st 24 hrs. after shot

Gas ____ Cu. Ft.

Dry Hole

Abandoned

Date

11/30 191 8

Pyle Scout


Form 26—1M Books of 100 Sheets Each—4-15-18

Map No. K14 Sec. 18 Twp. 23 R. 4

Well No. 6 Leyding

Elbing O+G. Company

Contractor

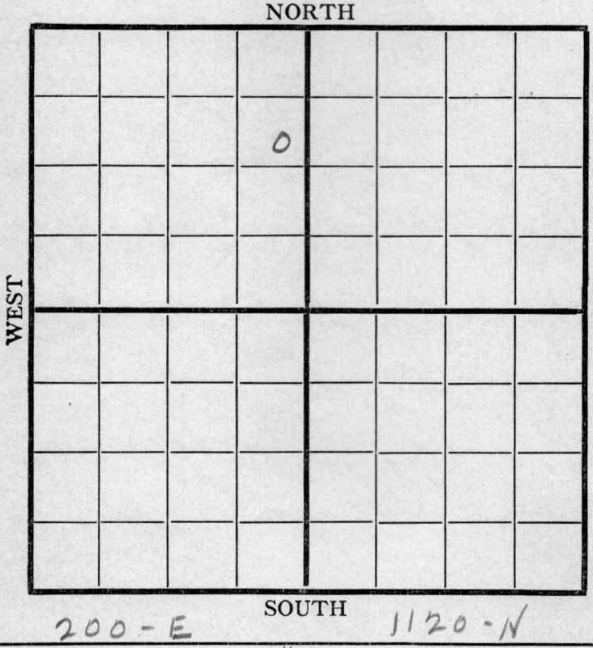

Location

Rig up ✓

Drilling and Remarks:

RECORD

Cased in., ft.

Sand

Gas

Oil

Total Depth

PRODUCTION

1st 24 hrs. Nat.

1st 24 hrs. after shot

Gas Cu. Ft.

Dry Hole

Abandoned

Date

12/4 191 8 Cyle Scout


Form 26—1M Books of 100 Sheets Each—4-15-18

Map No. K 14 Sec. 18 Twp. 23 R. 4

Well No. 6 Leydig

Elbing O.W.P.G. Company

Contractor

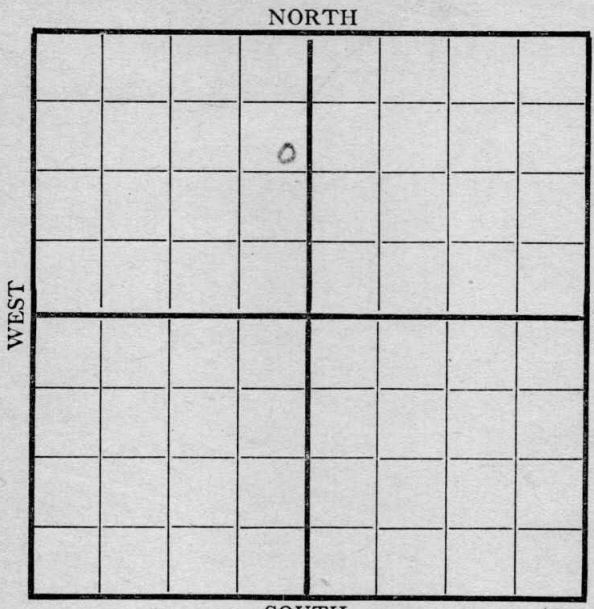

Location

Rig up

Drilling and Remarks:

620'

12½" hole

RECORD

Cased in., ft.

Sand

Gas

Oil

Total Depth

PRODUCTION

1st 24 hrs. Nat.

1st 24 hrs. after shot

Gas Cu. Ft.

Dry Hole

Abandoned

Date

12/10 191 8 H. B. Scout


Form 26—1M Books of 100 Sheets Each—4-15-18

Map No. K14 Sec. 18 Twp. 23 R. 4

Well No. 6 Leydig

Elbing O&G. Company

Contractor

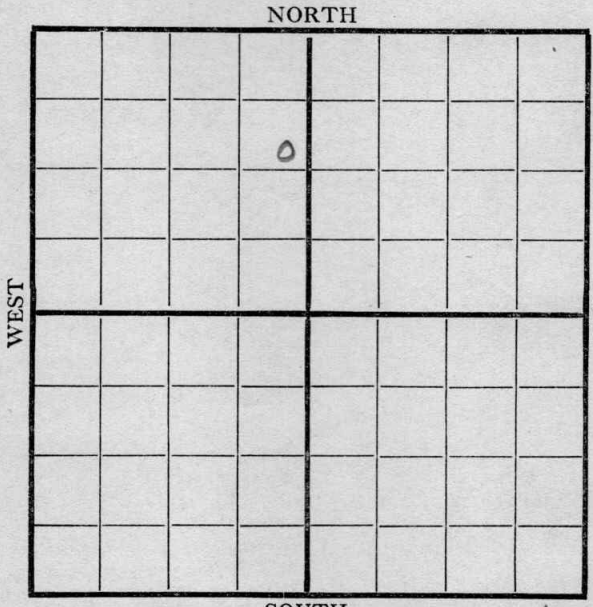

Location

Rig up

Drilling and Remarks:

1400'

RECORD

Cased in., ft.

Sand

Gas

Oil

Total Depth

PRODUCTION

1st 24 hrs. Nat.

1st 24 hrs. after shot

Gas Cu. Ft.

Dry Hole

Abandoned

Date

12/19 191 8

Pyle Scout


Form 26—1M Books of 100 Sheets Each—4-15-18

Map No. K14 Sec. 18 Twp. 23 R. 4

Well No. 6 Leydig

Elbing O&G — Company

Contractor

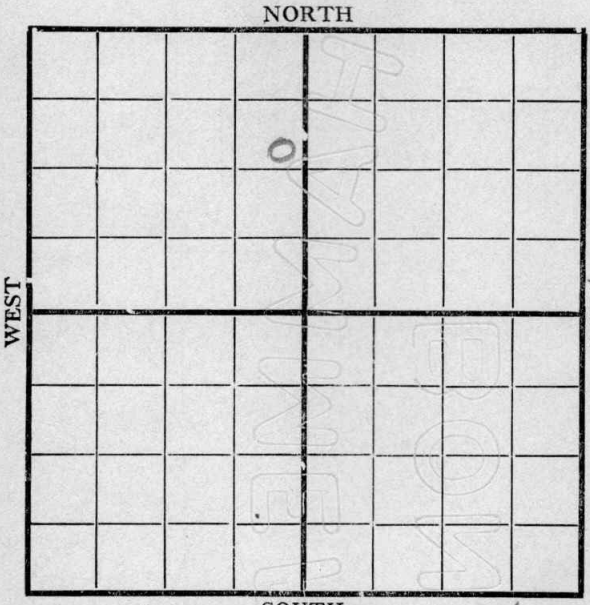

Location

Rig up

Drilling and Remarks:

D D @

1440

RECORD

Cased ____ in., ____ ft.

Sand

Gas

Oil

Total Depth

PRODUCTION

1st 24 hrs. Nat.

1st 24 hrs. after shot

Gas ____ Cu. Ft.

Dry Hole

Abandoned

Date

12/27/18

Pyle — Scout


Form 26—1M Books of 100 Sheets Each—4-15-18

Map No. K14 Sec. 18 Twp. 23 R. 4

Well No. 6 Leyding

Elbing O&G Co. Company

Contractor

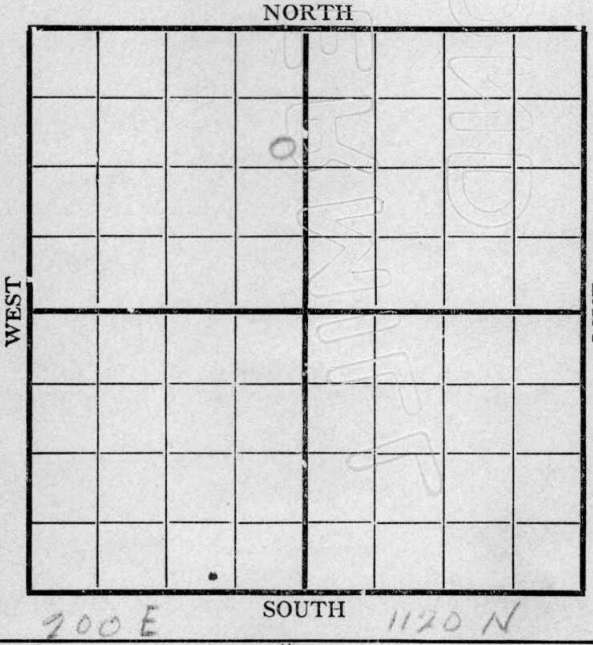

Location

Rig up

Drilling and Remarks:

1750'

RECORD

Cased ____ in., ____ ft.

Sand

Gas

Oil

Total Depth

PRODUCTION

1st 24 hrs. Nat.

1st 24 hrs. after shot

Gas ____ Cu. Ft.

Dry Hole

Abandoned

Date

Jan 15 1919

Pyle Scout


Form 26—1M Books of 100 Sheets Each—4-15-18

Map No. K14 Sec. 18 Twp. 23 R. 4

Well No. G Leydig

Elbing O&G. Company

Contractor

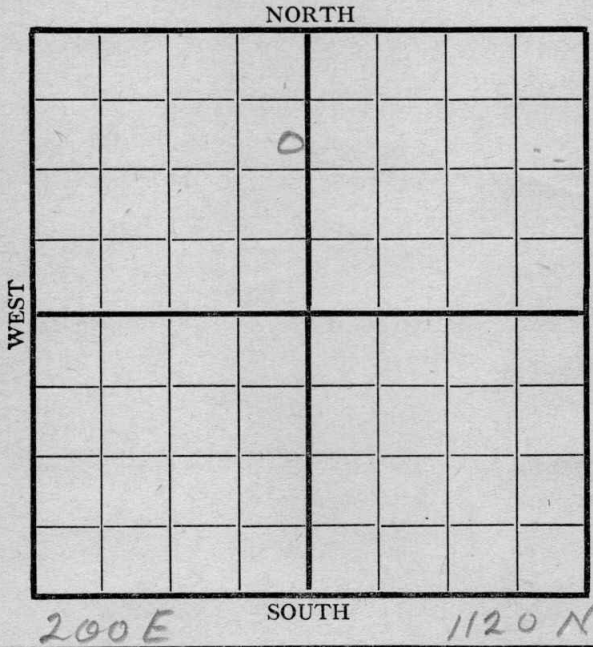

Location

Rig up

Drilling and Remarks:

2000'

RECORD

Cased in., ft.

Sand

Gas

Oil

Total Depth

PRODUCTION

1st 24 hrs. Nat.

1st 24 hrs. after shot

Gas Cu. Ft.

Dry Hole

Abandoned

Date

Jan 21 1919 Pyle Scout


Form 26—M Books of 100 Sheets Each—4-15-18

Map No. K14 Sec. 18 Twp. 23 R. 4

Well No. C Leyding

Elbing 10 KG. Company

Contractor

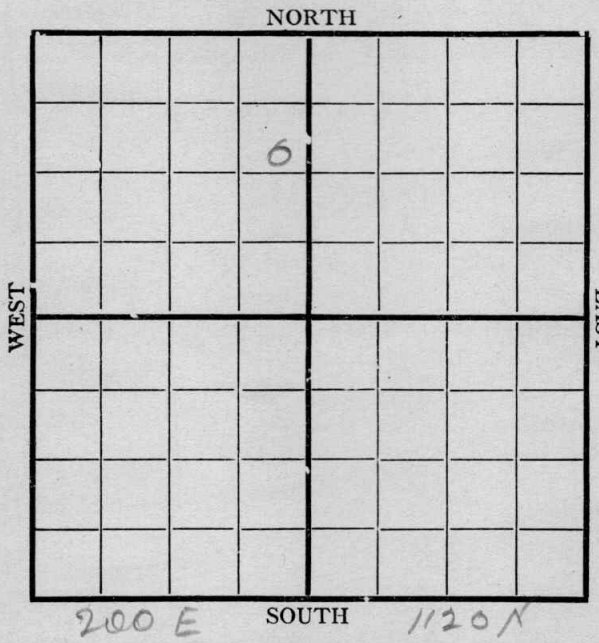

Location

Rig up

Drilling and Remarks:

D. D for
8¼ @ 1880

RECORD

Cased in., ft.

Sand

Gas

Oil

Total Depth

PRODUCTION

1st 24 hrs. Nat.

1st 24 hrs. after shot

Gas Cu. Ft.

Dry Hole

Abandoned

Date

Jan 30 1919

Pyle Scout


Form 26—M Books of 100 Sheets Each—4-15-18

Map No. K14 Sec. 18 Twp. 23 R. 4

Well No. 6 Leyding

Elbing Oil Co. Company

Contractor

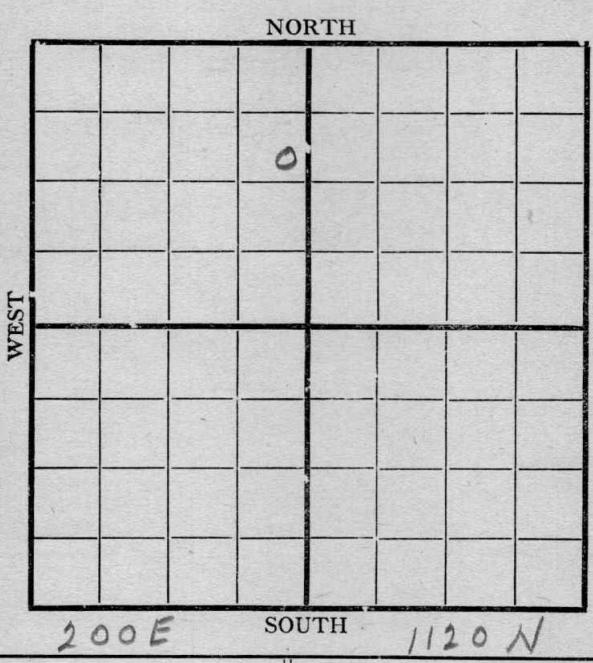

Location

Rig up

Drilling and Remarks:

D. 10 @

1950

8" hole

RECORD

Cased in., ft.

Sand

Gas

Oil

Total Depth

PRODUCTION

1st 24 hrs. Nat.

1st 24 hrs. after shot

Gas Cu. Ft.

Dry Hole

Abandoned

Date

2/5 1919

Pyle Scout


Form 26—'M Books of 100 Sheets Each—4-15-18

Map No. K14 Sec. 19 Twp. 23 R. 4

Well No. 6 Zeigler

Abing O.G. Company

Contractor

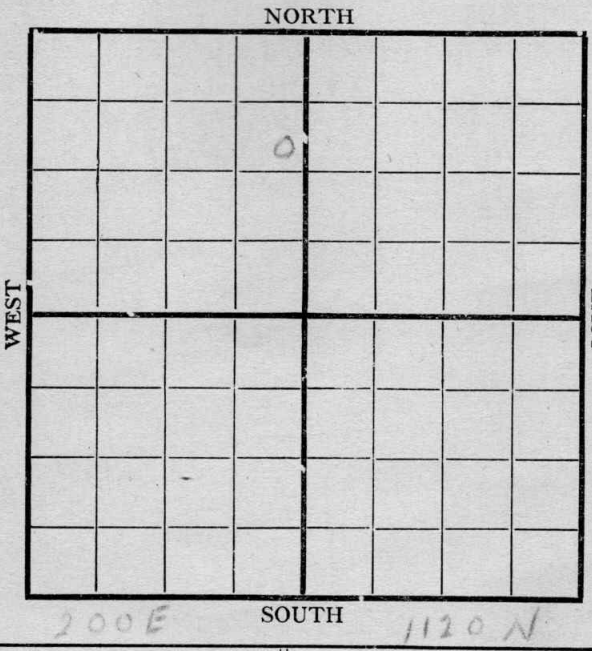

Location

Rig up

Drilling and Remarks:

2290'

RECORD

Cased in., ft.

Sand

Gas

Oil

Total Depth

PRODUCTION

1st 24 hrs. Nat.

1st 24 hrs. after shot

Gas Cu. Ft.

Dry Hole

Abandoned

Date

7/11 1919 Scout


Form 26—1M Books of 100 Sheets Each—4-15-18

Map No. K 14 Sec. 18 Twp. 23 S R. 4 E

Well No. 6 Leydig

Abing Oil Co. Company

Contractor

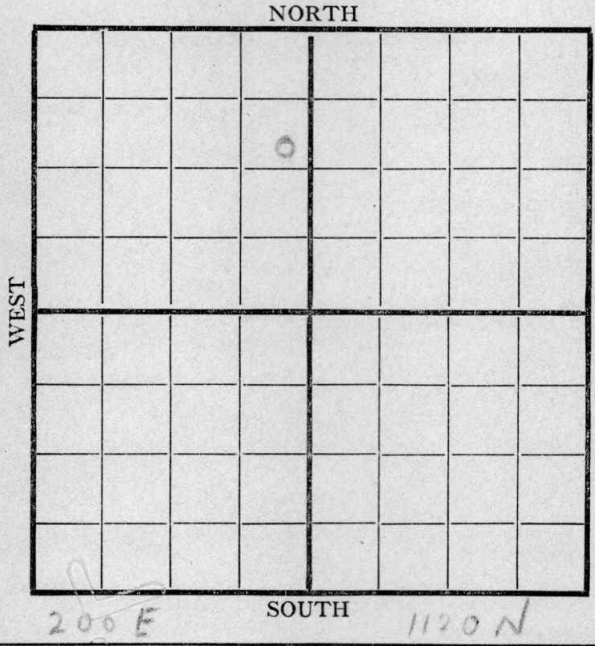

Location

Rig up

Drilling and Remarks:

2380'
S.D. each
end roads

RECORD

Cased in., ft.

Sand

Gas

Oil

Total Depth

PRODUCTION

1st 24 hrs. Nat.

1st 24 hrs. after shot

Gas Cu. Ft.

Dry Hole

Abandoned

Date

2/25 191 9. Coyle Scout


Form 26—1M Books of 100 Sheets Each—4-15-18

Map No. K 14 Sec. 18 Twp. 23 S R. 4 E

Well No. 6 Leydig

Elbing O. P. Co. Company

Contractor

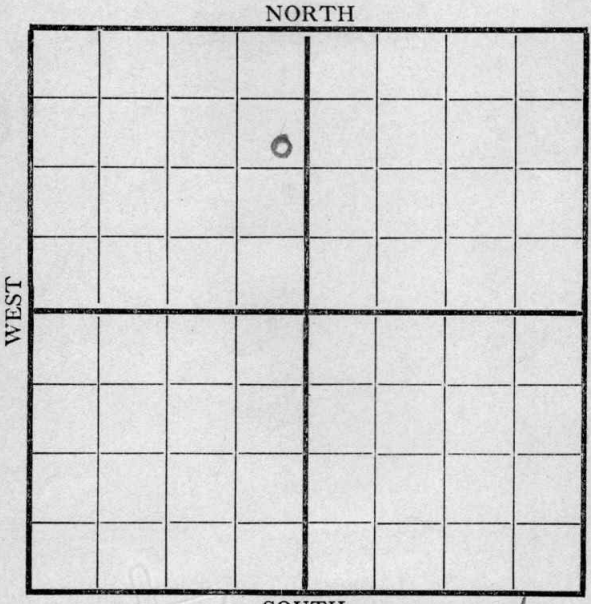

Location

Rig up

Drilling and Remarks:

2380'

6" hole

RECORD

Cased in., ft.

Sand

Gas

Oil

Total Depth

PRODUCTION

1st 24 hrs. Nat.

1st 24 hrs. after shot

Gas Cu. Ft.

Dry Hole

Abandoned

Date

2/28 1919

Pyle Scout


Form 26—1M Books of 100 Sheets Each—4-15-18

Map No. K14 Sec. 18 Twp. 23S R. 4E

Well No. 6 Leyding

Elbing O&G Company

Contractor

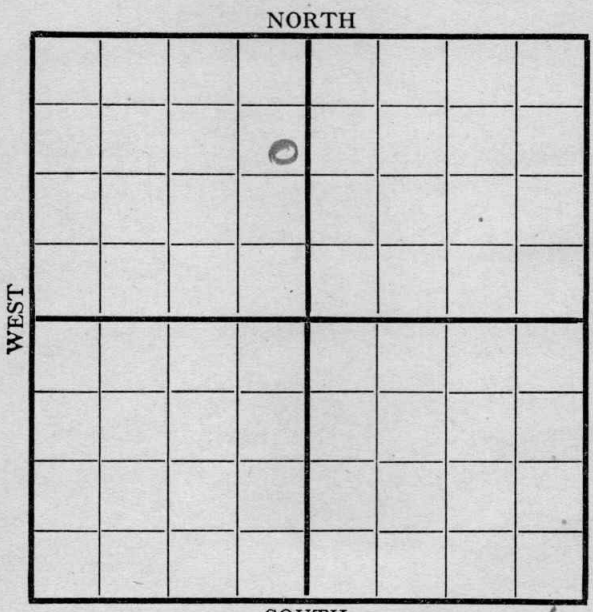

Location

Rig up

Drilling and Remarks:

2480-2492
very light
showing

RECORD

Cased in., ft.

Sand

Gas

Oil

Total Depth

PRODUCTION

1st 24 hrs. Nat.

1st 24 hrs. after shot

Gas Cu. Ft.

Dry Hole

Abandoned

Date 3/6 19 9

Pyle Scout


Form 26—1M Books of 100 Sheets Each—4-15-18

Map No. K14 Sec. 18 Twp. 23 S R. 4 E

Well No. 6 Leyba

Elbring O&G Company

Contractor

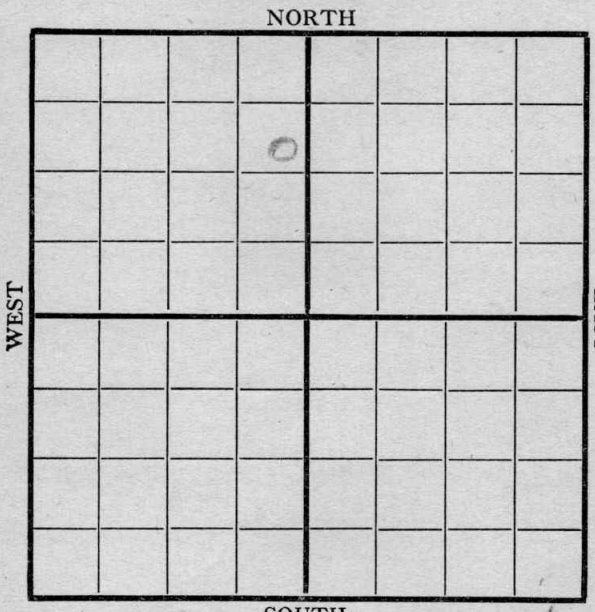

Location

Rig up

Drilling and Remarks:

N. R. 3"

To 2492

RECORD

Cased in., ft.

Sand

Gas

Oil

Total Depth

PRODUCTION

1st 24 hrs. Nat.

1st 24 hrs. after shot

Gas Cu. Ft.

Dry Hole

Abandoned

Date

3/10 1919 Scout


Form 26—1M Books of 100 Sheets Each—4-15-18

Map No. K14 Sec. 18 Twp. 23 R. 4

Well No. 6 Leydig

Elbing O & G. Company

Contractor

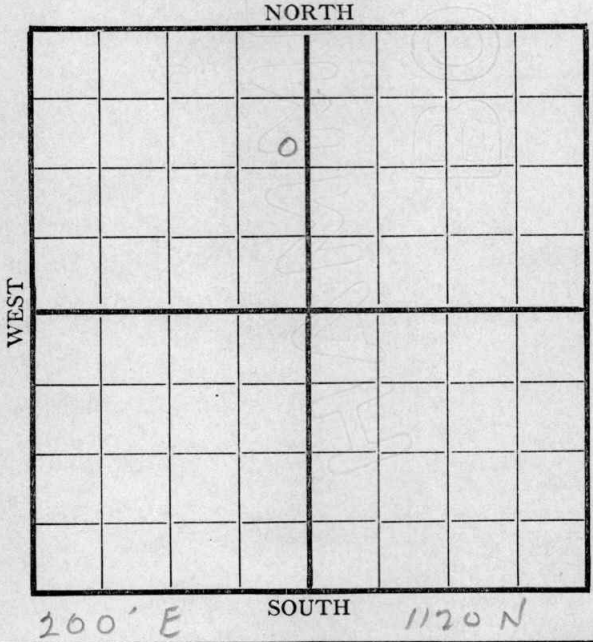

Location

Rig up

Drilling and Remarks:

N. R. 5 3/16

To 2492'

RECORD

Cased in., ft.

Sand

Gas

Oil

Total Depth

PRODUCTION

1st 24 hrs. Nat.

1st 24 hrs. after shot

Gas Cu. Ft.

Dry Hole

Abandoned

Date

3/21 191 9. Pyle Scout


Form 26—:M Books of 100 Sheets Each—4-15-18

Map No. K 14 Sec. 18 Twp. 23 R. 4

Well No. 6 Leyding

Elbing Oil Co. Company

Contractor

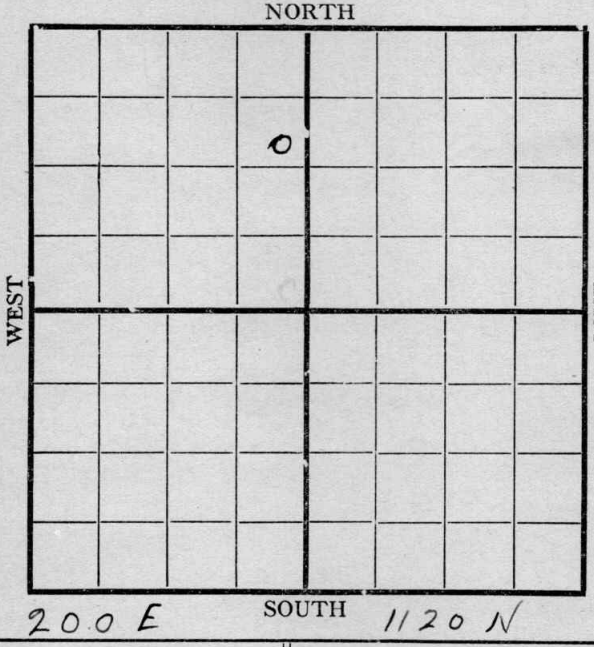

Location

Rig up

Drilling and Remarks:

Set 6" @
2492 ft. D.

RECORD

Cased in., ft.

Sand

Gas

Oil

Total Depth

PRODUCTION

1st 24 hrs. Nat.

1st 24 hrs. after shot

Gas Cu. Ft.

Dry Hole

Abandoned

Date

3/28 1919

Pyle Scout


Form 26—1M Books of 100 Sheets Each—4-15-18

Map No. K 14 Sec. 18 Twp. 23 R. 4

Well No. 6 Leyding

Elbing O. D. Company

Contractor

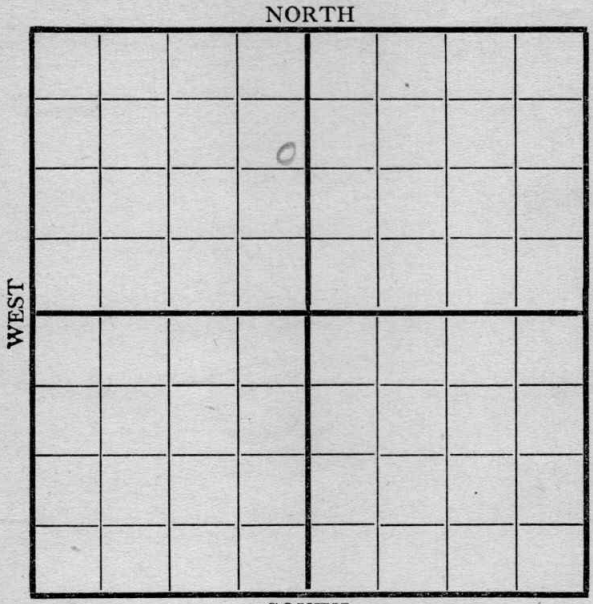

Location

Rig up

Drilling and Remarks:

D. D @
2492
6" hole

RECORD

Cased in., ft.

Sand

Gas

Oil

Total Depth

PRODUCTION

1st 24 hrs. Nat.

1st 24 hrs. after shot

Gas Cu. Ft.

Dry Hole

Abandoned

Date

4/1 191 4 Pyle Scout


Form 26—1M Books of 100 Sheets Each—4-15-18

Map No. K14 Sec. 18 Twp. 33 R. 4

Well No. 6 Leyding

Elbing O & G Co. Company

Contractor

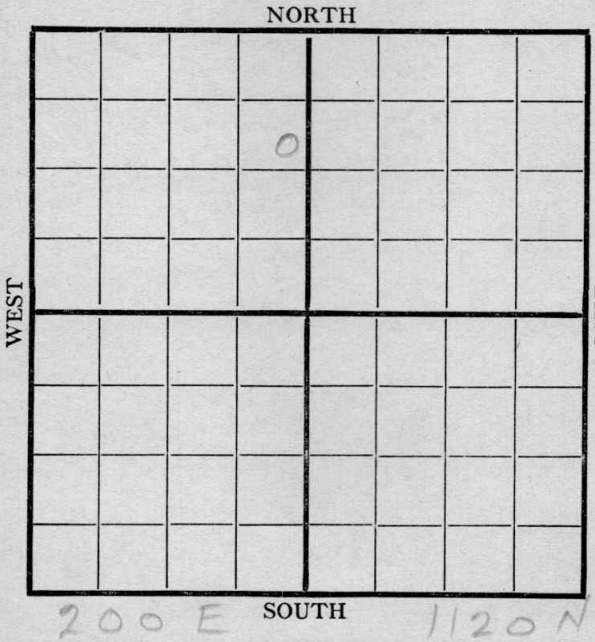

Location

Rig up

Drilling and Remarks:

21 R 6" to 2492 & D. D.

RECORD

Cased in., ft.

Sand

Gas

Oil

Total Depth

PRODUCTION

1st 24 hrs. Nat.

1st 24 hrs. after shot

Gas Cu. Ft.

Dry Hole

Abandoned

Date

4/7 191 9. Ogle Scout


Form 26—1M Books of 100 Sheets Each—4-15-18

Map No. K14 Sec. 18 Twp. 23 R. 4

Well No. 2 Leydig

Elbing Oil Co. Company

Contractor

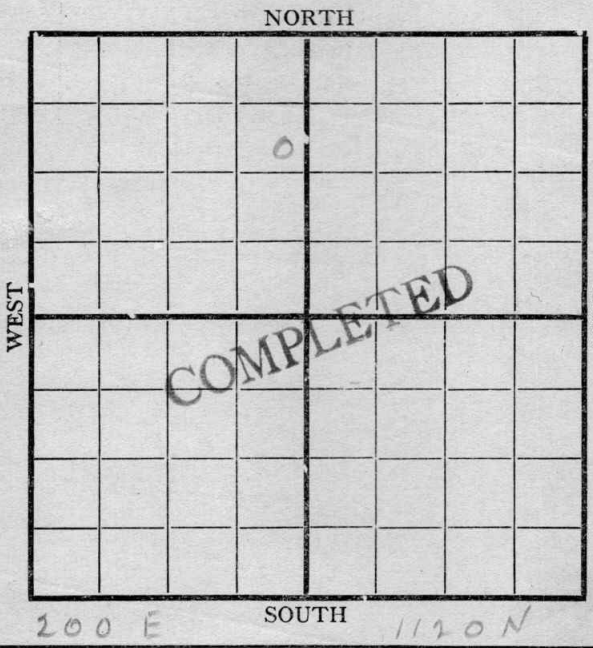

Location

Rig up

Drilling and Remarks:

RECORD

Cased ____ in., ____ ft.

Sand

Gas

Oil

Total Depth

PRODUCTION

1st 24 hrs. Nat.

1st 24 hrs. after shot

Gas ____ Cu. Ft.

Dry Hole 2492

Abandoned

Date

4/19 191 9. Pyle Scout

Butler

FORM 26 250 BKS. 4-28 WESTERN

K14 KANSAS

MAP NO. _____ SEC. 18 TWP. 23S R. 4E

WELL NO. 6 Reynolds


Elling Oil

_____ COMPANY

_____ CONTRACTOR

ABANDONED

SECTION PLAT

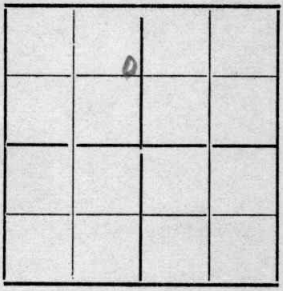

_____ FT. FROM N. LINE

_____ FT. FROM S. LINE

_____ FT. FROM E. LINE

_____ FT. FROM W. LINE

LOCATION _____

RIG UP _____

DRILLING AND REMARKS:

well 2400

RECORD

CASED _____ IN., _____ FT.

SAND _____

GAS _____

OIL _____

TOTAL DEPTH 2498

PRODUCTION

1ST 24 HRS. NAT. _____

1ST 24 HRS. AFTER SHOT _____

GAS _____ CU. FT.

DRY HOLE ✓

ABANDONED ✓

DATE

Apr 23 1929

_____ SCOUT