


Section 31 Township 18 Range 11W

Well No. 1 Kimpler "A"

Company Thunderbird Drlg., Inc.

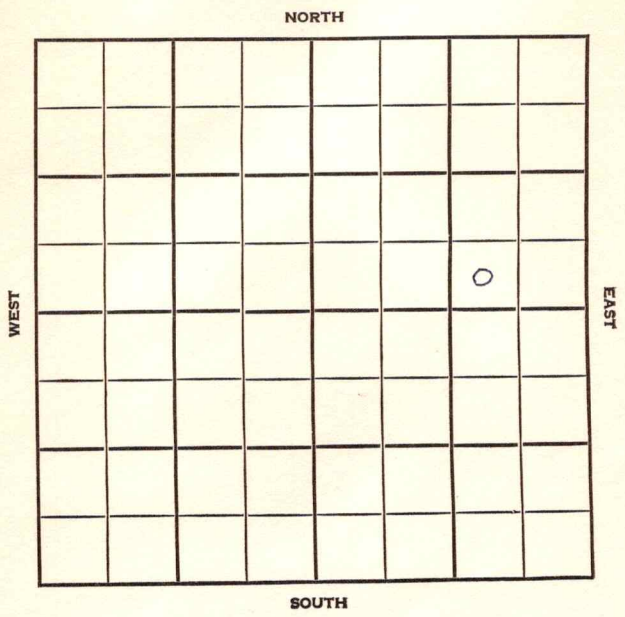

KANSAS

WELL NO. _____

#1 Kimpler "A"

FARM

Thunderbird Drlg Inc.

CONTRACTOR

Co. Tools.

Kimpler Pool

NORTH

Ft. from N. Line

330

Ft. from S. Line

990

Ft. from E. Line

Ft. from W. Line

SW SE NE

WEST

EAST

SOUTH

ELEVATION

REPORT

1955

4/27

Spud 4-23-55

8" @ 179'

Anhy 655'

Drlg. 1200'

6/29

DST 3132-3186, open 1 hr. gas in 45 min. Rec. 50' rotary mud, 525' hgco 15' sw 720/20" DST 3275-95 open 1 hr. Rec. 30' mud 1020/20" DST 3401-19 Failed DST 3409-19, open 45 min. Rec. 15' mud 1050# 5 $\frac{1}{2}$ " @ 3475 CO to 3448 18/3412-18, SSO 500A S/4 $\frac{1}{2}$ boph 25% wtr. 11 hr. P/504 bo 30% wtr. Comp. 63 bopd 50% wtr.

Tops:	Depth	Datum
Anh.	655	
H.	2984	1163
BL	3095	1274
L.	3110	1289
A.	3405	1584
TD.	3475	

COMPLETED

County Barton State Kansas

Sec. 31 (Blk. Twp.) 18 (Sur. Rge.) 11W Map No.

Operator Thunderbird Drlg., Inc.

Well No. 1 Farm Kimpler "A"

Elev.	Location	SW	SE	NE

[illegible]

330 Ft. From S Line NE

990 Ft. From E Line Quarter

1st. Report APR 27 1955

Completion _____

Remarks

Co. tools

Spudding Date 4-23-55

Drig. Data Kimpler Pool

8" @ 179 Anhy 655 drlg. 1200

County Barton Elev. 1821
 Sec. 31 Twp. 18 Rge. 11W
 Company Thunderbird Drlg. Inc.
 Farm Name Kimpler "A" No. 1

TOPS	DEPTH	LOG	DATUM	Loc. in Sec.																								
Anh.	<u>655</u>			SW SE NE																								
Tp.																												
H.	<u>2984</u>		<u>1163</u>																									
Tr.																												
Dg.																												
Bl.	<u>3095</u>		<u>1274</u>																									
L.	<u>3110</u>		<u>1289</u>	Geol.																								
K.C.				Contr.																								
B.K.C.																												
Ce.																												
C.																												
M.				Pool																								
M.				<u>Kimpler</u>																								
K.				<table border="1"> <tr><td></td><td></td><td></td></tr> <tr><td></td><td></td><td></td></tr> <tr><td></td><td></td><td></td></tr> <tr><td></td><td></td><td></td></tr> <tr><td></td><td></td><td></td></tr> <tr><td></td><td></td><td></td></tr> <tr><td></td><td></td><td></td></tr> <tr><td></td><td></td><td></td></tr> </table>																								
Mz.																												
Mq.																												
V.																												
S.																												
S.																												
A	<u>3405</u>		<u>1584</u>																									
R.																												
Pe.																												
G.																												
T.D.	<u>3475</u>			COMPLETE																								

Date Comm. 4-23-55 JUN 29 1955

8" @ 1791/125 DST 3132-3186

open 1 hr. gas in 45 min. Rec. 50'

rotary mud 525' hgco 15' sw 720/20"

DST 3275-95 open 1 hr. Rec. 30' mud

1020/20" DST 3401-19 failed

DST 3409-19 open 45 min. Rec. 15' mud

750# DST 3409-19 open 45 min. Rec.

45' mud 1050# 5½" @ 3475 CO to

3448 18/ 3412-18 SSO 500 A

S/ $4\frac{1}{2}$ boph 25% wtr. 11 hr.

P/ 504 bo 30% wtr.

Comp. 63 bopd 50% wtr.

JUL 8 1955

Scout Cards	
Large Small Map	
Land Wall Map	
Tracings	
France Map	
Pierce Map	
Misc.	

JS