
Form 51—12-17—5M—Mid-West.

Map No. K-14 Sec. 11 Twp. 26 R. 4

Well No. 54 Shumway Farm

~~Gypsy Oil~~ Gulf Oil Company

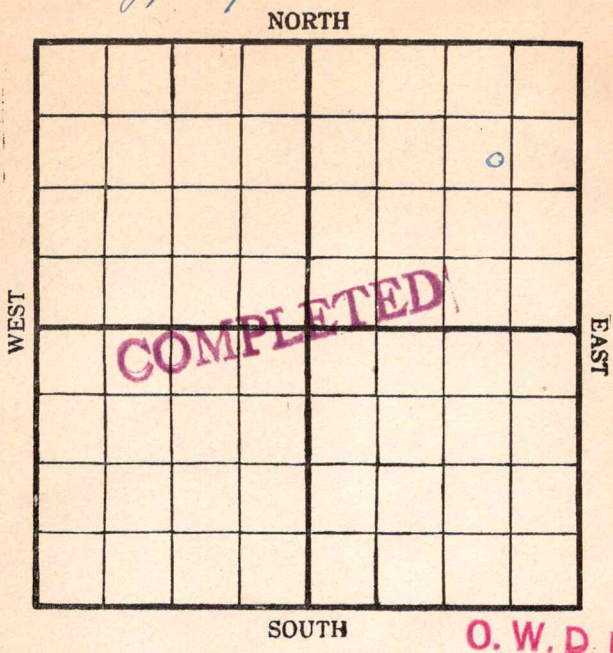

O. W. D. D

Location _____

Drilling Remarks:

Rig Up _____

Drilling Remarks:

RECORD

Cased _____ in. _____ ft.

Sand _____

C ıs _____

Oil _____

Total Depth _____

PRODUCTION

1st 24 hrs. Nat. _____

1st 24 hrs. after shot _____

Gas _____ cu. ft.

Dry Hole _____

Abandoned _____

FORM 252-A 5M 4-39 KANSAS Butler

Sec. 11 Twp. 26 R. 4-E

Well No. #54 Schumway Farm

Gulf Oil Corp. Company


(Eldorado)

990 Ft. from N. Line

Ft. from S. Line

990 Ft. from E. Line

Ft. from W. Line

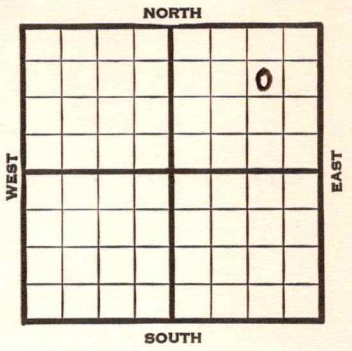

NO CARD RECORD

1939	REPORT O.W.D.D
6/21	Old T.D. 1170'
	Lans. 1648'
	Drlg. 1653'
6/29	7" - 1652' WOC. TD 1653'
7/6	T.D. 1707' Estimated 3 bbls.
	natural per hour. 4000 acid.
7/13	Pump 30 oil & 57 wtr. 24 hours.
7/19	Lans. 1648'
	7" - 1652'
	T.D. 1707'
	4000 acid.
	Pump 43 oil & 55 water.
	COMPLETED


Form 26—1M Books of 100 Sheets Each—4-15-18

Map No. K14 Sec. 11 Twp. 26 R. 4

Well No. 54 Shumway

Gypsy Oil Company

Contractor

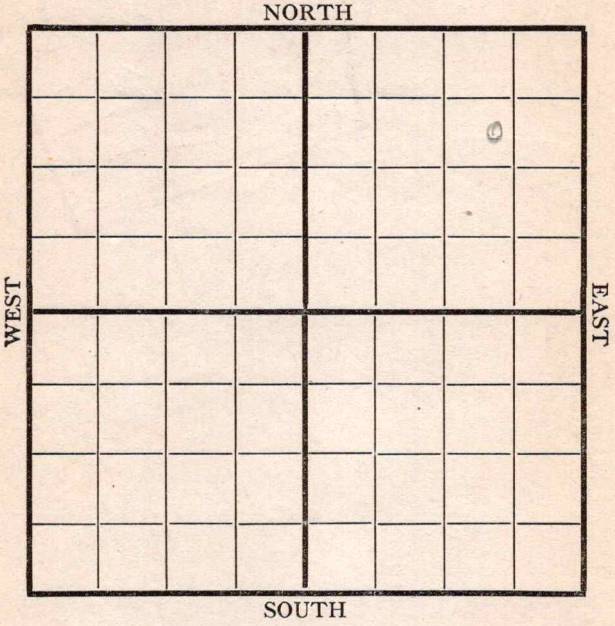

Location

Rig up

Drilling and Remarks:

FIRST REPORT

RECORD

Cased in., ft.

Sand

Gas

Oil

Total Depth

PRODUCTION

1st 24 hrs. Nat.

1st 24 hrs. after shot

Gas Cu. Ft.

Dry Hole

Abandoned

Date

7/25 191 8

Scout


Form 26—1M Books of 100 Sheets Each—4-15-18

Map No. ____ Sec. 11 Twp. 26 R. 4

Well No. 54 L Shumway

Gypsy Oil Company

Grant & Austin Contractor

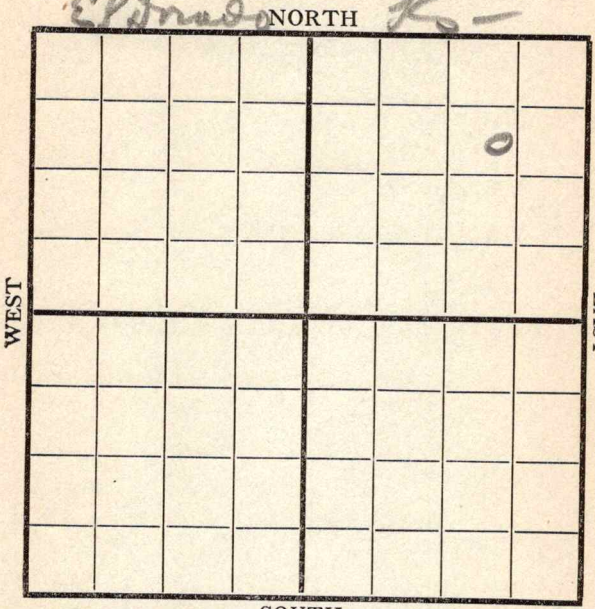

Location ____

Rig up ____

Drilling and Remarks:

700'
(Shallow well)

RECORD

Cased ____ in., ____ ft.

Sand ____

Gas ____

Oil ____

Total Depth ____

PRODUCTION

1st 24 hrs. Nat. ____

1st 24 hrs. after shot ____

Gas ____ Cu. Ft.

Dry Hole ____

Abandoned ____

Date

7/31 191 8 Scout


Form 26—1M Books of 100 Sheets Each—4-15-18

Map No. ____ Sec. 11 Twp. 26 R. 4

Well No. 54 Shumway

Gypsy Company

Contractor

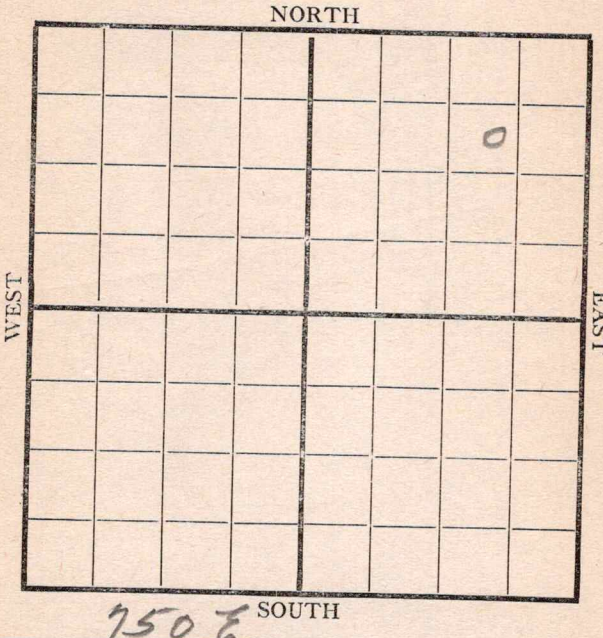

Location 990 N

Rig up

Drilling and Remarks:

990

RECORD

Cased ____ in., ____ ft.

Sand

Gas

Oil

Total Depth

PRODUCTION

1st 24 hrs. Nat.

1st 24 hrs. after shot

Gas ____ Cu. Ft.

Dry Hole

Abandoned

Date 8/7 191 ____ A Condy Scout


Form 26—M Books of 100 Sheets Each—4-15-18

Map No. K14 Sec. 11 Twp. 26 R. 4

Well No. 54 Shumway

Gypsy Oil Company

Contractor

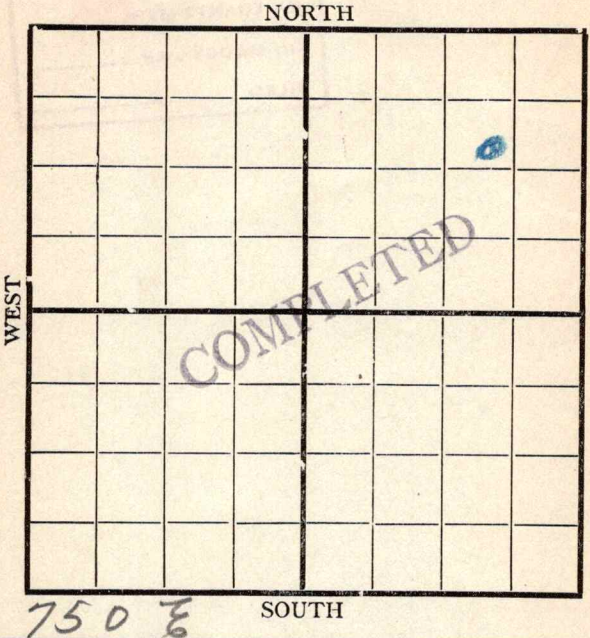

750 E

Location 990 N

Rig up

Drilling and Remarks:

RECORD

Cased in., ft.

Sand 1150-1167

Gas

Oil

Total Depth

PRODUCTION

1st 24 hrs. Nat.

1st 24 hrs. after shot

Gas 367,000 Cu. Ft.

Dry Hole

Abandoned

Date 8/15 191 8 Scout

Form 26—1M Bks.—2-29 Butler KANSAS

Map No. 14 Sec. 11 Twp. 26 R. 4E

Well No. 54 Schumway

Gulf Company

FIRST REPORT

~~CORRECTION~~ Contractor

SW NE NE

990 Ft. from N. Line


_____ Ft. from S. Line

990 Ft. from E. Line

_____ Ft. from W. Line

ELDORADO POOL

SECTION PLAT

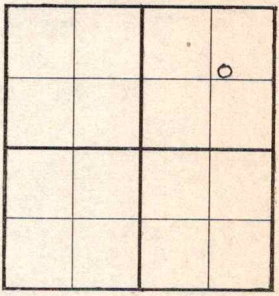

Location _____

Rig up _____

Drilling and Remarks:

OWDD-OTD 1170

Lans. 1648

D rlg. 1653

RECORD

Cased _____ in., _____ ft.

Sand _____

Gas _____

Oil _____

Total Depth _____

PRODUCTION

1st 24 hrs. Nat. _____

1st 24 hrs. after shot _____

Gas _____ Cu. Ft.

Dry Hole _____

Abandoned _____

Date

JUN 21 1939 19

S. J. LEWIS Scout

Form 26—1M Bks.—2-29 Butler KANSAS

Map No. 14 Sec. 11 Twp. 26 R. 4E

Well No. 54 Schumway

Gulf Company

Contractor

COMPLETED

SW NE NE

990 Ft. from N. Line


Ft. from S. Line

990 Ft. from E. Line

Ft. from W. Line

ELDORADO POOL

SECTION PLAT

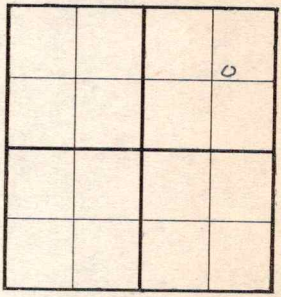

Location

Rig up

Drilling and Remarks:

Kans 1648.
7" @ 1652
4000 acid
Pump 43 oil
65 water

RECORD

Cased in., ft.

Sand

Gas

Oil

Total Depth 1707

PRODUCTION

1st 24 hrs. Nat.

1st 24 hrs. after shot

Gas Cu. Ft.

Dry Hole

Abandoned

Date

JUL 19 1939 19

S. J. LEWIS Scout