
Form 51—5M—10-26—Mid-West

Map No. 55 Sec. 21 Twp. 23 R. 12

Well No. 1 - Mamelles Farm

John Stark Company

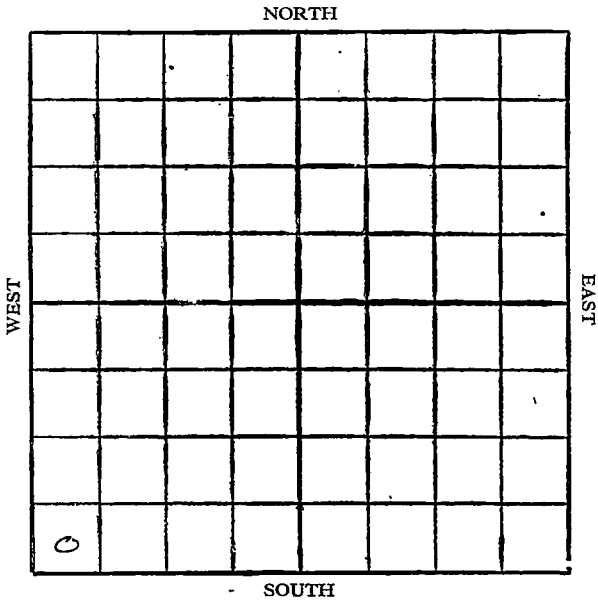

Location	Rig Up
Drilling Remarks	Drilling Remarks
RECORD	PRODUCTION
Cased ..... in. ..... ft.	1st 24 hrs. Nat.
Sand	1st 24 hrs. after shot
Gas	Gas ..... cu. ft.
Oil	Dry Hole
Total Depth	Abandoned


Form 252A—5M—10-26—24951

Greenwood

Map No. Kansas Sec. 21 Twp. 23 R. 12E

Well No. 1 McMellen Farm

John Stark Company

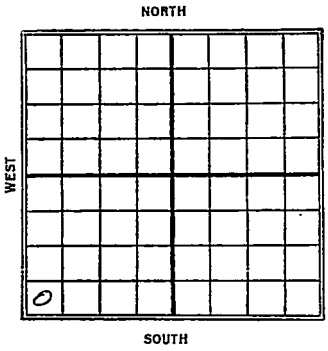

_____ Ft. from N. Line

330 Ft. from S. Line

330 Ft. from E. Line

_____ Ft. from W. Line

Date 1927	REPORT
1/19	Location
1/26	Same
2/3	—
2/10	—
2/17	—
2/24	—
3/2	—
3/9	—
3/16	Spudding
3/24	Drlg 310
3/30	Drlg 760 — (T. K. Simmons bought half interest
4/7	" 1190
4/13	Sand 1650-60 — top lime 1891
	Drilling —
4/20	Sand 1650-60
	Top lime 1891
	D. & A. 1921

Form 26—1M Bks.—3-23—11959. Sherwood

16 KANSAS

Map No. _____ Sec. 21 Twp. 23 R. 12 E

Well No. 1 McMellen

John Stark _____ Company

_____ Contractor

FIRST REPORTS


SECTION PLAT

_____Ft. from N. Line

330 Ft. from S. Line

_____Ft. from E. Line

330 Ft. from W. Line

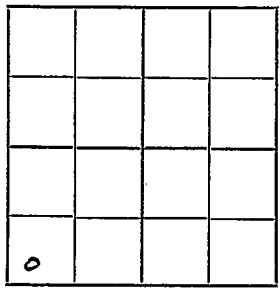

Location ✓

Rig up _____

Drilling and Remarks:

RECORD

Cased _____in., _____ ft.

Sand _____

Gas _____

Oil _____

Total Depth _____

PRODUCTION

1st 24 hrs. Nat. _____

1st 24 hrs. after shot _____

Gas _____ Cu. Ft.

Dry Hole _____

Abandoned _____

Date

JAN 19 1927

CHAS. L. SHERWOOD

_____192____ _____Scout

Form 26—1M Bks.—3-23—11959. S Sherwood

16 KANSAS 21 23 12
Map No. Sec. Twp. R.

Well No. 1 Mc Mellen

John Stacy Company

Contractor

COMPLETED

Ft. from N. Line


330 Ft. from S. Line

Ft. from E. Line

330 Ft. from W. Line

ABANDONED

SECTION PLAT

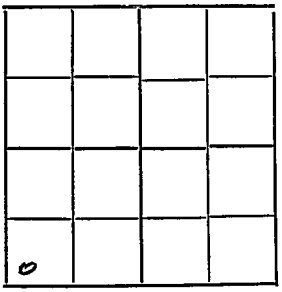

Location

Rig up

Drilling and Remarks:

Sand 1650-60.
Top lime 1847
DQ # 1951

RECORD

Cased in., ft.

Sand

Gas

Oil

Total Depth 1951

PRODUCTION

1st 24 hrs. Nat.

1st 24 hrs. after shot

Gas Cu. Ft.

Dry Hole ✓

Abandoned ✓

Date

APR 20 1927

192

CHAS. L. SHERWOOD

Scout