


Map No. _____ Sec. 11 Twp. 26 R. 4Well No. 4 Williams Farm _____Tropshooters Company _____

NORTH

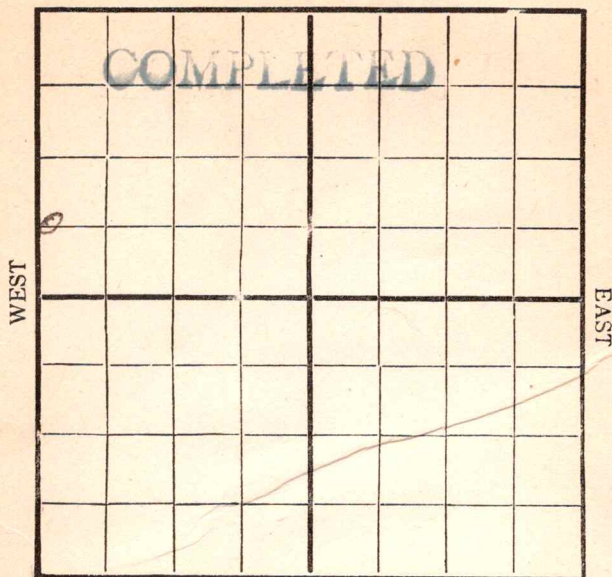

SOUTH

Location _____

Rig Up _____

Drilling Remarks:

Drilling Remarks:

RECORD

Cased _____ in _____ Ft.

Sand _____

Gas _____

Oil _____

Total Depth _____

PRODUCTION

1st 24 hrs. Nat. _____

1st 24 hrs. after shot _____


Gas _____ Cu. Ft.

Dry Hole _____

Abandoned _____

Map No. _____ Sec. 11 Twp. 26 R. 4Well No. 4 Williams FarmTrapshooters Oil Company

NORTH

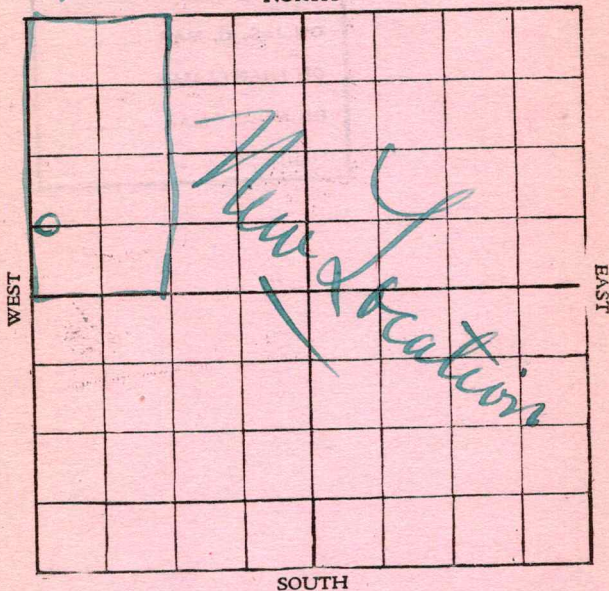

SOUTH

Location _____

Rig up _____

Drilling and remarks:

Rig.

RECORD

Cased _____ in. _____ Ft.

Sand _____

Gas _____

Oil _____

Total Depth _____

PRODUCTION

1st 24 hrs. Nat. _____

1st 24 hrs. after shot _____

Gas _____ Cu. Ft.

Dry Hole _____


Abandoned _____

Date

5/26, 1917 Crocker Scout

Map No. Sec. 11 Twp. 26 R. 4Well No. 4 Williams FarmTraphashorters Company

NORTH

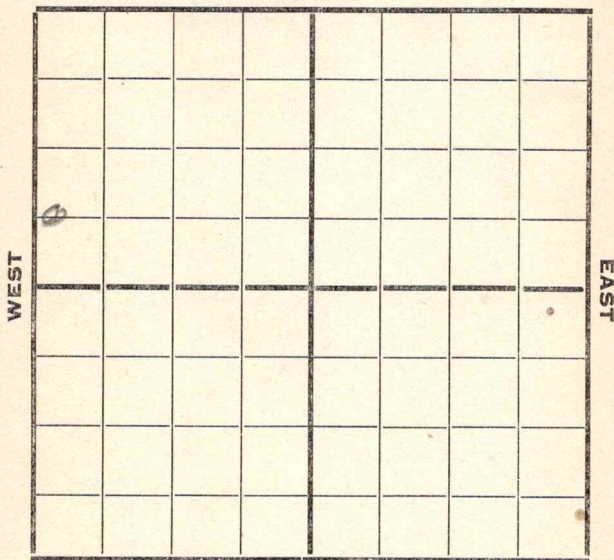

SOUTH

Location

Rig up

Drilling and Remarks:

Rig.

RECORD

Cased in. Ft.

Sand

Gas

Oil

Total Depth

PRODUCTION

1st 24 hrs. Nat.

1st 24 hrs. after shot

Gas Cu. Ft.

Dry Hole


Abandoned

Date

6/2, 1917,G. J. Crocker Scout

Map No. _____ Sec. 11 Twp. 26 R. 4Well No. 4 Williams Farm _____Eureka Oil Company _____

NORTH

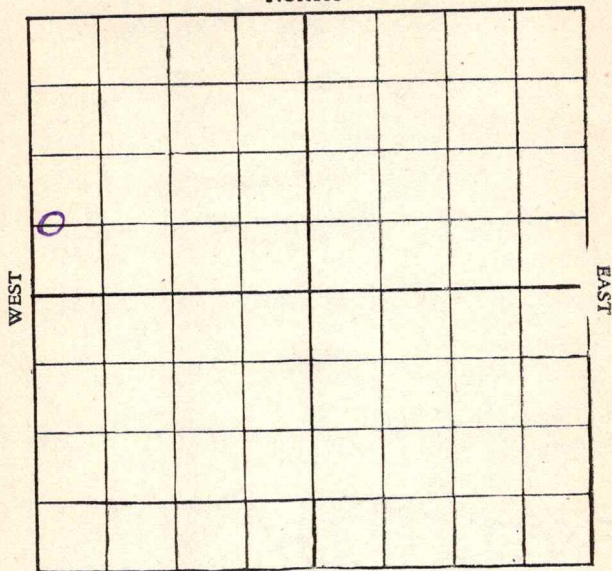

SOUTH

Location _____

Rig up _____

Drilling and remarks:

Rig.

RECORD

Cased _____ in. _____ Ft.

Sand _____

Gas _____

Oil _____

Total Depth _____

PRODUCTION

1st 24 hrs. Nat. _____

1st 24 hrs. after shot _____

Gas _____ Cu. Ft.

Dry Hole _____

Abandoned _____

Date


JUN 9 - 1917.

, 191. _____

Scout

Map No. _____ Sec. 11 Twp. 26 R. 4Well No. 4 Williams FarmTrapshooters Company

NORTH

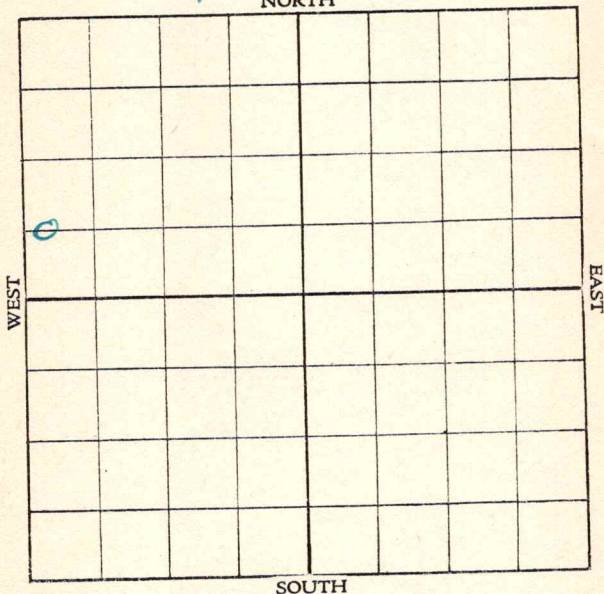

SOUTH

Location _____

Rig up _____

Drilling and remarks:

D-450'

RECORD

Cased _____ in. _____ Ft.

Sand _____

Gas _____

Oil _____

Total Depth _____

PRODUCTION

1st 24 hrs. Nat. _____

1st 24 hrs. after shot _____

Gas _____ Cu. Ft.

Dry Hole _____

Abandoned _____

Date

JUN 16 1917

, 191


E. J. Crocker Scout

Map No. _____ Sec. 11 Twp. 26 R. 4

Well No. 4 Williams Farm

Trapshooters Company

NORTH

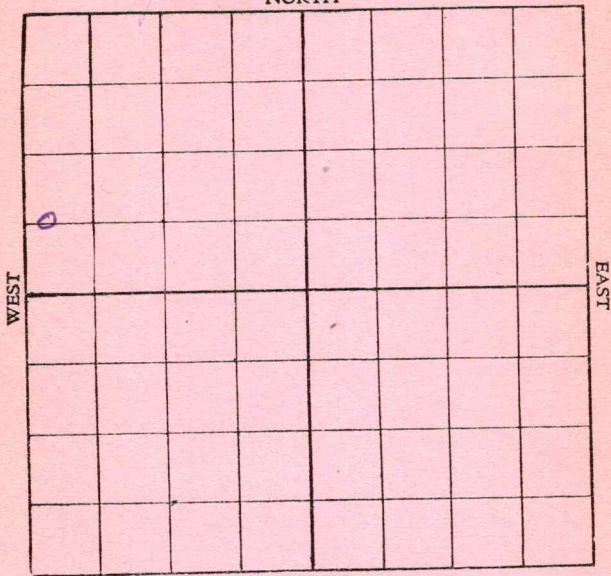

SOUTH

Location _____

Rig up _____

Drilling and remarks:

D-475

RECORD

Cased _____ in. _____ Ft.

Sand _____

Gas _____

Oil _____

Total Depth _____

PRODUCTION

1st 24 hrs. Nat. _____

1st 24 hrs. after shot _____

Gas _____ Cu. Ft.

Dry Hole _____

Abandoned _____

Date

JUN 22 1917

, 191


C. J. Crocker
Scout

Map No. _____ Sec. 11 Twp. 26 R. 4

Well No. 4 Williams Farm

Eureka Oil Company

NORTH

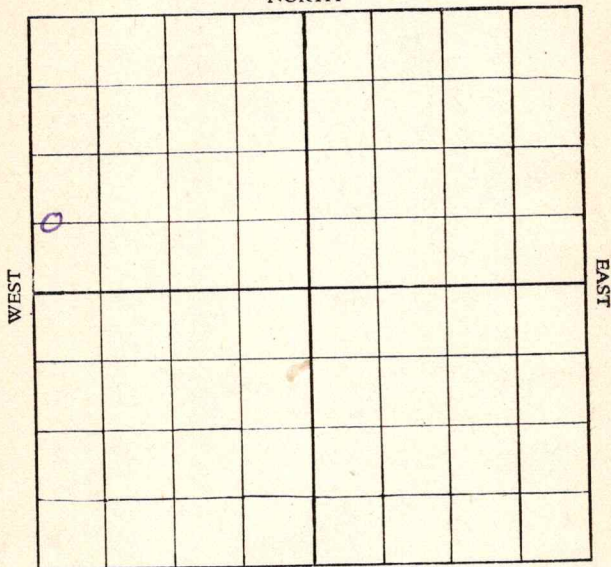

SOUTH

Location _____

Rig up _____

Drilling and remarks:

D-840'

RECORD

Cased _____ in. _____ Ft.

Sand _____

Gas _____

Oil _____

Total Depth _____

PRODUCTION

1st 24 hrs. Nat. _____

1st 24 hrs. after shot _____

Gas _____ Cu. Ft.

Dry Hole _____

Abandoned _____

Date JUN 30 1917


_____, 191____, G. T. Crocker, Scout

Map No. _____ Sec. 11 Twp. 26 R. 4

Well No. 4 Williams Farm

Eureka Oil Company

NORTH

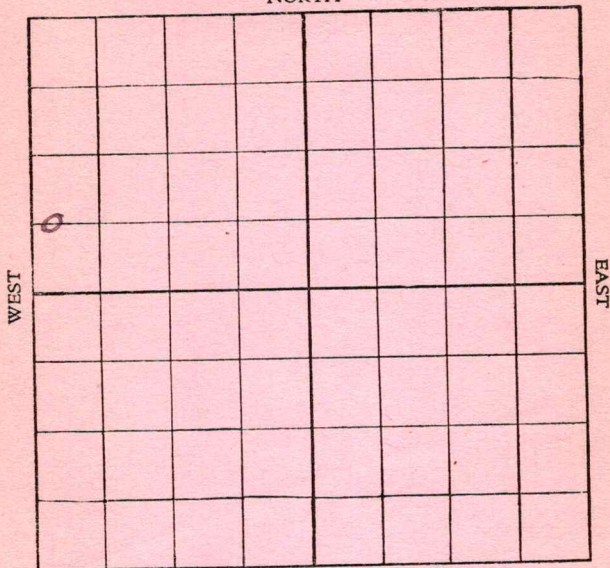

SOUTH

Location _____

Rig up _____

Drilling and remarks:

D-1185'

RECORD

Cased _____ in. _____ Ft.

Sand _____

Gas _____

Oil _____

Total Depth _____

PRODUCTION

1st 24 hrs. Nat. _____

1st 24 hrs. after shot _____

Gas _____ Cu. Ft.

Dry Hole _____


Abandoned _____

Date JUL 7 1917

E. J. Crocker Scout

Map No. _____ Sec. 11 Twp. 26 R. 4Well No. 4 Williams FarmProp Shooter Company

NORTH

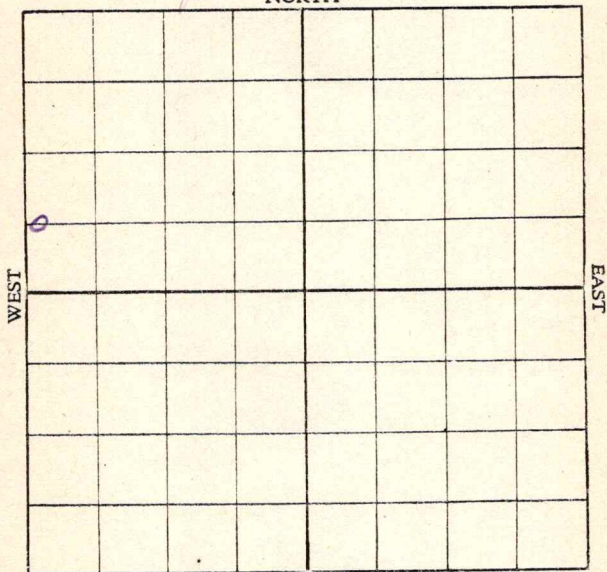

SOUTH

Location _____

Rig up _____

Drilling and remarks:

D-1250'

RECORD

Cased _____ in. _____ Ft.

Sand _____

Gas _____

Oil _____

Total Depth _____

PRODUCTION

1st 24 hrs. Nat. _____

1st 24 hrs. after shot _____

Gas _____ Cu. Ft.

Dry Hole _____

Abandoned _____

Date


JUL 14 1917

E. J. Crocker Scout

Map No. Sec. 11, Twp. 26, R. 4

Well No. 4 Williams

Trapshooters Company

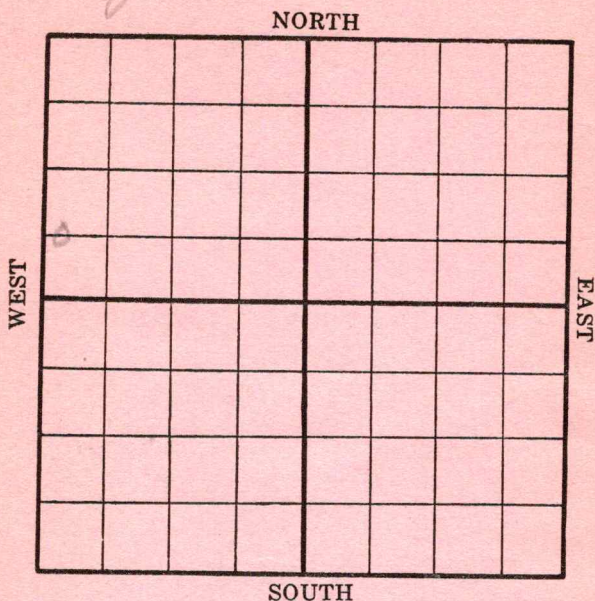

Location

Rig up

Drilling and remarks:

RECORD

Cased.....in,Ft.

Sand

Gas

Oil

Total Depth

PRODUCTION

1st 24 hrs. Nat.....

1st 24 hrs. after shot.....

Gas.....Cu. ft.

Dry Hole

Abandoned

Date

7/17 191 2 Scout

Map No. _____ Sec. 11 Twp. 26 R. 4
 Well No. 4 Williams Farm _____
Cummins Oil Company _____

NORTH

WEST EAST

SOUTH

Location _____
 Rig Up _____
 Drilling and remarks _____

1900

RECORD

Cased _____ in. _____ Ft.
 Sand _____
 Gas _____
 Oil _____
 Total Depth _____

PRODUCTION


1st 24 hrs. Nat. _____
 1st 24 hrs. after shot _____
 Gas _____ Cu. Ft.
 Dry Hole _____
 Abandoned _____

Date 8/1, 1912 Carley Scout

Map No. _____ Sec. 41 Twp. 26 R. 4Well No. 4 Williams FarmEmcke Company

NORTH

WEST

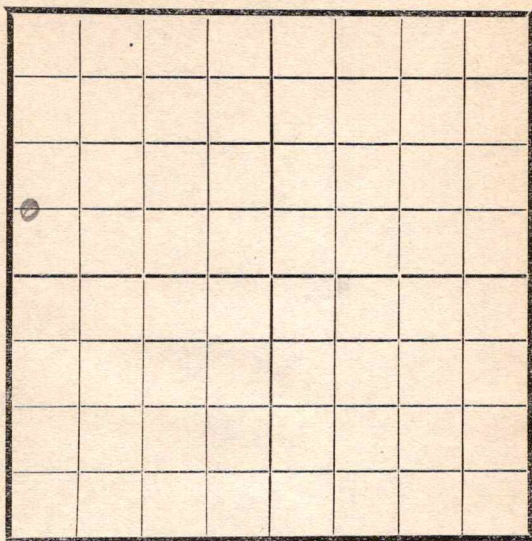

EAST

SOUTH

Location _____

Rig Up _____

Drilling and remarks

Top sand2366

RECORD

Cased _____ in. _____ Ft.

Sand _____

Gas _____

Oil _____

Total Depth _____

PRODUCTION

1st 24 hrs. Nat. _____

1st 24 hrs. after shot _____

Gas _____ Cu. Ft.

Dry Hole _____

Abandoned _____


Date

8/9, 1917 C. Emcke Scout

Map No. _____ Sec. 11 Twp. 26 R. 4
 Well No. 4 Williams Farm _____
Eureka Oil Company

NORTH

WEST

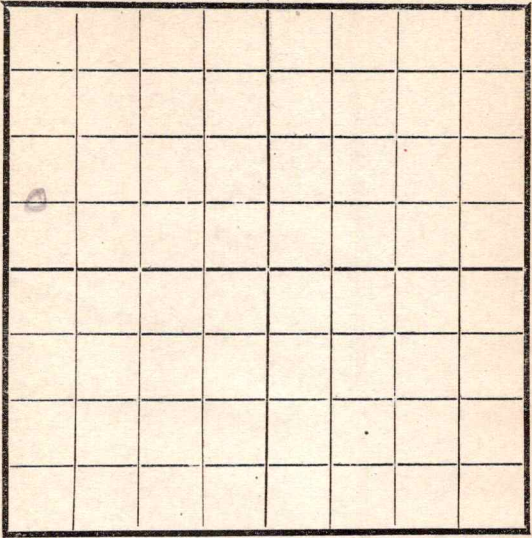

EAST

SOUTH

Location _____
 Rig Up _____
 Drilling and remarks

Tap and 2366
2385

RECORD

Cased _____ in. _____ Ft.
 Sand _____
 Gas _____
 Oil _____
 Total Depth _____

PRODUCTION

1st 24 hrs. Nat. _____
 1st 24 hrs. after shot _____
 Gas _____ Cu. Ft.
 Dry Hole _____
 Abandoned _____


Date

8/17, 1917 Candy Scout

Map No. _____ Sec. 11 Twp. 26 R. 4Well No. H. Williams FarmTrap shooter Company

NORTH

WEST

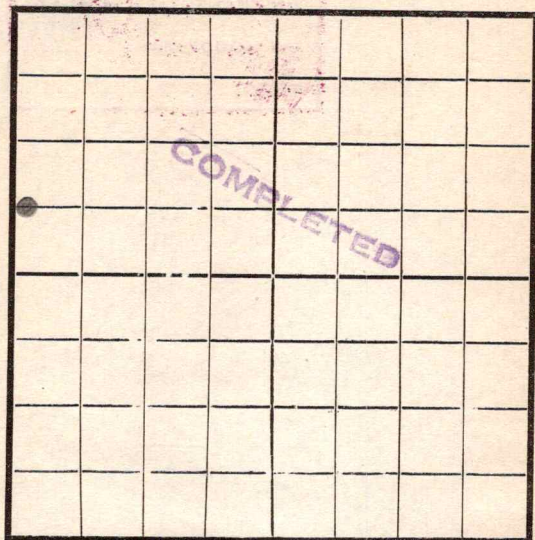

EAST

SOUTH

Location _____

Rig Up _____

Drilling and remarks _____

RECORD

Cased _____ in. _____ Ft.

Sand 2368-2401

Gas _____

Oil ☒ _____Total Depth 2401

PRODUCTION

1st 24 hrs. Nat. 300 Bbls

1st 24 hrs. after shot _____

Gas _____ Cu. Ft.

Dry Hole _____

Abandoned _____

Date

8-24, 1917 Lantz Scout