


Map No. KANSAS Sec. 28 Twp. 23 R. 11E

Well No. 2 Beal Farm
Harry Gore et al Company

NORTH

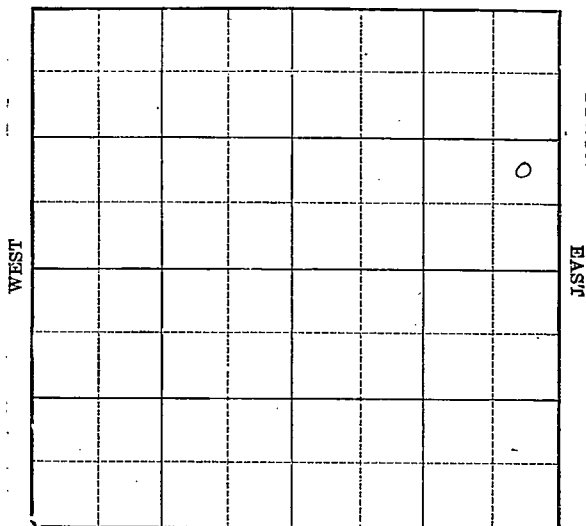

SOUTH

Location _____

Drilling Remarks _____

Rig Up _____

Drilling Remarks _____

RECORD

Cased _____ in. _____ ft.

Sand _____

Gas _____

Oil _____

Total Depth _____

PRODUCTION

1st 24 hrs. Nat. _____

1st 24 hrs. after shot _____

Gas _____ cu. ft. _____


Dry Hole _____

Abandoned _____

Map No. **KANSAS** Sec. 28 Twp. 23 R. 11^E

Well No. 2- Beal Farm
Harry Gore et al Company

NORTH

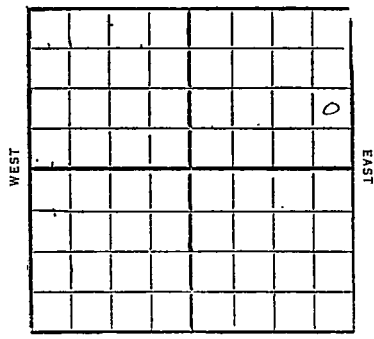

 Ft. from N. Line

990 Ft. from S. Line

330 Ft. from E. Line

 Ft. from W. Line

1931

Date

REPORT

8/19 Run up
8/26
9/2
9/19 Drill 510'
9/16 " 1260'
9/23 SD 1897 show oil
9/30 Land 1884-1948
TD. 1950
shot 260 at 1893-1950
swab 190 bbl 12 hr
Cleaned out &
swab 264, bbl 12 hr
10/7 Cased 6"-1884
Land 1884-1948
TD. 1950
shot 260 at 1893-1950
200 bbl oil
C.O.M.P.

Map No. **KANSAS**Sec. **28**Twp. **23**R. **11**

E

Well No. **2****Beal****Harry Goss et al** Company

Contractor

FIRST REPORTS

Ft. from N. Line

990 Ft. from S. Line**330** Ft. from E. Line

Ft. from W. Line

SECTION PLAT

			0

Location

Rig up

Drilling and Remarks:

Rigging up.

RECORD

Cased in., ft.

Sand

Gas

Oil

Total Depth

PRODUCTION

1st 24 hrs. Nat.

1st 24 hrs. after shot

Gas Cu. Ft.

Dry Hole

Abandoned

Date

AUG 1 9 1931 CHAS. L. SHERWOOD

192

Scout

16
 Map No. KANSAS Sec. 28 Twp. 23 R. 11 ^E
 Well No. 2 Beal
Harry Gore & Co Company
 Contractor

COMPLETED

SECTION PLAT

.....Ft. from N. Line
990 Ft. from S. Line
330 Ft. from E. Line
Ft. from W. Line

			0

Location.....

Rig up.....

Drilling and Remarks:.....

1893-1950
760 / 200 Beal

RECORD

Cased 6 in., 1884 ft.Sand 1884 - 1948

Gas.....

Oil.....

Total Depth 1950

PRODUCTION

1st 24 hrs. Nat.

1st 24 hrs. after shot.....

Gas..... Cu. Ft.

Dry Hole.....

Abandoned.....

Date

OCT 7 1931

CHAS. L. SHERWOOD

192

Scout