

Greenwood

Form 51-5M-11-31-Palace

Map No. **KANSAS** Sec.


Twp.

R.

Well No.

Farm

Company

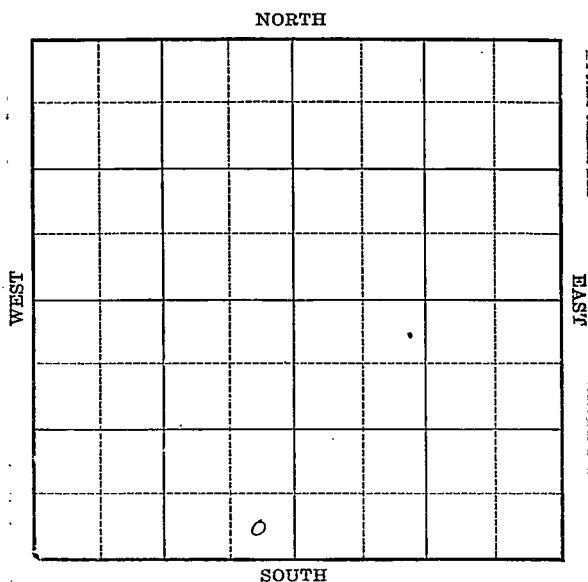

Location

Drilling Remarks

Rig Up

Drilling Remarks

RECORD

Cased in. ft.

Sand

Gas

Oil

Total Depth

PRODUCTION

1st 24 hrs. Nat.

1st 24 hrs. after shot

Gas cu. ft.

Dry Hole

Abandoned

Map No. **KANSAS** Sec. 20 Twp. 23 R. 11

Well No. 122 Blal Farm

M^c Ginnis et al Company

[illegible]

WEST

EAST

SOUTH

Ft. from W. Line

REPORT

Log
Run up
No resort
Dplg 11430'
Sand 1950-92 dry
Top line 2025
ID 2048
Dry & Abandon

Greenwood

16 KANSAS

Map No. Sec. 28 Twp. 23 R. 11^E

Well No. 1 Bear

Mc Ginnis & Co Company

Contractor

FIRST REPORTS

SECTION PLAT

Ft. from N. Line

330 Ft. from S. Line

330 Ft. from E. Line

Ft. from W. Line

Location ✓

Rig up

Drilling and Remarks:

RECORD

Cased in. ft.

Sand

Gas

Oil

Total Depth

PRODUCTION

1st 24 hrs. Nat.

1st 24 hrs. after shot

Gas Cu. Ft.

Dry Hole

Abandoned

Date

MAR 2 1932

19

CHAS. L. SHERWOOD

Scout

Greenwood

E

16 KANSAS Map No. Sec. 28 Twp. 23 R. 11

Well No. 1 Beal

Mc Ginnis & al Company

Contractor

COMPLETED

SECTION PLAT

Ft. from N. Line

330 Ft. from S. Line

330 Ft. from E. Line

Ft. from W. Line

ABANDONED

Location

Rig up

Drilling and Remarks:

Top Line 2055

D+G 2048

RECORD

Cased in., ft.

Sand 1950-1997 Bu

Gas

Oil

Total Depth 2048

PRODUCTION

1st 24 hrs. Nat.

1st 24 hrs. after shot

Gas Cu. Ft.

Dry Hole

Abandoned

Date

APR 6 1932

CHAS. L. SHERWOOD

Scout