


Map No. _____ Sec. 12 Twp. 26 R. 4
 Well No. 21 Enyart Farm _____
Empire Company _____

NORTH

WEST

EAST

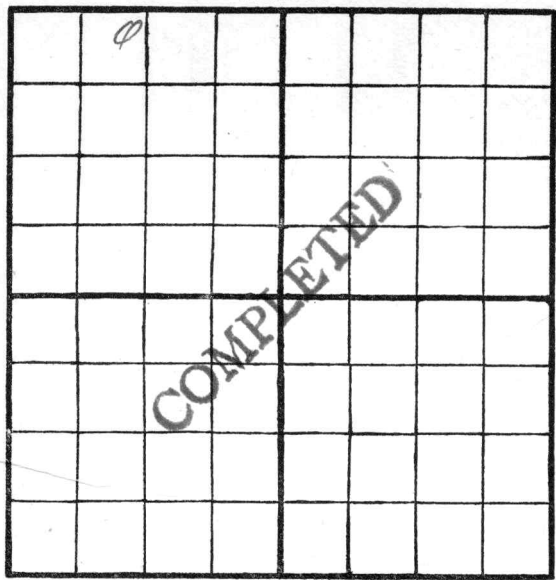

SOUTH

Location _____

Rig Up _____

Drilling Remarks:

Drilling Remarks:

RECORD


PRODUCTION

Cased _____ in. _____ ft.
 Sand _____
 Gas _____
 Oil _____
 Total Depth _____

1st 24 hrs. Nat. _____
 1st 24 h.s. after shot _____
 Gas _____ cu. ft
 Dry Hole _____
 Abandoned _____

Map No. K14 Sec. 12 Twp. 26 R. 4
 Well No. 31 E. Bryant Farm
Bryant Company

NORTH

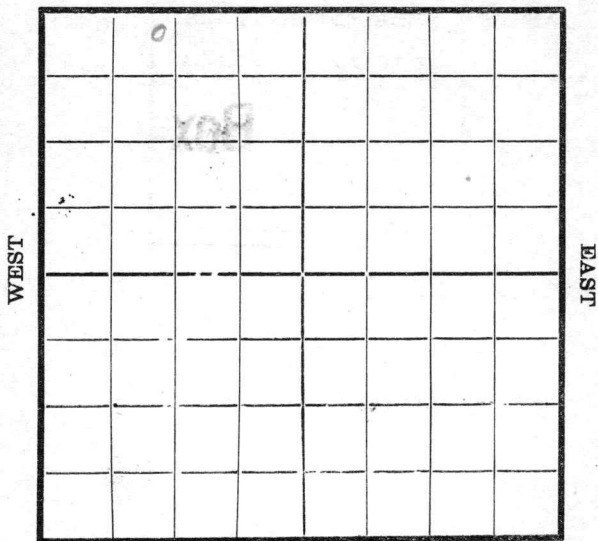

SOUTH

Location _____
 Rig Up ☒ _____
 Drilling and remarks _____

RECORD

Cased _____ in. _____ Ft.
 Sand _____
 Gas _____
 Oil _____
 Total Depth _____

PRODUCTION

1st 24 hrs. Nat. _____
 1st 24 hrs. after shot _____
 Gas _____ Cu. Ft.
 Dry Hole _____
 Abandoned _____

FIRST REPORT

Date

10/5, 1917 C. Conley Scout


Map No. _____ Sec. 12 Twp. 26 R. 4

Well No. 21 _____ Farm

Engine 897 _____ Company

NORTH

WEST

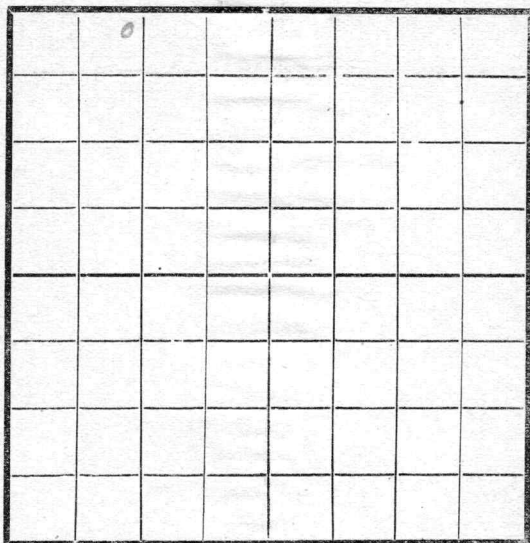

EAST

SOUTH

Location _____

Rig Up _____

Drilling and remarks

RECORD

Cased _____ in. _____ Ft.

Sand _____

Gas _____

Oil _____

Total Depth _____

PRODUCTION

1st 24 hrs. Nat. _____

1st 24 hrs. after shot _____

Gas _____ Cu. Ft.

Dry Hole _____


Abandoned _____

Date

1/2, 1918 S. Condy Scout

Map No. _____ Sec. 12 Twp. 26 R. 4Well No. 21 E. EngleEngle Company

NORTH

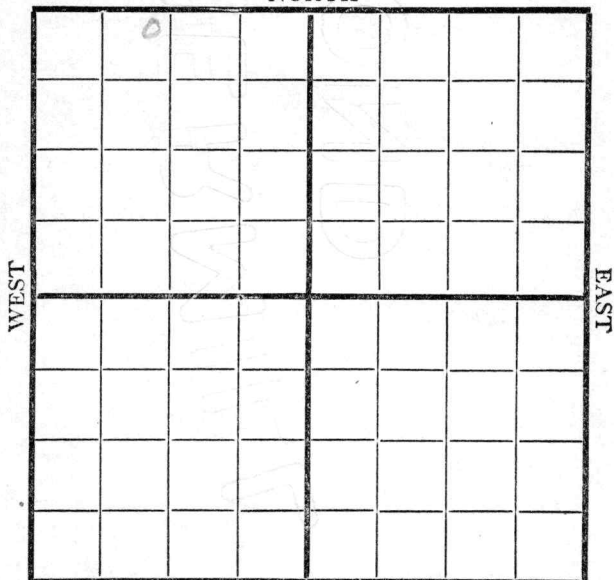

SOUTH

Location _____

Rig up _____

Drilling and Remarks:

Rigging up(Hance Bros)
E. Engle

RECORD

Cased _____ in., _____ ft.

Sand _____

Gas _____

Oil _____

Total Depth _____

PRODUCTION

1st 24 hrs. Nat. _____

1st 24 hrs. after shot _____

Gas _____ Cu. Ft.

Dry Hole _____

Abandoned _____

Date

APR 3 1918

191


Carley

Scout

Map No. _____ Sec. 12 Twp. 26 R. 4
 Well No. 21 Empire Farm _____
Empire Company

NORTH

WEST

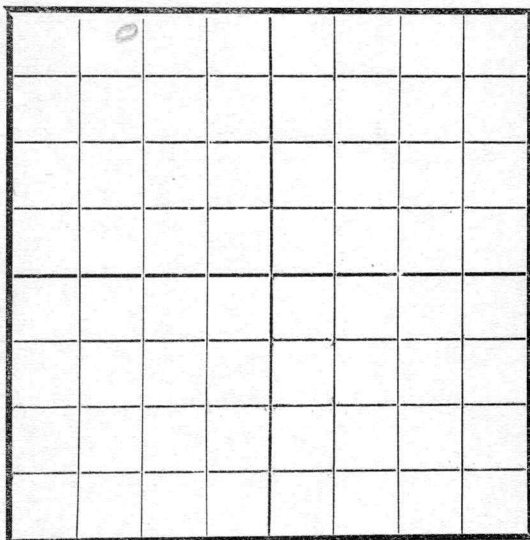

EAST

SOUTH

Location _____
 Rig Up _____
 Drilling and remarks

550

RECORD

Cased _____ in. _____ Ft.
 Sand _____
 Gas _____
 Oil _____
 Total Depth _____

PRODUCTION

1st 24 hrs. Nat. _____
 1st 24 hrs. after shot _____
 Gas _____ Cu. Ft.
 Dry Hole _____
 Abandoned _____


Date

4/17, 1918 S. Carberry Scout

Map No. _____ Sec. 12 Twp. 26 R. 4Well No. 21 Emyart Farm _____Company Emyart

NORTH

WEST

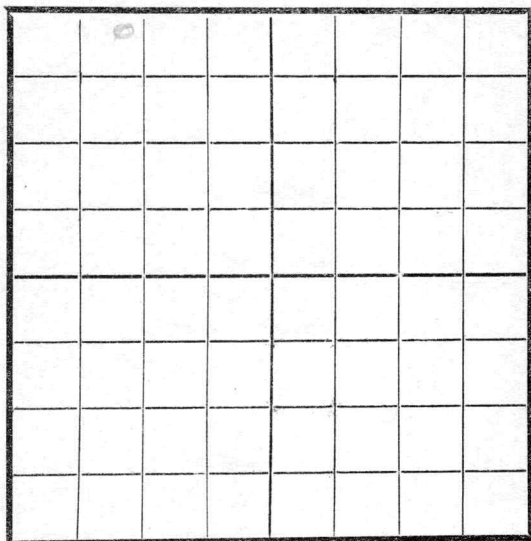

EAST

SOUTH

Location _____

Rig Up _____

Drilling and remarks

965.

RECORD

Cased _____ in _____ Ft.

Sand _____

Gas _____

Oil _____

Total Depth _____

PRODUCTION

1st 24 hrs. Nat. _____

1st 24 hrs. after shot _____

Gas _____ Cu. Ft.

Dry Hole _____

Abandoned _____

Date

4/24, 1918 S. Conley Scout


Map No. _____ Sec. 12 Twp. 26 R. 4

Well No. 31 _____ Farm _____

_____ Company _____

NORTH

WEST

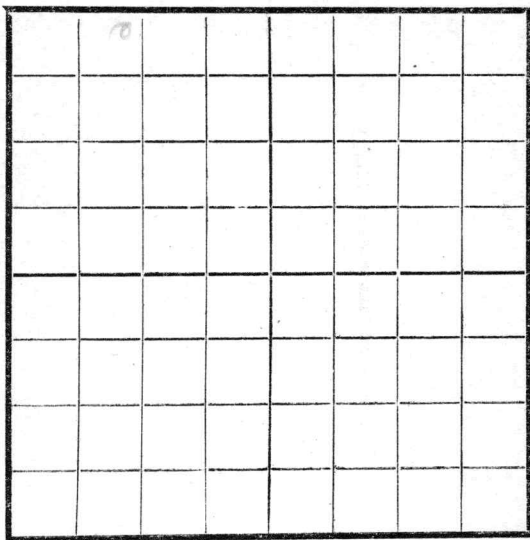

EAST

SOUTH

Location _____

Rig Up _____

Drilling and remarks

1325

RECORD

Cased _____ in. _____ Ft.

Sand _____

Gas _____

Oil _____

Total Depth _____

PRODUCTION

1st 24 hrs. Nat. _____

1st 24 hrs. after shot _____

Gas _____ Cu. Ft.

Dry Hole _____

Abandoned _____


Date

5/, 1918 Scout

Map No. _____ Sec. 12 Twp. 36 R. 4Well No. 21 Camp Farm _____
Camp Company _____

NORTH

WEST

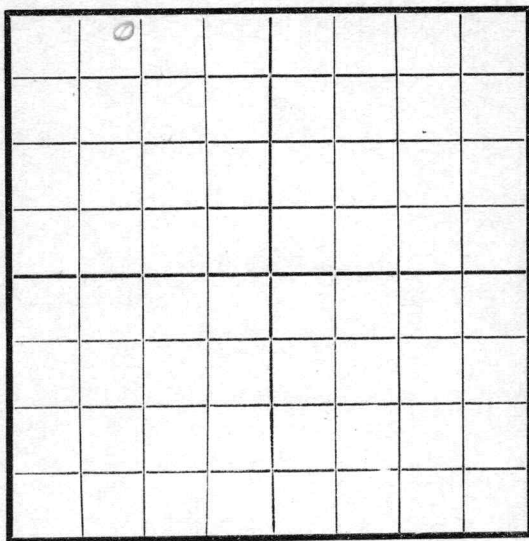

EAST

SOUTH

Location _____

Rig Up _____

Drilling and remarks

1655

RECORD

Cased _____ in. _____ Ft.

Sand _____

Gas _____

Oil _____

Total Depth _____

PRODUCTION

1st 24 hrs. Nat. _____

1st 24 hrs. after shot _____

Gas _____ Cu. Ft.

Dry Hole _____


Abandoned _____

Date

578, 191 8 Camp Scout

Map No. _____ Sec. 12 Twp. 26 R. 4
 Well No. 21 Engine Farm _____
Engine Company _____
 NORTH

WEST

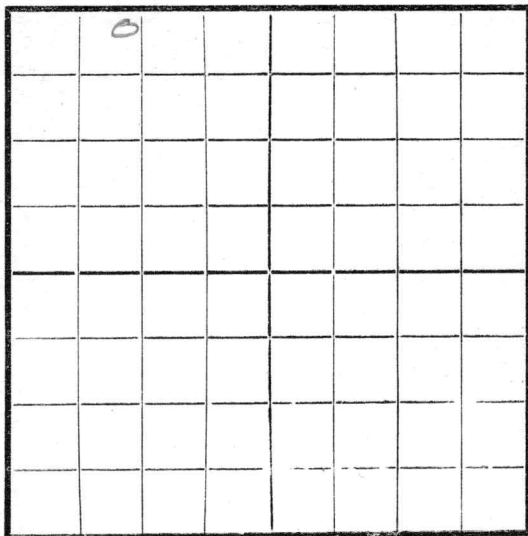

EAST

SOUTH

Location _____

Rig Up _____

Drilling and remarks

1800

RECORD

Cased _____ in. _____ Ft.

Sand _____

Gas _____

Oil _____

Total Depth _____

PRODUCTION

1st 24 hrs. Nat. _____

1st 24 hrs. after shot _____

Gas _____ Cu. Ft.

Dry Hole _____

Abandoned _____

Date

5/15 Scout


191

Scout

Map No. _____ Sec. 12 Twp. 26 R. 4Well No. 21 August Farm _____
August Company

NORTH

WEST

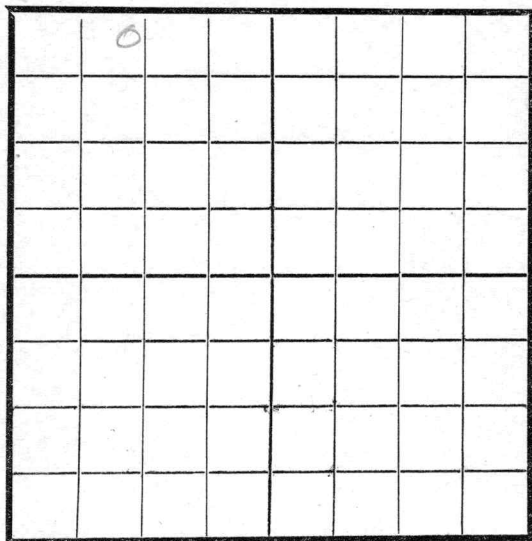

EAST

SOUTH

Location _____

Rig Up _____

Drilling and remarks

1960

RECORD

Cased _____ in. _____ Ft.

Sand _____

Gas _____

Oil _____

Total Depth _____

PRODUCTION

1st 24 hrs. Nat. _____

1st 24 hrs. after shot _____

Gas _____ Cu. Ft.

Dry Hole _____

Abandoned _____

Date

5/22, 1918 Condy Scout


Map No. _____ Sec. 12 Twp. 26 R. 4

Well No. 21 Farm _____

Company _____

NORTH

WEST

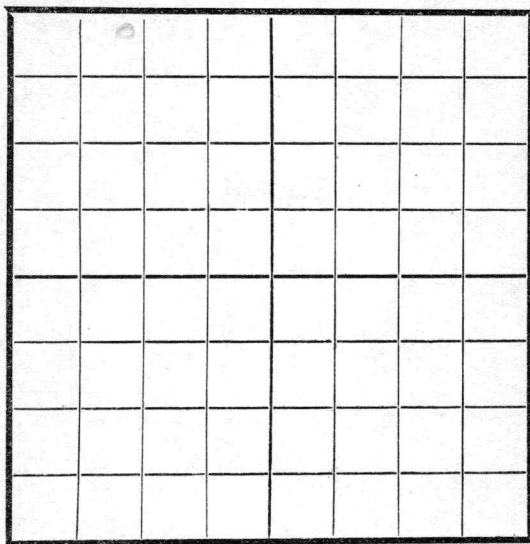

EAST

SOUTH

Location _____

Rig Up _____

Drilling and remarks

RECORD

Cased _____ in. _____ Ft.

Sand _____

Gas _____

Oil _____

Total Depth _____

PRODUCTION

1st 24 hrs. Nat. _____

1st 24 hrs. after shot _____

Gas _____ Cu. Ft.

Dry Hole _____

Abandoned _____

Date


5/29, 1918 Scout

Map No. _____ Sec. 12 Twp. 26 R. 4

Well No. 21 E. myant Farm _____
Engine Company _____

NORTH

WEST

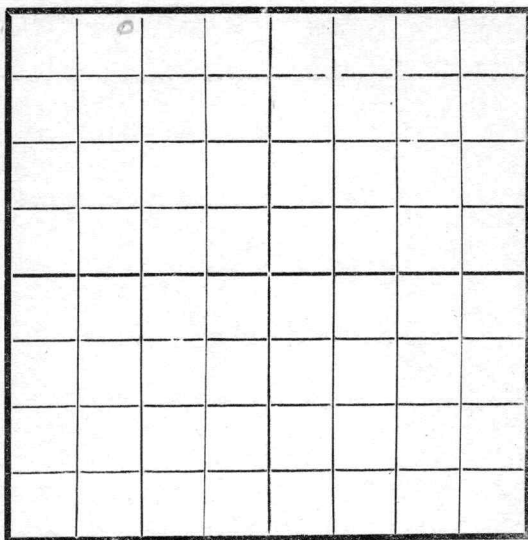

EAST

SOUTH

Location _____

Rig Up _____

Drilling and remarks

p.s.
2090

RECORD

Cased _____ in. _____ Ft.

Sand _____

Gas _____

Oil _____

Total Depth _____

PRODUCTION

1st 24 hrs. Nat. _____

1st 24 hrs. after shot _____

Gas _____ Cu. Ft.

Dry Hole _____


Abandoned _____

Date

6/5, 1911 Scout

Map No. _____ Sec. 12 Twp. 26 R. 4Well No. 21 Euphant_____Euphant Company_____Euphant Contractor

NORTH

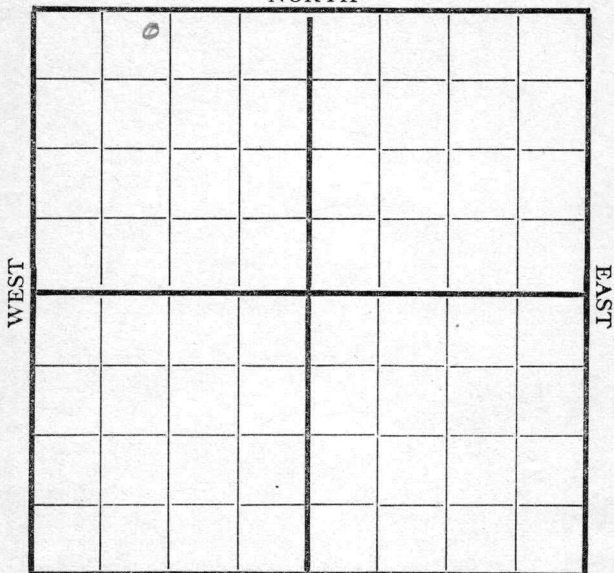

SOUTH

Location _____

Rig up _____

Drilling and Remarks:

22
2090

RECORD

Cased _____ in., _____ ft.

Sand _____

Gas _____

Oil _____

Total Depth _____

PRODUCTION

1st 24 hrs. Nat. _____

1st 24 hrs. after shot _____

Gas _____ Cu. Ft.

Dry Hole _____

Abandoned _____

Date


6/13 1918 E. Euphant Scout

Map No. _____ Sec. 12 Twp. 26 R. 4Well No. 21 Empire Farm _____

Company _____

NORTH

WEST

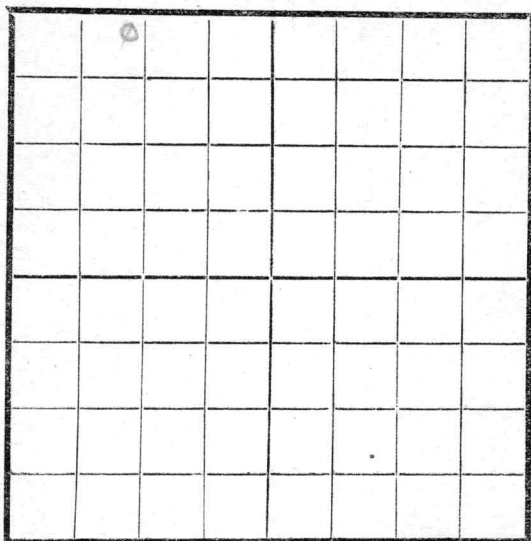

EAST

SOUTH

Location _____

Rig Up _____

Drilling and remarks

2225

RECORD

Cased _____ in. _____ Ft.

Sand _____

Gas _____

Oil _____

Total Depth _____

PRODUCTION

1st 24 hrs. Nat. _____

1st 24 hrs. after shot _____

Gas _____ Cu. Ft.

Dry Hole _____

Abandoned _____

Date


6/19, 1918 Conley Scout

SOUTH

Date _____

Map No. K 14 Sec. 12 Twp. 26 R. 4Well No. 21 EngineEngine CompanyHouse Bros. ContractorEl Dorado NORTH 16

WEST

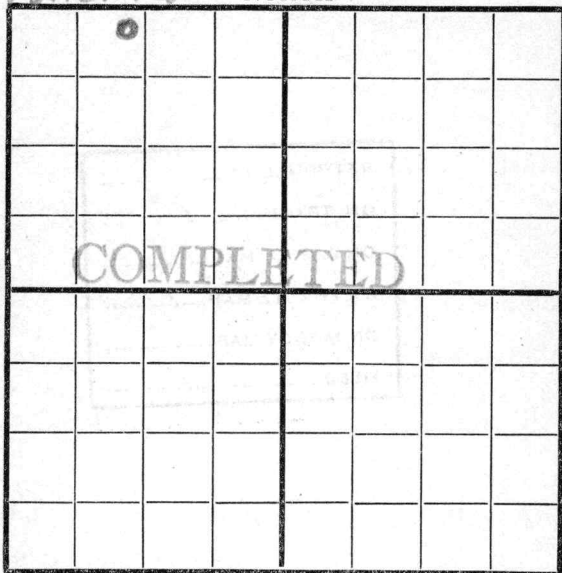

EAST

SOUTH

Location _____

Rig up _____

Drilling and Remarks:

Est at
3600
1260

RECORD

Cased _____ in., _____ ft.

Sand 2356-2398

Gas _____

Oil _____

Total Depth _____

PRODUCTION

1st 24 hrs. Nat. _____

1st 24 hrs. after shot _____

Gas _____ Cu. Ft.

Dry Hole _____

Abandoned _____

Date

7/3 191 8 C. C. C. C. Scout