
Form 51—5M—7-25—19786

Map No. K Sec. 29 Twp. 23 R. 11

Well No. 1 Wilson Farm

Sharples et al Company

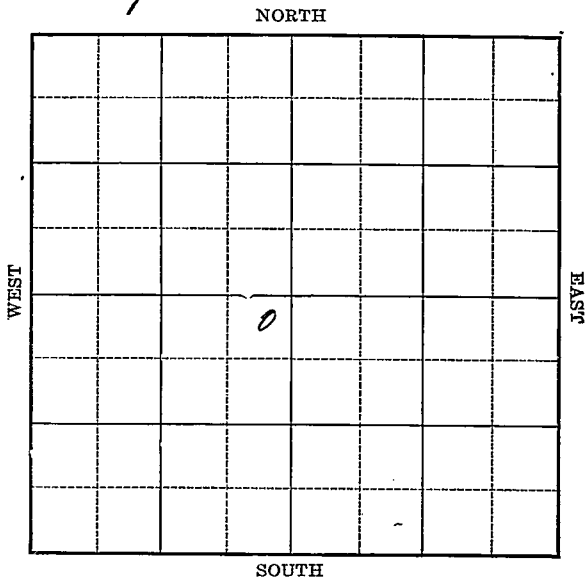

Location

Drilling Remarks

Rig Up

Drilling Remarks

RECORD

Cased in. ft.

Sand

Gas

Oil

Total Depth

PRODUCTION

1st 24 hrs. Nat.

1st 24 hrs. after shot

Gas cu. ft.

Dry Hole

Abandoned

Form 252A—5M—11-25—20913 Greenwood

Map No. Kansas Sec. 29 Twp. 23 R. 11

Well No. 1 Wilson Farm


Sharples etal Company

250 Ft. from N. Line

_____ Ft. from S. Line

250 Ft. from E. Line

_____ Ft. from W. Line

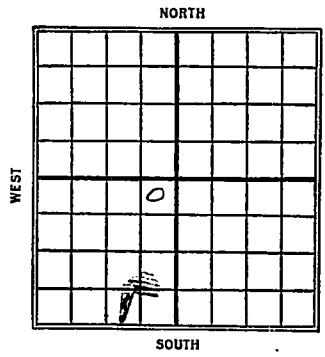

Date 1926	REPORT
6/9	Location
6/18	R.O.9.
6/25	Spudding
6-30	
7/8	Dlg 500'
7/15	" 850
7/22	" 1215
7/28	" 1600
8/4	top lime 2030 - DTA 2080
	TD 2080

Form 26—1M Bks.—3-23—11959. S Sherwood

K-16 KANSAS Map No. Sec. 29 Twp. 23 R. 11

Well No. 1 Wilson

Sharpless et ux Company

Contractor

FIRST REPORTS


250 Ft. from N. Line

Ft. from S. Line

250 Ft. from E. Line

Ft. from W. Line

SECTION PLAT

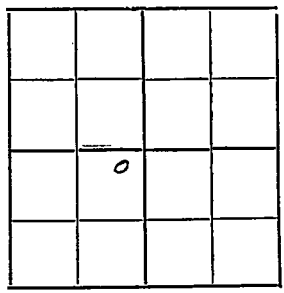

Location ✓

Rig up

Drilling and Remarks:

RECORD

Cased in., ft.

Sand

Gas

Oil

Total Depth

PRODUCTION

1st 24 hrs. Nat.

1st 24 hrs. after shot

Gas Cu. Ft.

Dry Hole

Abandoned

Date

JUN 9 1926

192

CHAS. L. SHERWOOD

Scout

Form 26—1M Bks.—3-23—11959. Glenwood

K16 KANSAS Map No. _____ Sec. 29 Twp. 23 R. 11

Well No. 1 Wilson

Sharpless et al _____ Company

_____ Contractor

COMPLETED

350 _____ Ft. from N. Line


_____ Ft. from S. Line

350 _____ Ft. from E. Line

_____ Ft. from W. Line

ABANDONED

SECTION PLAT

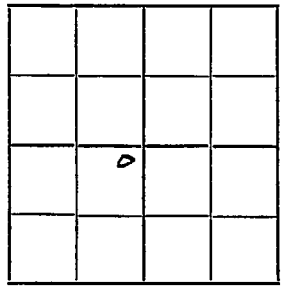

Location _____

Rig up _____

Drilling and Remarks:

Top Lime 2020

DRY 2080

RECORD

Cased _____ in., _____ ft.

Sand _____

Gas _____

Oil _____

Total Depth 2080

PRODUCTION

1st 24 hrs. Nat. _____

1st 24 hrs. after shot _____

Gas _____ Cu. Ft.

Dry Hole V

Abandoned V

Date

AUG 4 1926

_____ 192____.

CHAS. L. SHERWOOD

_____ Scout