
Form 51—5 17—2M

Map No. _____ Sec. 11 Twp. 26 R. 4

Well No. 14 Shumway Farm

Gypsy Company

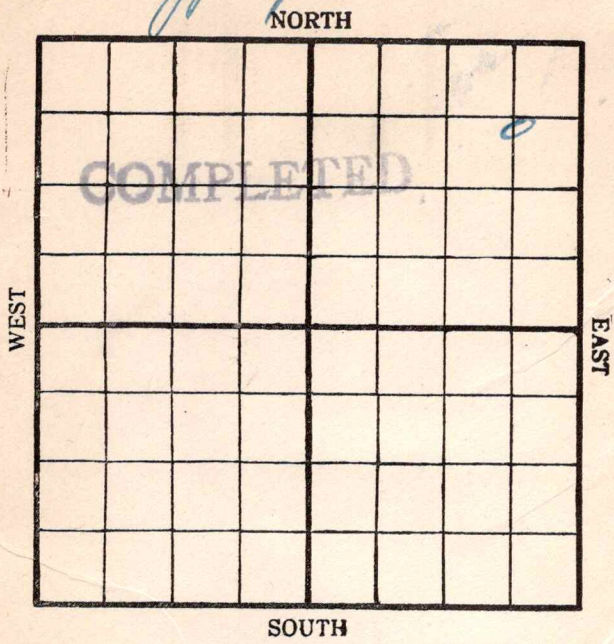

Location _____

Drilling Remarks:

Rig Up _____

Drilling Remarks:

RECORD

Cased _____ in. _____ ft.

Sand _____

Gas _____

Oil _____

Total Depth _____

PRODUCTION

1st 24 hrs. Nat. _____

1st 24 hrs. after shot _____

Gas _____ cu. ft

Dry Hole _____

Abandoned _____


Form 26—1M Books of 100 Sheets Each.

Map No. K17 Sec. 11 Twp. 26 R. 4

Well No. 14 Shumway Farm

Lupay Company

NORTH

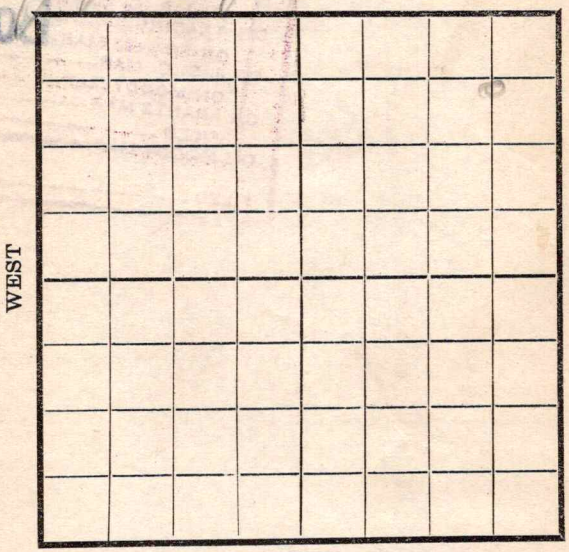

SOUTH

Location

Rig Up

Drilling and remarks

FIRST REPORT

RECORD

Cased in. Ft.

Sand

Gas

Oil

Total Depth

PRODUCTION

1st 24 hrs. Nat.

1st 24 hrs. after shot

Gas Cu. Ft.

Dry Hole

Abandoned

Date

8/17, 191 Cordy Scout


Form 26—1M Books of 100 Sheets Each.

Map No. _____ Sec. 14 Twp. 26 R. 4

Well No. 14 D Shumway Farm

Gypsy Company

NORTH

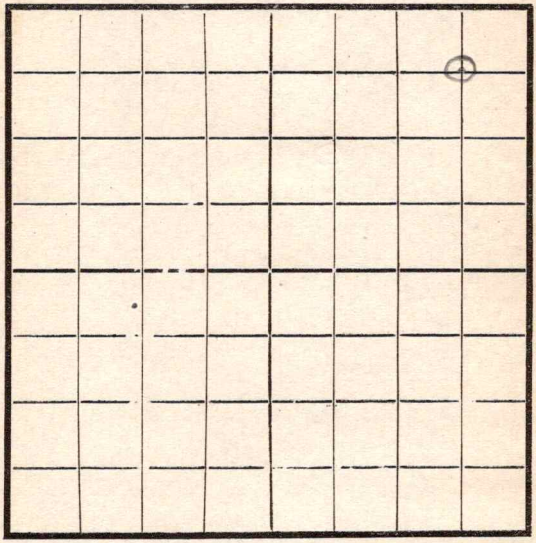

WEST EAST

SOUTH

Location _____

Rig Up ✓ _____

Drilling and remarks

RECORD

Cased _____ in. _____ Ft.

Sand _____

Gas _____

Oil _____

Total Depth _____

PRODUCTION

1st 24 hrs. Nat. _____

1st 24 hrs. after shot _____

Gas _____ Cu. Ft.

Dry Hole _____

Abandoned _____

Date

8-24, 1917 Lantz Scout


Form 26—1M Books of 100 Sheets Each.

Map No._____ Sec. 11 Twp. 26 R. 4

Well No. 14 Shumway Farm

Gypsy Company

NORTH

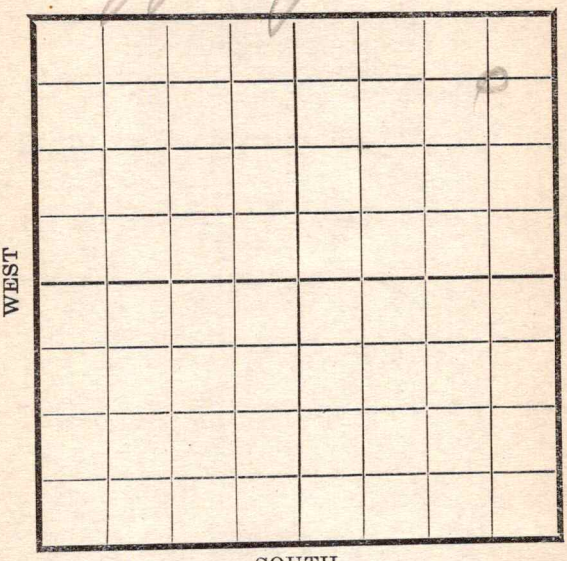

WEST

EAST

SOUTH

Location _____

Rig Up _____

Drilling and remarks

Fishing 800

RECORD

Cased_____ in._____Ft.

Sand _____

Gas _____

Oil _____

Total Depth _____

PRODUCTION

1st 24 hrs. Nat._____

1st 24 hrs. after shot_____

Gas _____ Cu. Ft.

Dry Hole _____

Abandoned _____

Date

10/9, 191__. J Cundy Scout


Form 26—1M Books of 100 Sheets Each.

Map No._____ Sec. 11 Twp. 26 R. 4

Well No. 14 Shumway Farm

Gypsy Company

NORTH

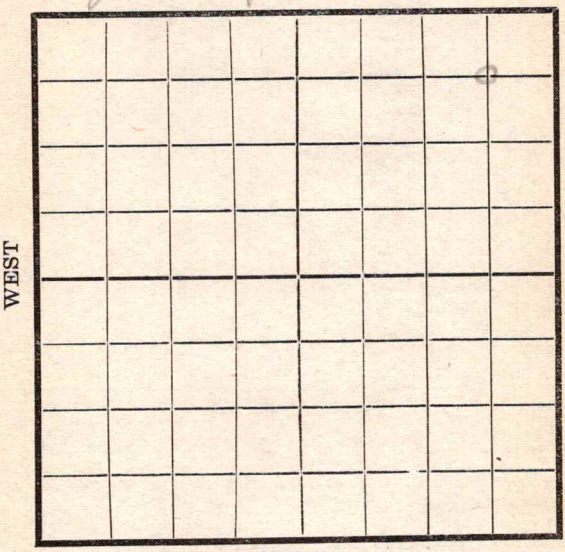

WEST

EAST

SOUTH

Location _____

Rig Up _____

Drilling and remarks

Finishing 800

RECORD

Cased_____ in._____Ft.

Sand _____

Gas _____

Oil _____

Total Depth _____

PRODUCTION

1st 24 hrs. Nat._____

1st 24 hrs. after shot_____

Gas _____ Cu. Ft.

Dry Hole _____

Abandoned _____

Date

10/27, 191 7 Coudy Scout


Form 26—1M Books of 100 Sheets Each.

Map No._____ Sec. 11 Twp. 26 R. 4

Well No. 14 Shumway Farm

Gypsy Company

NORTH

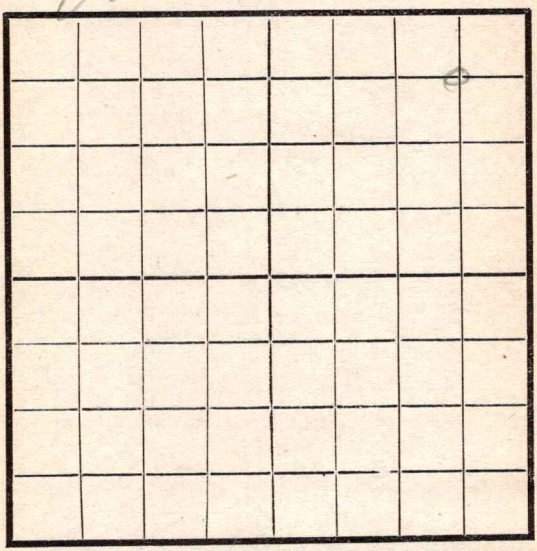

Location _____

Rig Up _____

Drilling and remarks

Fishing
800'

RECORD

Cased_____ in._____Ft.

Sand _____

Gas _____

Oil _____

Total Depth _____

PRODUCTION

1st 24 hrs. Nat._____

1st 24 hrs. after shot_____

Gas _____ Cu. Ft.

Dry Hole _____

Abandoned _____

Date

10/24, 191 7 Cardiff Scout


Form 26—1M Books of 100 Sheets Each.

Map No._____ Sec. 11 Twp. 26 R. 4

Well No. 14 Shumway Farm

Bryan Company

NORTH

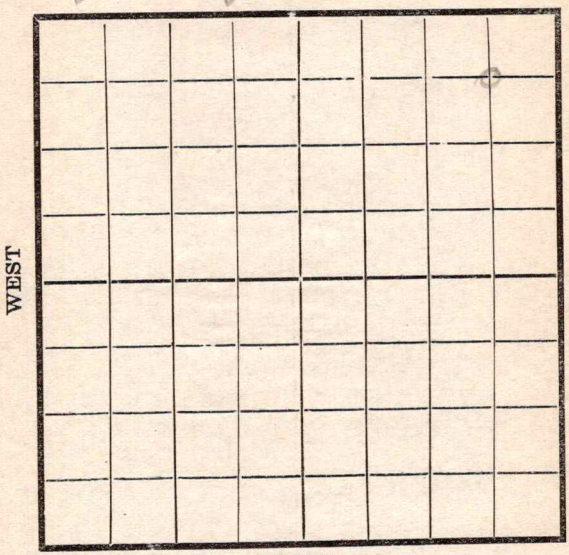

WEST

EAST

SOUTH

Location _____

Rig Up _____

Drilling and remarks

Shut Down
800

RECORD

Cased _____ in. _____ Ft.

Sand _____

Gas _____

Oil _____

Total Depth _____

PRODUCTION

1st 24 hrs. Nat. _____

1st 24 hrs. after shot _____

Gas _____ Cu. Ft.

Dry Hole _____

Abandoned _____

Date

10/31, 1917 Cardiff Scout


Form 26—1M Books of 100 Sheets Each.

Map No. _____ Sec. 11 Twp. 26 R. 4

Well No. 14 Shumway Farm

Gypsy Company

NORTH

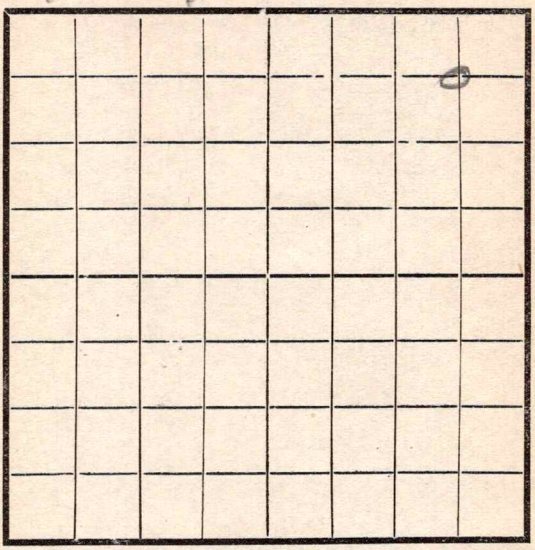

Location _____

Rig Up _____

Drilling and remarks

D 800

RECORD

Cased _____ in. _____ Ft.

Sand _____

Gas _____

Oil _____

Total Depth _____

PRODUCTION

1st 24 hrs. Nat. _____

1st 24 hrs. after shot _____

Gas _____ Cu. Ft.

Dry Hole _____

Abandoned _____

Date

11-7, 191 7 Candy Scout


Form 26—1M Books of 100 Sheets Each.

Map No. _____ Sec. 11 Twp. 26 R. 4

Well No. 4 Shumway Farm

Gypsy Company

NORTH

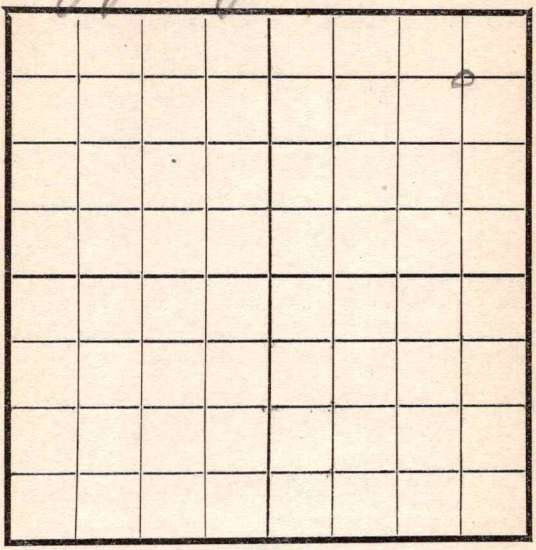

WEST

EAST

SOUTH

Location _____

Rig Up _____

Drilling and remarks

DD

800

RECORD

Cased _____ in. _____ Ft.

Sand _____

Gas _____

Oil _____

Total Depth _____

PRODUCTION

1st 24 hrs. Nat. _____

1st 24 hrs. after shot _____

Gas _____ Cu. Ft.

Dry Hole _____

Abandoned _____

Date

11/14, 191 7 Condy Scout


Form 26—1M Books of 100 Sheets Each.

Map No. _____ Sec. 11 Twp. 26 R. 4

Well No. 24 Shumway Farm

Empire Company

NORTH

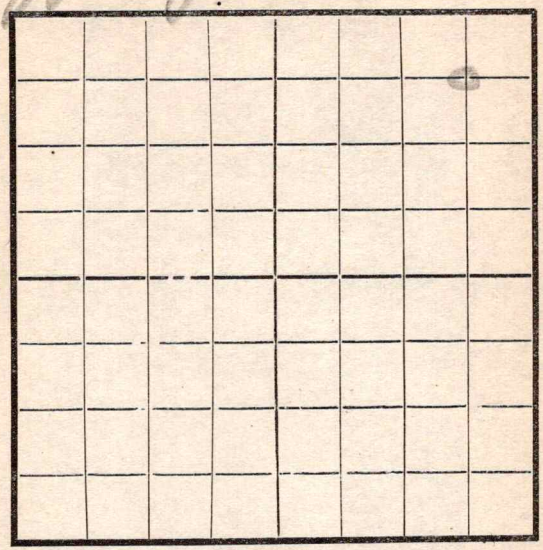

WEST

EAST

SOUTH

Location _____

Rig Up _____

Drilling and remarks

Shut Down
800'

RECORD

Cased _____ in. _____ Ft.

Sand _____

Gas _____

Oil _____

Total Depth _____

PRODUCTION

1st 24 hrs. Nat. _____

1st 24 hrs. after shot _____

Gas _____ Cu. Ft.

Dry Hole _____

Abandoned _____

Date

11/21, 191__. T Cady Scout


Form 26—1M Books of 100 Sheets Each.

Map No. _____ Sec. 11 Twp. 26 R. 4

Well No. 14 Shumway Farm

Gypsy Company

NORTH

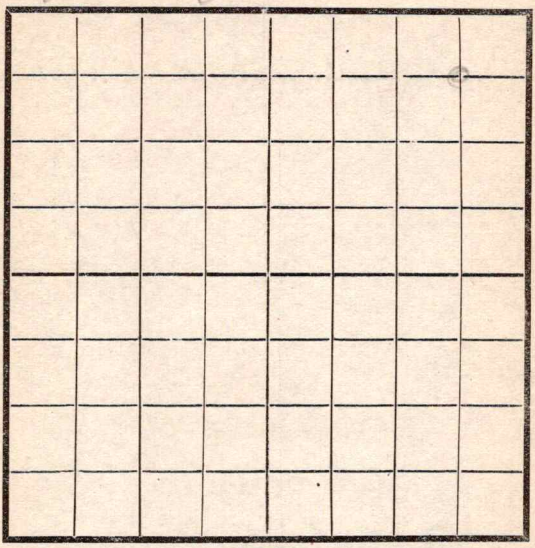

SOUTH

Location _____

Rig Up _____

Drilling and remarks

1230

RECORD

Cased _____ in. _____ Ft.

Sand _____

Gas _____

Oil _____

Total Depth _____

PRODUCTION

1st 24 hrs. Nat. _____

1st 24 hrs. after shot _____

Gas _____ Cu. Ft.

Dry Hole _____

Abandoned _____

Date

4/28, 1917. Grady Scout


Form 26—1M Books of 100 Sheets Each.

Map No. _____ Sec. 16 Twp. 26 R. 4

Well No. 14 Shumway Farm

Company

NORTH

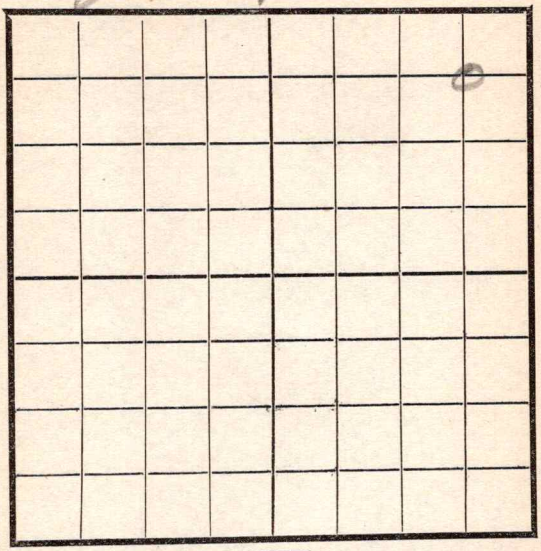

WEST

EAST

SOUTH

Location _____

Rig Up _____

Drilling and remarks

1490

RECORD

Cased _____ in. _____ Ft.

Sand _____

Gas _____

Oil _____

Total Depth _____

PRODUCTION

1st 24 hrs. Nat. _____

1st 24 hrs. after shot _____

Gas _____ Cu. Ft.

Dry Hole _____

Abandoned _____

Date

12/5, 191?. Sandy Scout


Form 26—1M Books of 100 Sheets Each.

Map No. _____ Sec. 11 Twp. 26 R. 4

Well No. 14 Shumway Farm

Gypsum Company

NORTH

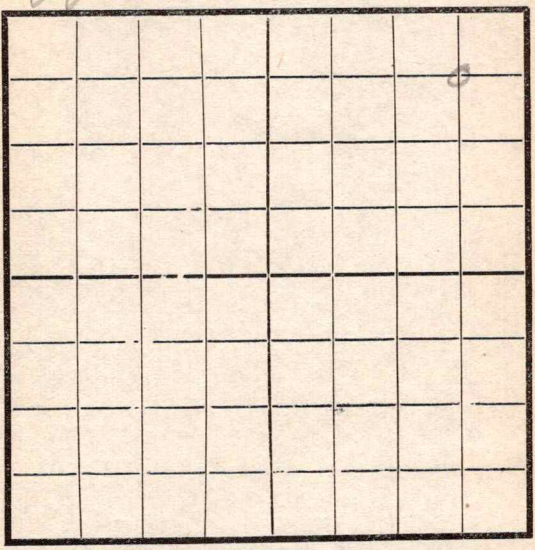

SOUTH

Location _____

Rig Up _____

Drilling and remarks

Top sand 1655

RECORD

Cased _____ in. _____ Ft.

Sand _____

Gas _____

Oil _____

Total Depth _____

PRODUCTION

1st 24 hrs. Nat. _____

1st 24 hrs. after shot _____

Gas _____ Cu. Ft.

Dry Hole _____

Abandoned _____

Date

4/2, 1918. Sandy Scout


Form 26—1M Books of 100 Sheets Each.

Map No. _____ Sec. 11 Twp. 26 R. 4

Well No. 14 Shumway Farm

Gypsy Company

NORTH

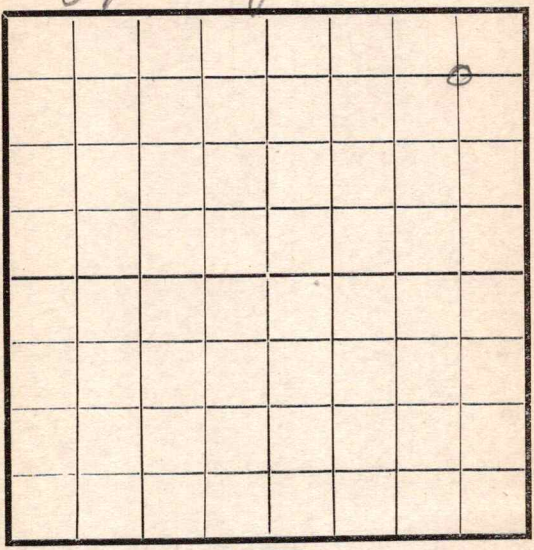

WEST

EAST

SOUTH

Location _____

Rig Up _____

Drilling and remarks

1655

RECORD

Cased _____ in. _____ Ft.

Sand _____

Gas _____

Oil _____

Total Depth _____

PRODUCTION

1st 24 hrs. Nat. _____

1st 24 hrs. after shot _____

Gas _____ Cu. Ft.

Dry Hole _____

Abandoned _____

Date

1/16, 191_. E. Condy Scout


Form 26—1M Books of 100 Sheets Each.

Map No. _____ Sec. 11 Twp. 26 R. 4

Well No. 14 Shumway Farm

Gypsy Company

NORTH

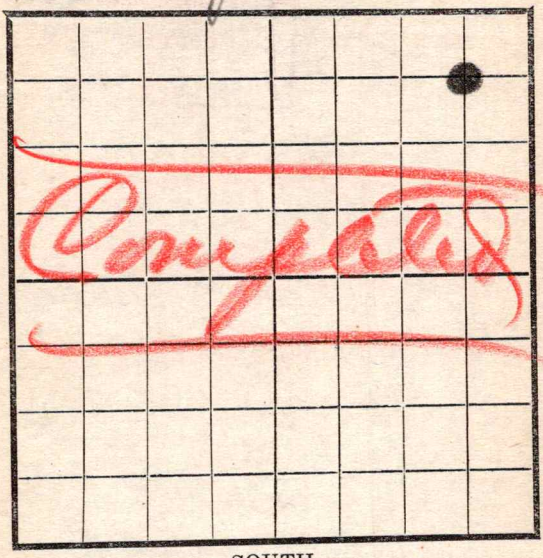

WEST EAST

SOUTH

Location _____

Rig Up _____

Drilling and remarks

Shallow well Cd at 200 Bbl

RECORD

Cased _____ in. _____ Ft.

Sand 1655 - 1689

Gas _____

Oil _____

Total Depth _____

PRODUCTION

1st 24 hrs. Nat. _____

1st 24 hrs. after shot _____

Gas _____ Cu. Ft.

Dry Hole _____

Abandoned _____

Date

1/23, 191 8. _____ Scout