


Map No. _____ Sec. 12 Twp. 26 R. 4
 Well No. 17 Denny Farm _____
Union Oil Company

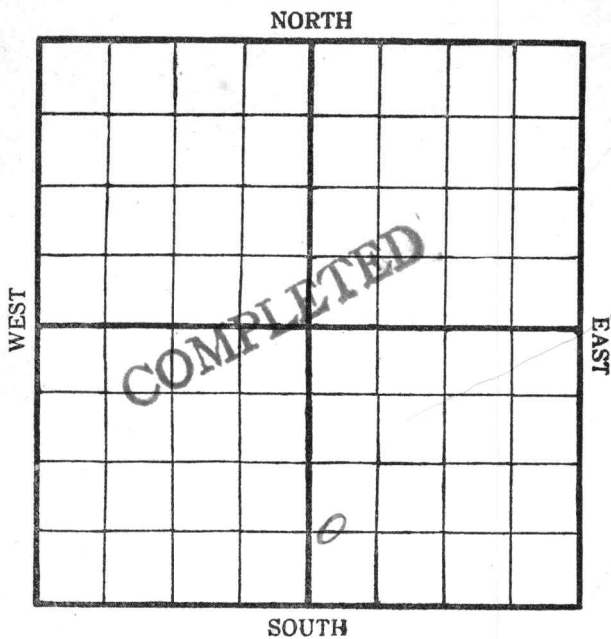

Location _____

Drilling Remarks:

Rig Up _____

Drilling Remarks:

RECORD

Cased _____ in. _____ ft.

Sand _____

Gas _____

Oil _____

Total Depth _____

PRODUCTION

1st 24 hrs. Nat. _____

1st 24 hrs. after shot _____

Gas _____ cu. ft


Dry Hole _____

Abandoned _____

Map No. _____ Sec. 12 Twp. 26 R. 4
 Well No. 17 Denny Farm _____
Union Oil Company _____

NORTH

WEST

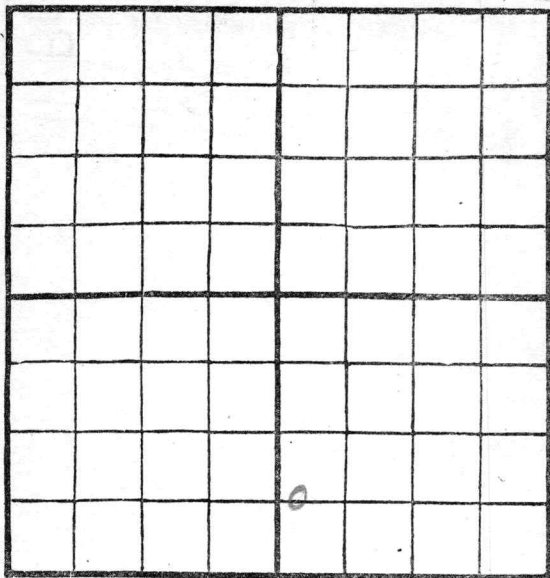

EAST

SOUTH

Location _____

Rig Up ☒ _____

Drilling and remarks _____

RECORD

Cased _____ in. _____ Ft.

Sand _____

Gas _____

Oil _____

Total Depth _____

PRODUCTION

1st 24 hrs. Nat. _____

1st 24 hrs. after shot _____

Gas _____ Cu. Ft.

Dry Hole _____

Abandoned _____

Date

1/16, 1918,Conley

Scout

First Report

Map No. _____ Sec. 12 Twp. 26 R. 4

Well No. 172 Farm _____

Union Company _____

NORTH

WEST EAST

SOUTH

Location _____

Rig up ✓ _____

Drilling and remarks:

FIRST REPORT

RECORD

Cased _____ in. _____ Ft.

Sand _____

Gas _____

Oil _____

Total Depth _____

PRODUCTION

1st 24 hrs. Nat. _____

1st 24 hrs. after shot _____

Gas _____ Cu. Ft.

Dry Hole _____

Abandoned _____

Date

4/3, 1918, S. Condy Scout


Map No. _____ Sec. 17 Twp. 26 R. 4

Well No. 172 Farm _____

Union Company

NORTH

WEST

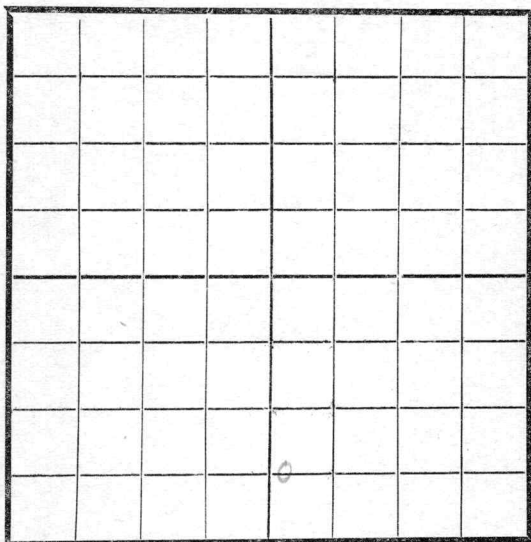

EAST

SOUTH

Location _____

Rig Up _____

Drilling and remarks

150

RECORD

Cased _____ in. _____ Ft.

Sand _____

Gas _____

Oil _____

Total Depth _____

PRODUCTION

1st 24 hrs. Nat. _____

1st 24 hrs. after shot _____

Gas _____ Cu. Ft.

Dry Hole _____

Abandoned _____


Date

4/24, 1918 C. Conley Scout

Map No. _____ Sec. 12 Twp. 26 R. 4
 Well No. 172 Farm _____
Union Company _____

NORTH

WEST

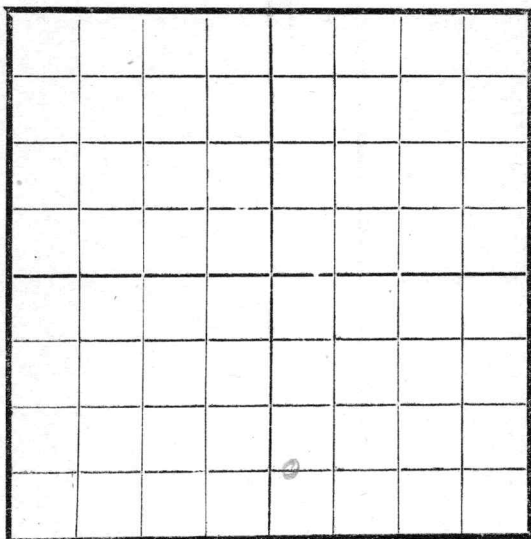

EAST

SOUTH

Location _____
 Rig Up _____
 Drilling and remarks _____

Fishing 690
Company Tools

RECORD

Cased _____ in _____ Ft.
 Sand _____
 Gas _____
 Oil _____
 Total Depth _____

PRODUCTION

1st 24 hrs. Nat. _____
 1st 24 hrs. after shot _____
 Gas _____ Cu. Ft.
 Dry Hole _____
 Abandoned _____


Date

5/1, 1918 *Scout* _____ Scout

Map No. _____ Sec. 12 Twp. 26 R. 4
Well No. 17 Denny Farm _____
Union Company _____

NORTH

WEST

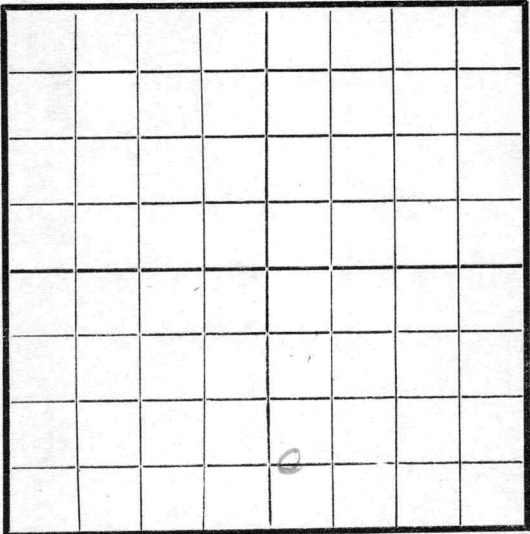

EAST

SOUTH

RECORD

Location _____
Rig Up _____
Drilling and remarks

Cased _____ in. _____ Ft.
Sand _____
Gas _____
Oil _____
Total Depth _____

PRODUCTION

1st 24 hrs. Nat. _____
1st 24 hrs. after shot _____
Gas _____ Cu. Ft.
Dry Hole _____
Abandoned _____


Date

5/8, 1918 S. Conley Scout

Map No. _____ Sec. 12 Twp. 26 R. 4
 Well No. 172 Farm _____
Union Company

NORTH

WEST

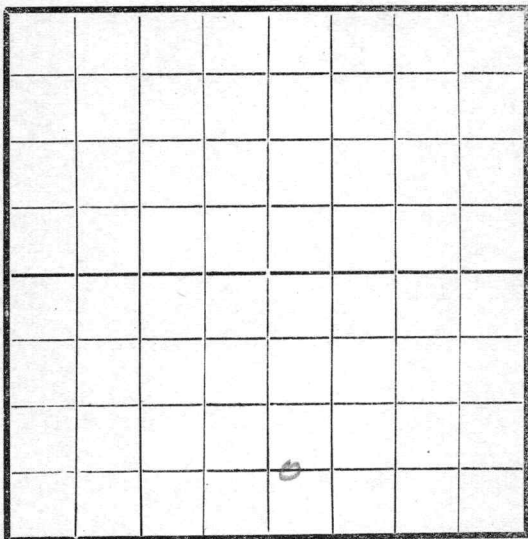

EAST

SOUTH

Location _____
 Rig Up _____
 Drilling and remarks

Isolating
690

RECORD

Cased _____ in. _____ Ft.
 Sand _____
 Gas _____
 Oil _____
 Total Depth _____

PRODUCTION

1st 24 hrs. Nat. _____
 1st 24 hrs. after shot _____
 Gas _____ Cu. Ft.
 Dry Hole _____
 Abandoned _____

Date

5/15, 1918 E. C. Caudrey Scout

Form 26—1M Books of 100 Sheets Each.


Map No. _____ Sec. 12 Twp. 26 R. 4

Well No. 17 Denny Farm _____

_____ Company

NORTH

WEST

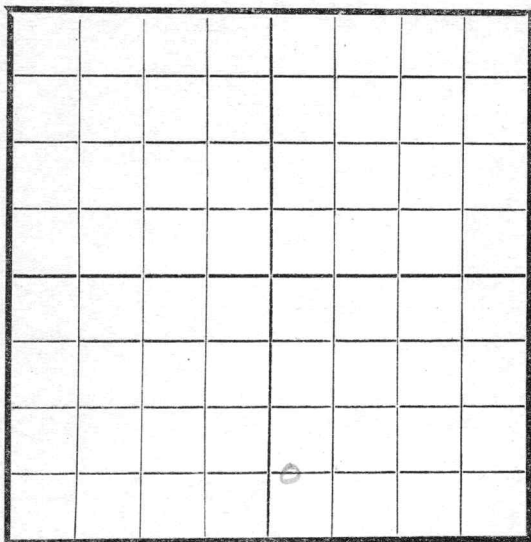

EAST

SOUTH

Location _____

Rig Up _____

Drilling and remarks

12690

RECORD

Cased _____ in. _____ Ft.

Sand _____

Gas _____

Oil _____

Total Depth _____

PRODUCTION

1st 24 hrs. Nat. _____

1st 24 hrs. after shot _____

Gas _____ Cu. Ft.

Dry Hole _____

Abandoned _____

Date

5/22/191


Scout

Map No. _____ Sec. 12 Twp. 26 R. 4

Well No. 128enny Farm _____
Union Company

NORTH

WEST

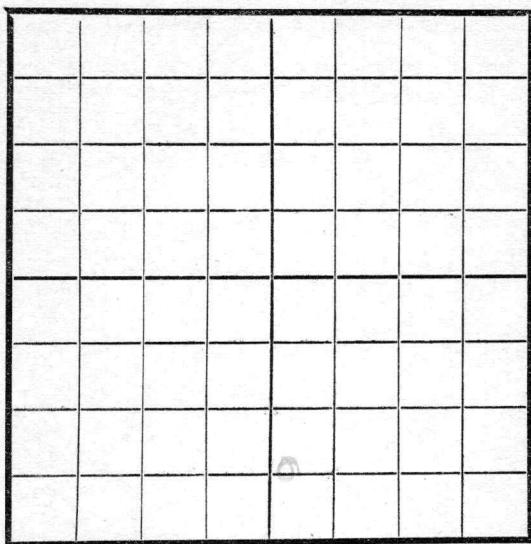

EAST

SOUTH

Location _____

Rig Up _____

Drilling and remarks

1360

RECORD

Cased _____ in. _____ Ft.

Sand _____

Gas _____

Oil _____

Total Depth _____

PRODUCTION

1st 24 hrs. Nat. _____

1st 24 hrs. after shot _____

Gas _____ Cu. Ft.

Dry Hole _____

Abandoned _____


Date

5/29, 1911 S. C. Cady Scout

Map No. _____ Sec. 12 Twp. 26 R. 4
 Well No. 172 Farm _____
Union Company _____

NORTH

WEST

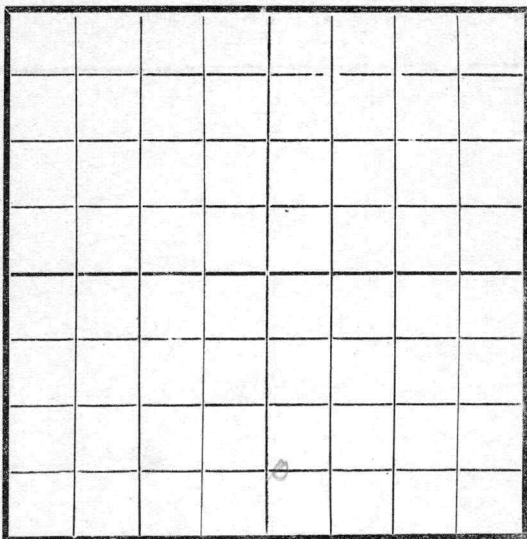

EAST

SOUTH

Location _____
 Rig Up _____
 Drilling and remarks

1530

RECORD

Cased _____ in. _____ Ft.
 Sand _____
 Gas _____
 Oil _____
 Total Depth _____

PRODUCTION

1st 24 hrs. Nat. _____
 1st 24 hrs. after shot _____
 Gas _____ Cu. Ft.
 Dry Hole _____
 Abandoned _____

Date


6/5, 191 8 Conley Scout

Map No. _____ Sec. 12 Twp. 26 R. 4

Well No. 172

Union Company

Contractor _____

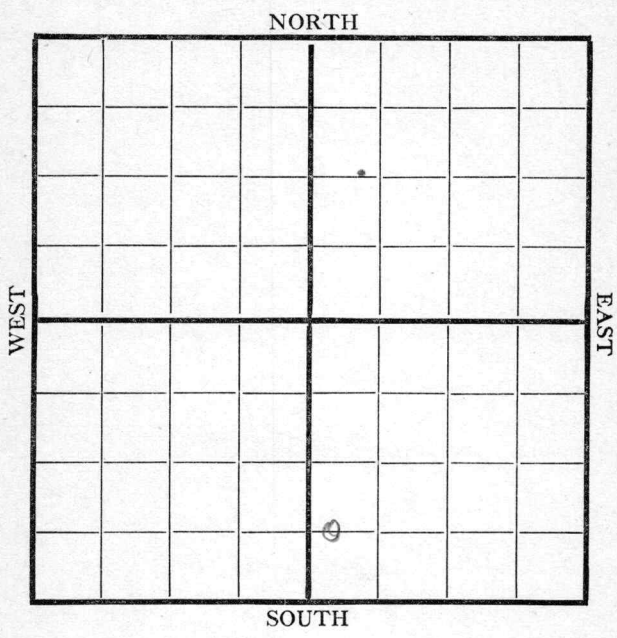

Location _____

Rig up _____

Drilling and Remarks:

1750

RECORD

Cased _____ in., _____ ft.

Sand _____

Gas _____

Oil _____

Total Depth _____

PRODUCTION

1st 24 hrs. Nat. _____

1st 24 hrs. after shot _____

Gas _____ Cu. Ft.

Dry Hole _____

Abandoned _____


Date

6/12 1918 S. Cordell Scout

Map No. _____ Sec. 12 Twp. 26 R. 4
 Well No. 17 Denny Farm _____
Union Company _____

NORTH

WEST

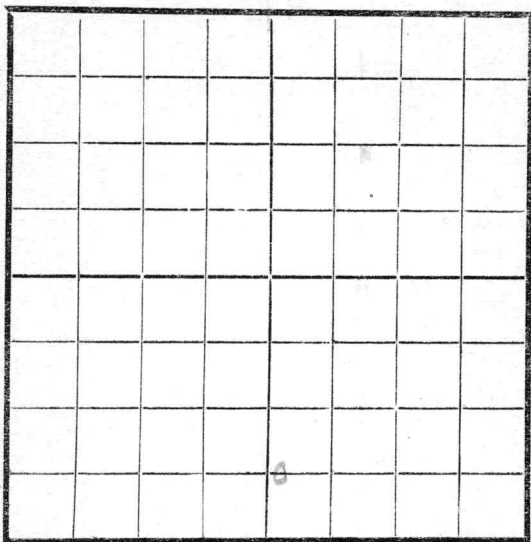

EAST

SOUTH

Location _____
 Rig Up _____
 Drilling and remarks _____

2040

RECORD

Cased _____ in. _____ Ft.
 Sand _____
 Gas _____
 Oil _____
 Total Depth _____

PRODUCTION

1st 24 hrs. Nat. _____
 1st 24 hrs. after shot _____
 Gas _____ Cu. Ft.
 Dry Hole _____
 Abandoned _____

Date


6/19, 1918 Candy Scout

Map No. _____ Sec. 12 Twp. 26 R. 4

Well No. 172

Union Oil Company

Contractor _____

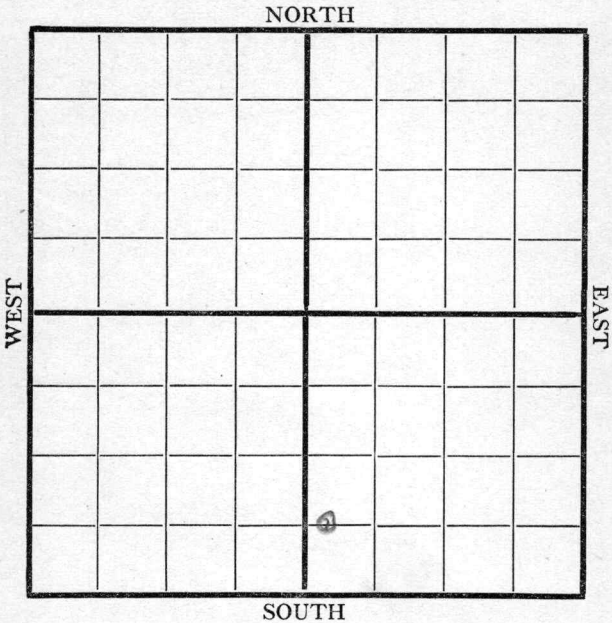

Location _____

Rig up _____

Drilling and Remarks:

2300

RECORD

Cased _____ in., _____ ft.

Sand _____

Gas _____

Oil _____

Total Depth _____

PRODUCTION

1st 24 hrs. Nat. _____

1st 24 hrs. after shot _____

Gas _____ Cu. Ft.

Dry Hole _____

Abandoned _____

Date


6/26 1918 Candiff Scout

Map No. K14 Sec. 12 Twp. 26 R. 4Well No. 7 DemocracyUnion CompanyCompany Drilling Contractor

NORTH

WEST

EAST

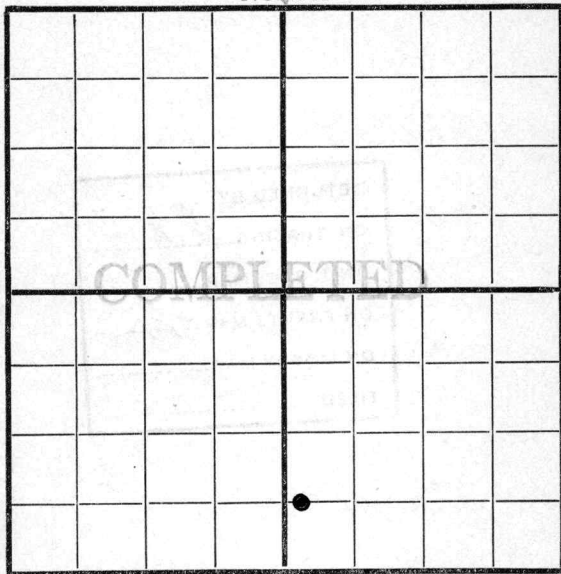

SOUTH

RECORD

Location _____

Cased _____ in., _____ ft.

Rig up _____

Sand 2436-2473

Drilling and Remarks:

Gas _____

Oil _____

Total Depth _____

PRODUCTION

1st 24 hrs. Nat. _____

1st 24 hrs. after shot _____

Gas _____ Cu. Ft.

Dry Hole _____

Abandoned _____

Date

7/3 191 P. Conley Scout